


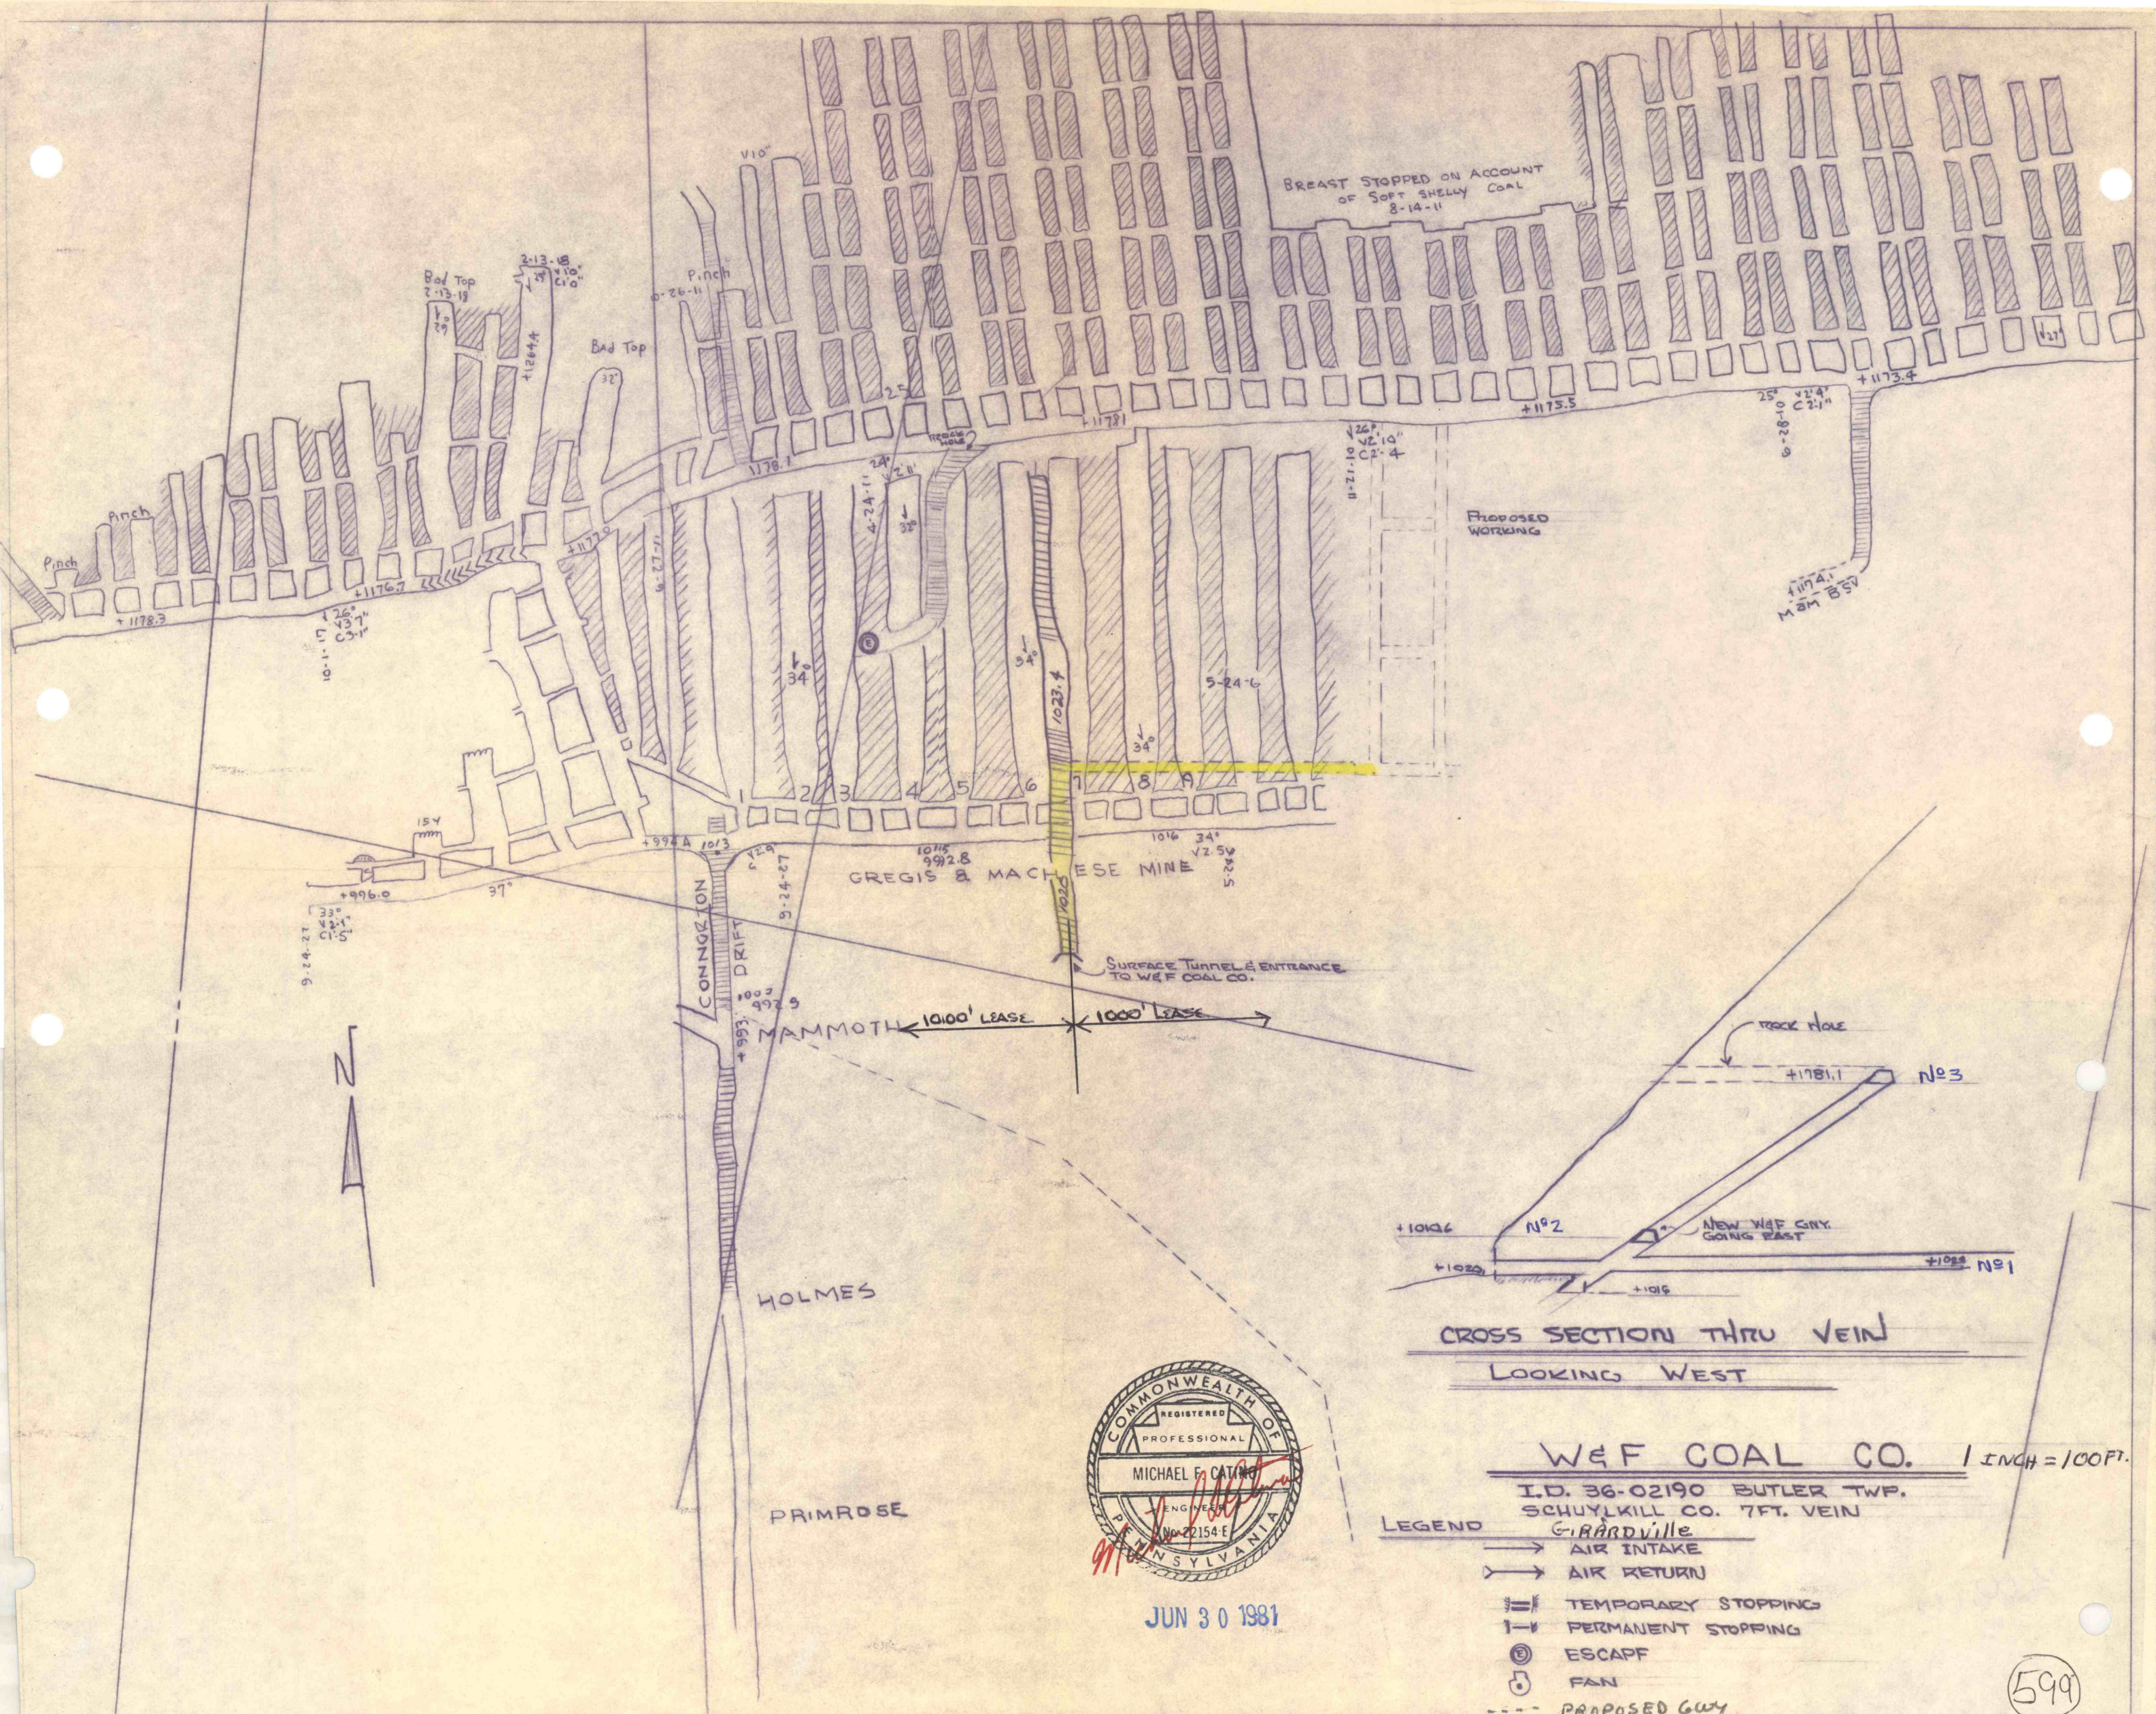

BREAST STOPPED ON ACCOUNT
OF SOFT SHELLY COAL
8-14-11


GREGIS & MACH ESE MINE

CONNOXION
DRIFT

MAMMOTH 1000' LEASE 1000' LEASE

HOLMES

PRIMROSE

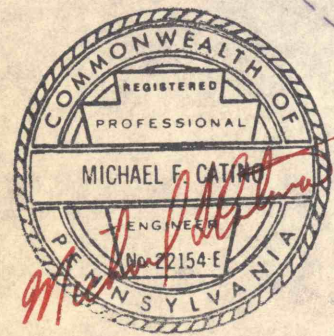

JUN 30 1981

CROSS SECTION THRU VEIN
LOOKING WEST

W&F COAL CO. 1 INCH = 100 FT.
I.D. 36-02190 BUTLER TWP.
SCHUYLKILL CO. 7 FT. VEIN
GIRARDVILLE
LEGEND
→ AIR INTAKE
⇐ AIR RETURN
= TEMPORARY STOPPING
- PERMANENT STOPPING
⊙ ESCAPE
⊙ FAN
--- PROPOSED GUY

599