


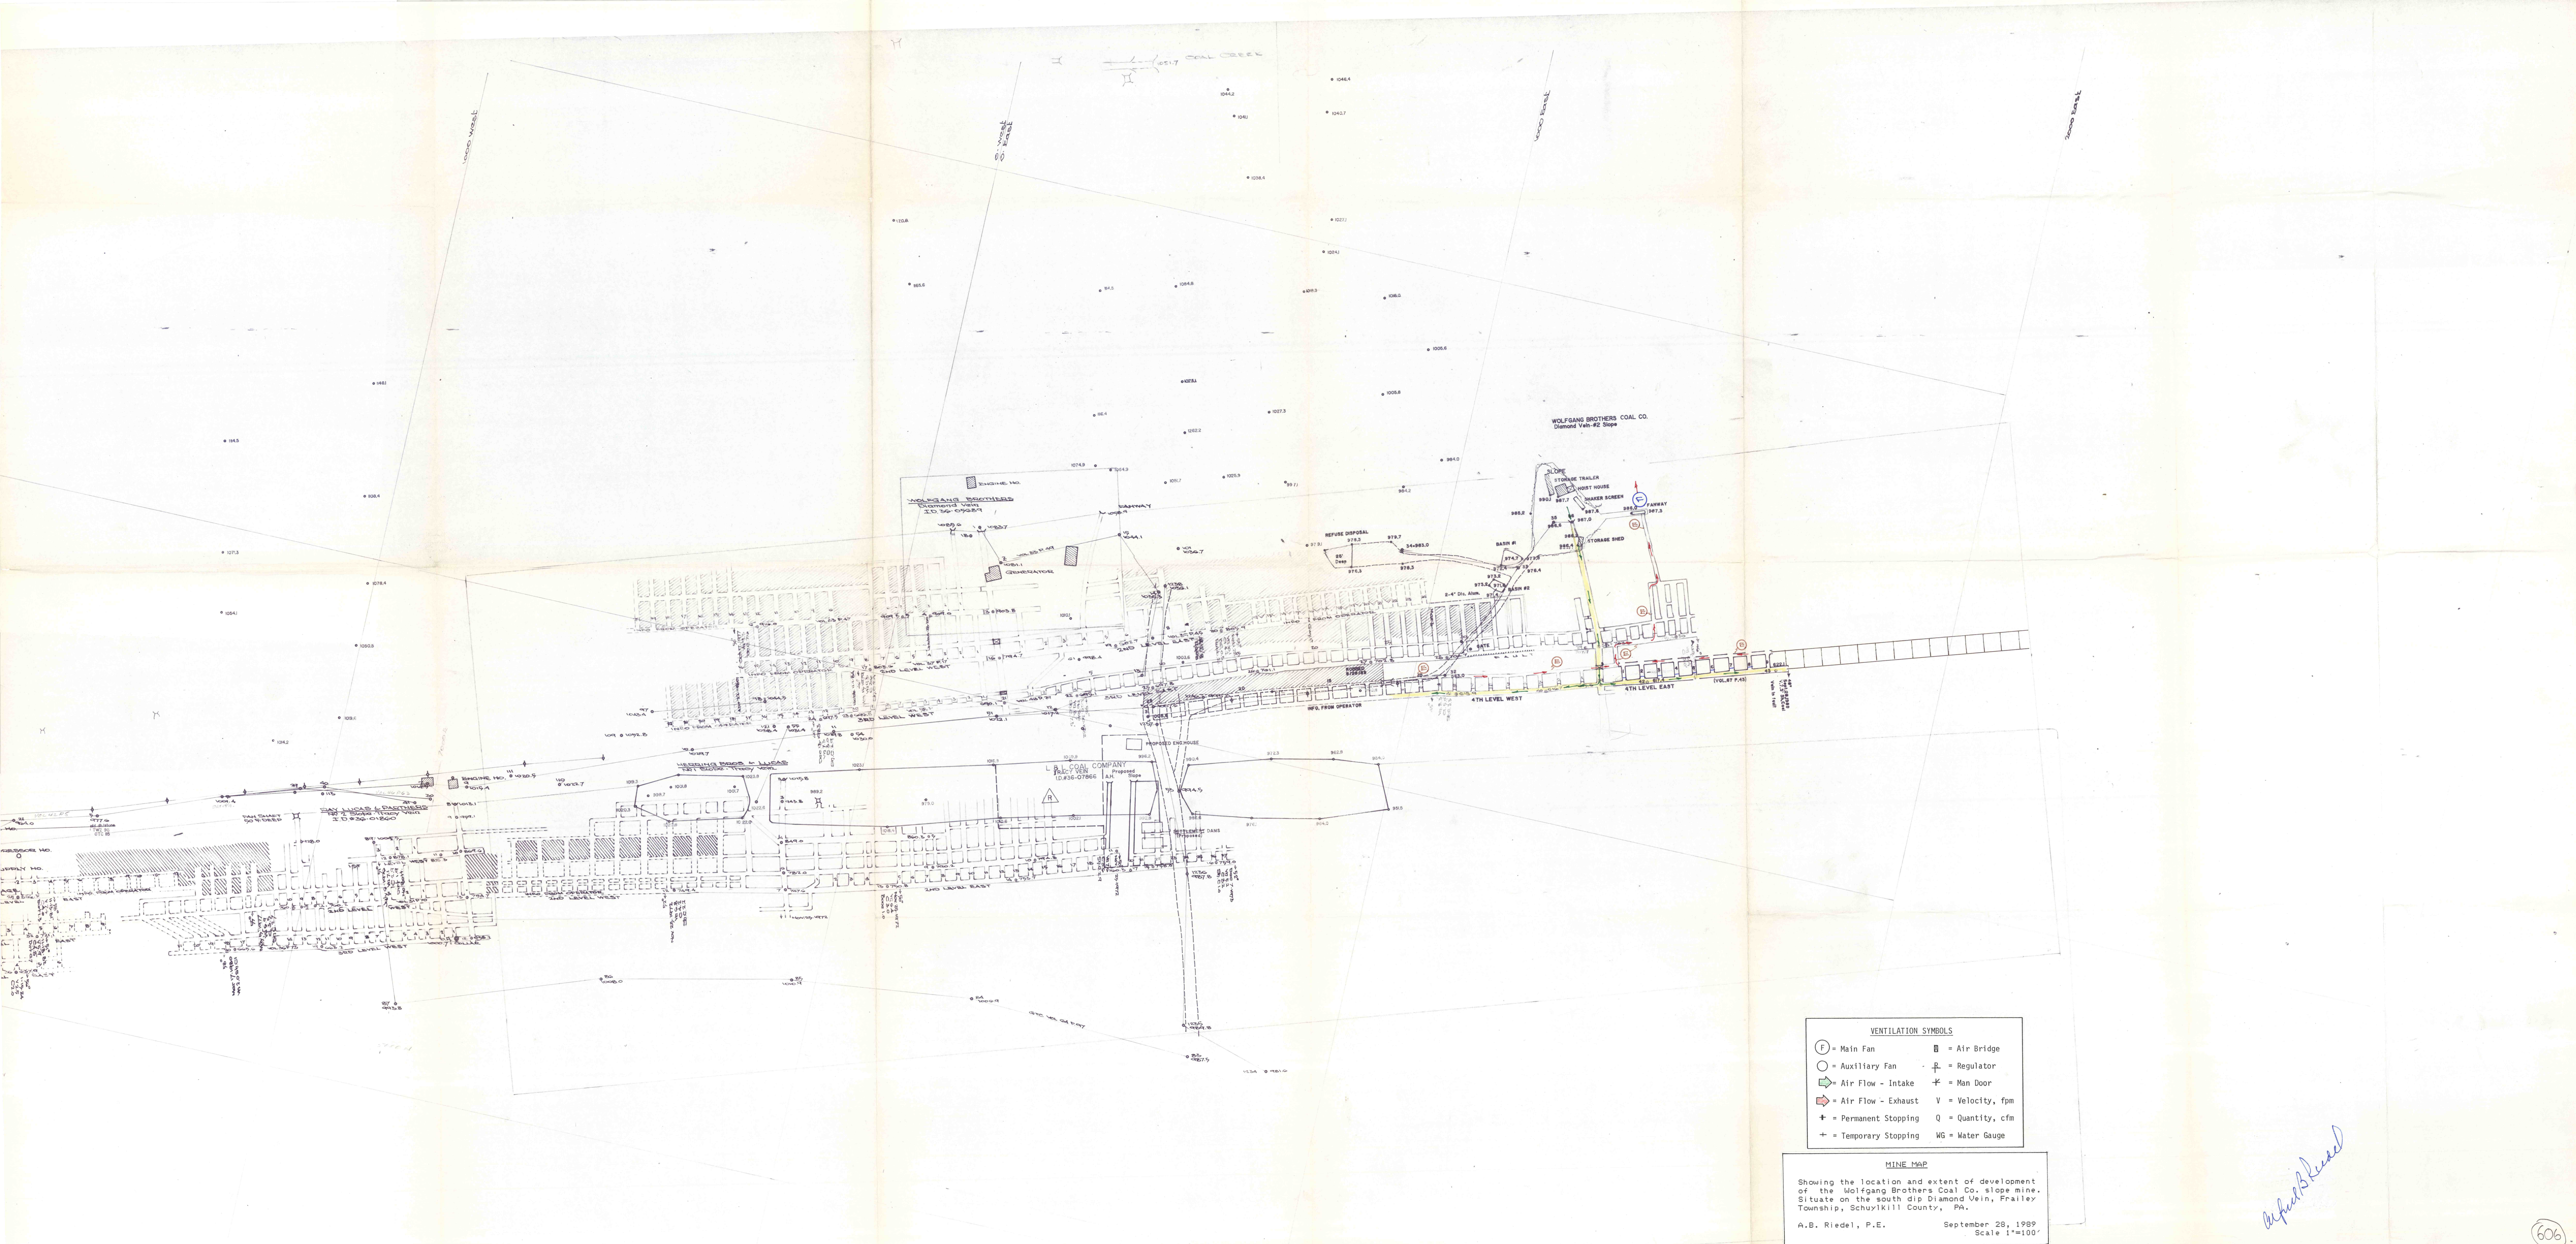

VENTILATION SYMBOLS	
(F) = Main Fan	▣ = Air Bridge
(A) = Auxiliary Fan	⊥ = Regulator
→ = Air Flow - Intake	⋈ = Man Door
⇨ = Air Flow - Exhaust	V = Velocity, fpm
⊕ = Permanent Stopping	Q = Quantity, cfm
⊕ = Temporary Stopping	WG = Water Gauge

MINE MAP
Showing the location and extent of development of the Wolfgang Brothers Coal Co. slope mine. Situate on the south dip Diamond Vein, Frailey Township, Schuylkill County, PA.
A.B. Riedel, P.E. September 28, 1989
Scale 1"=100'

april 8, 1990