


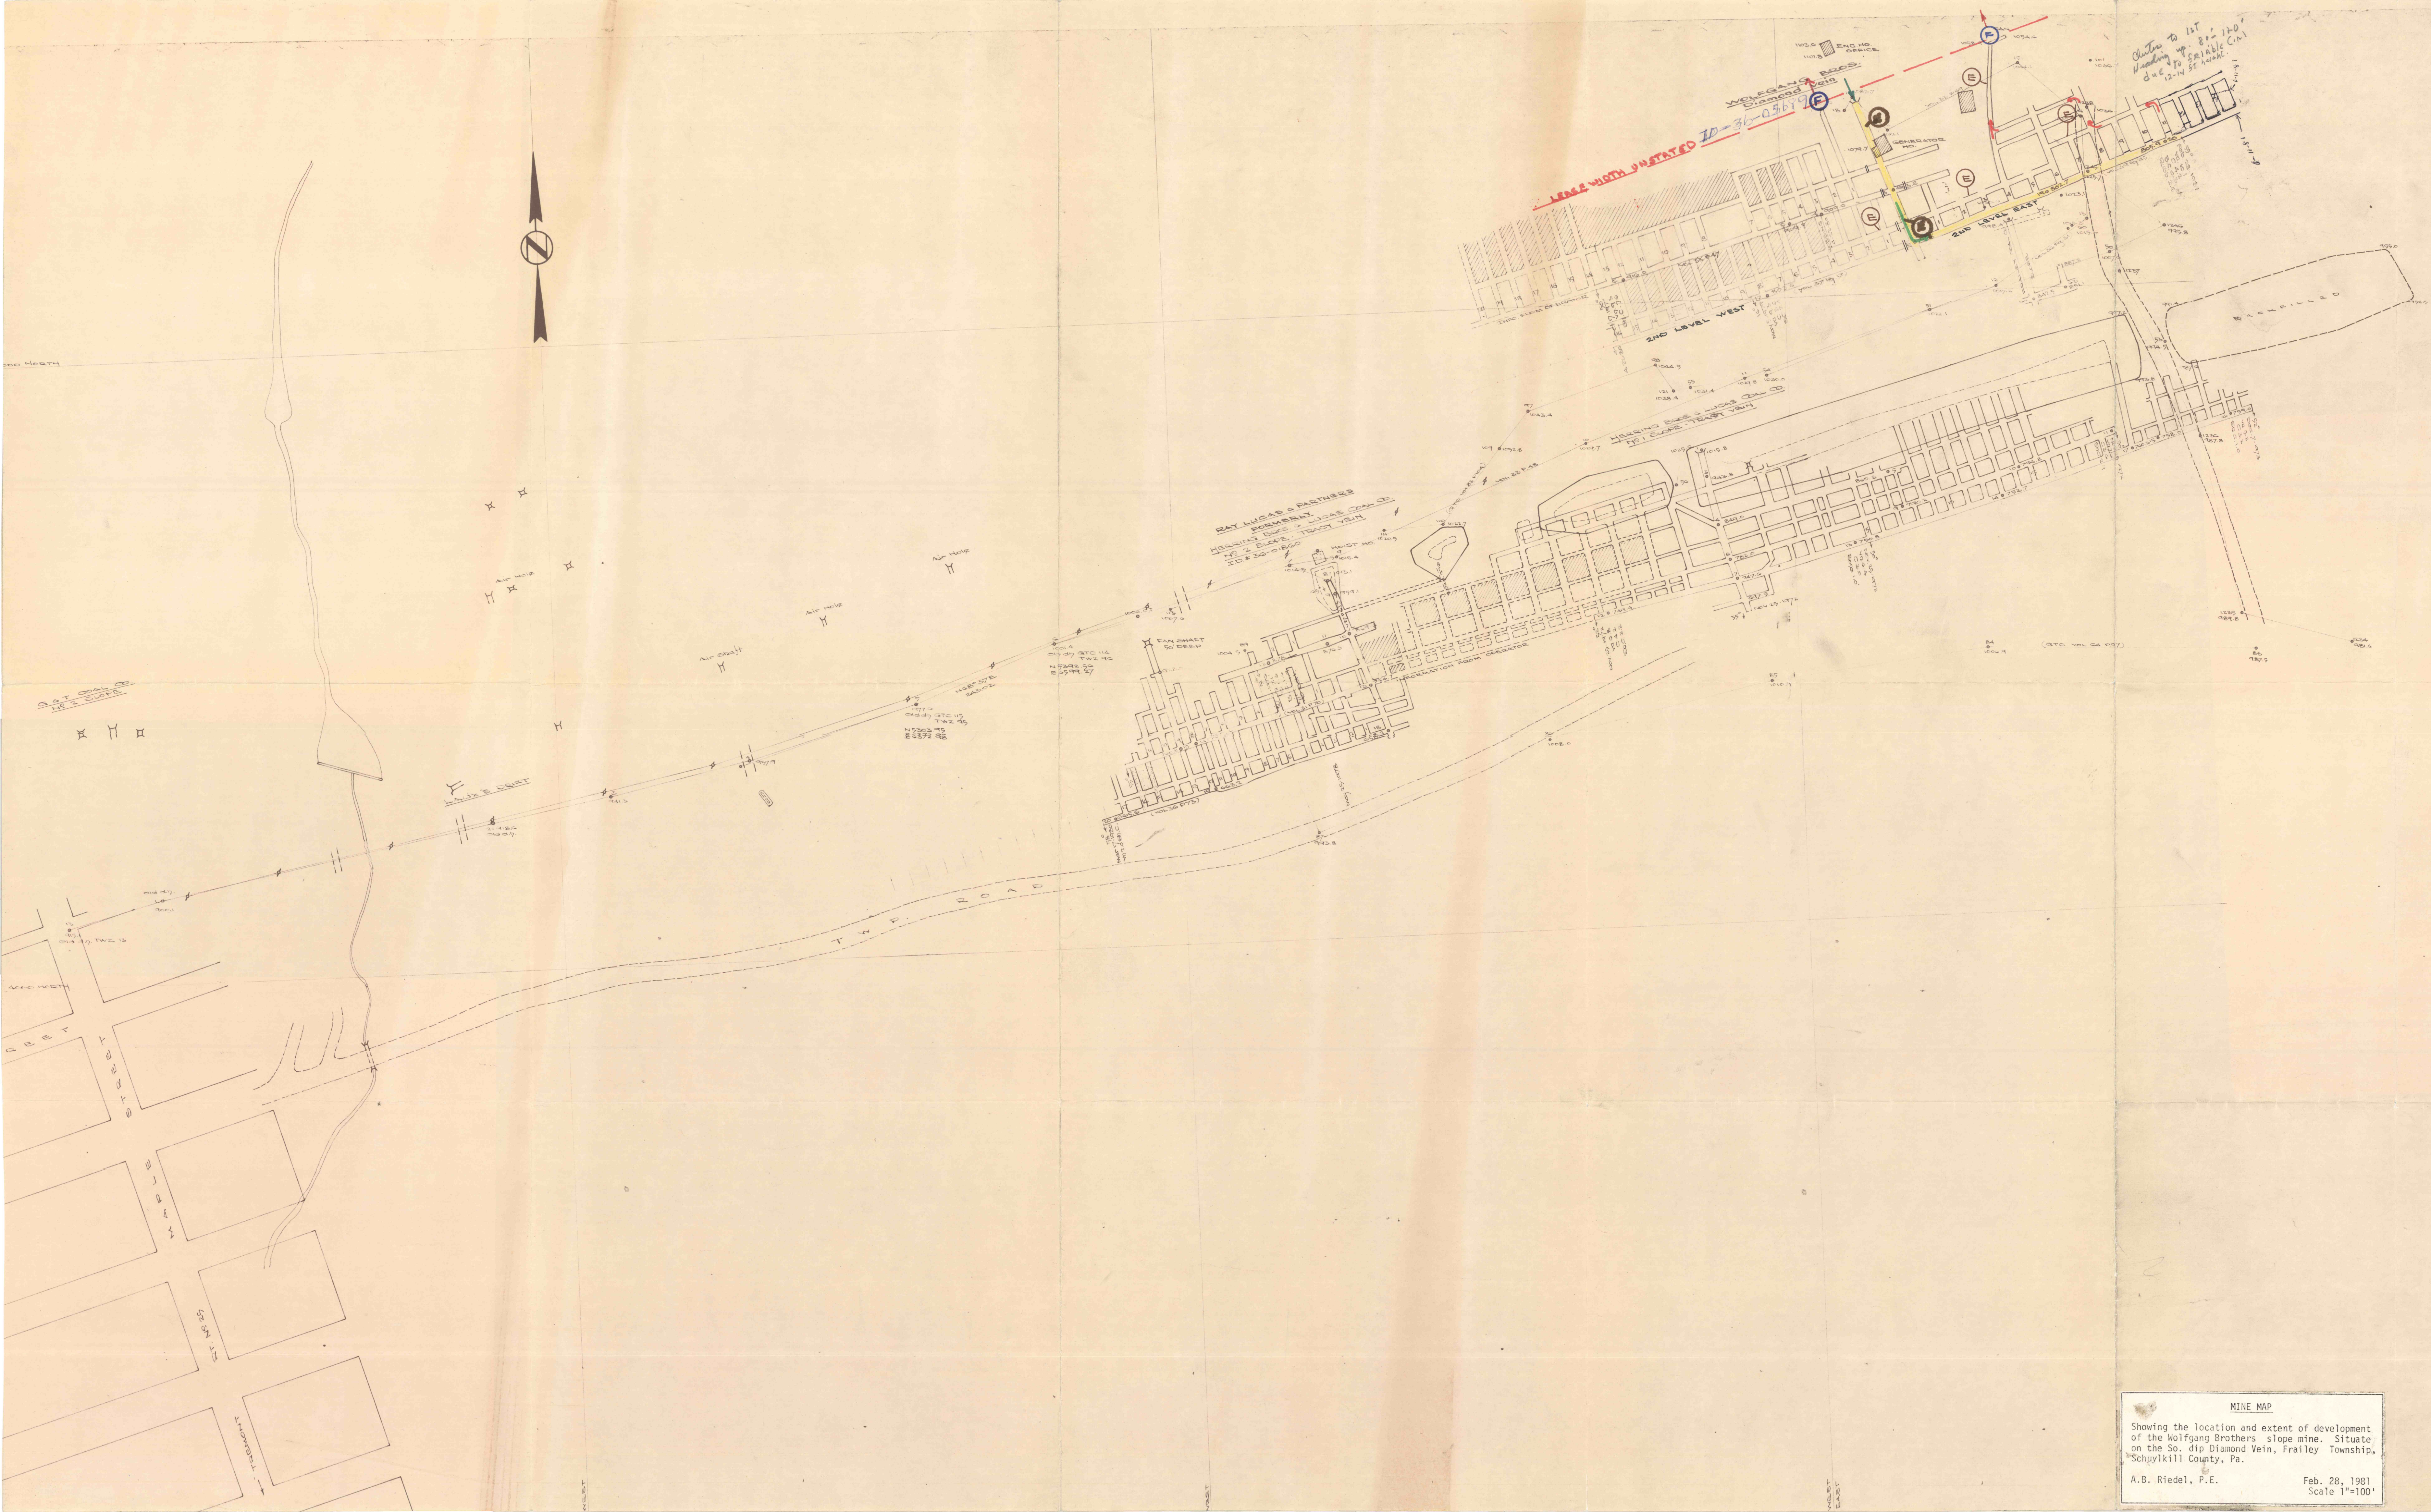

MINE MAP
Showing the location and extent of development
of the Wolfgang Brothers slope mine. Situate
on the So. dip Diamond Vein, Frailey Township,
Schuylkill County, Pa.
A.B. Riedel, P.E. Feb. 28, 1981
Scale 1"=100'

A.B. Riedel