

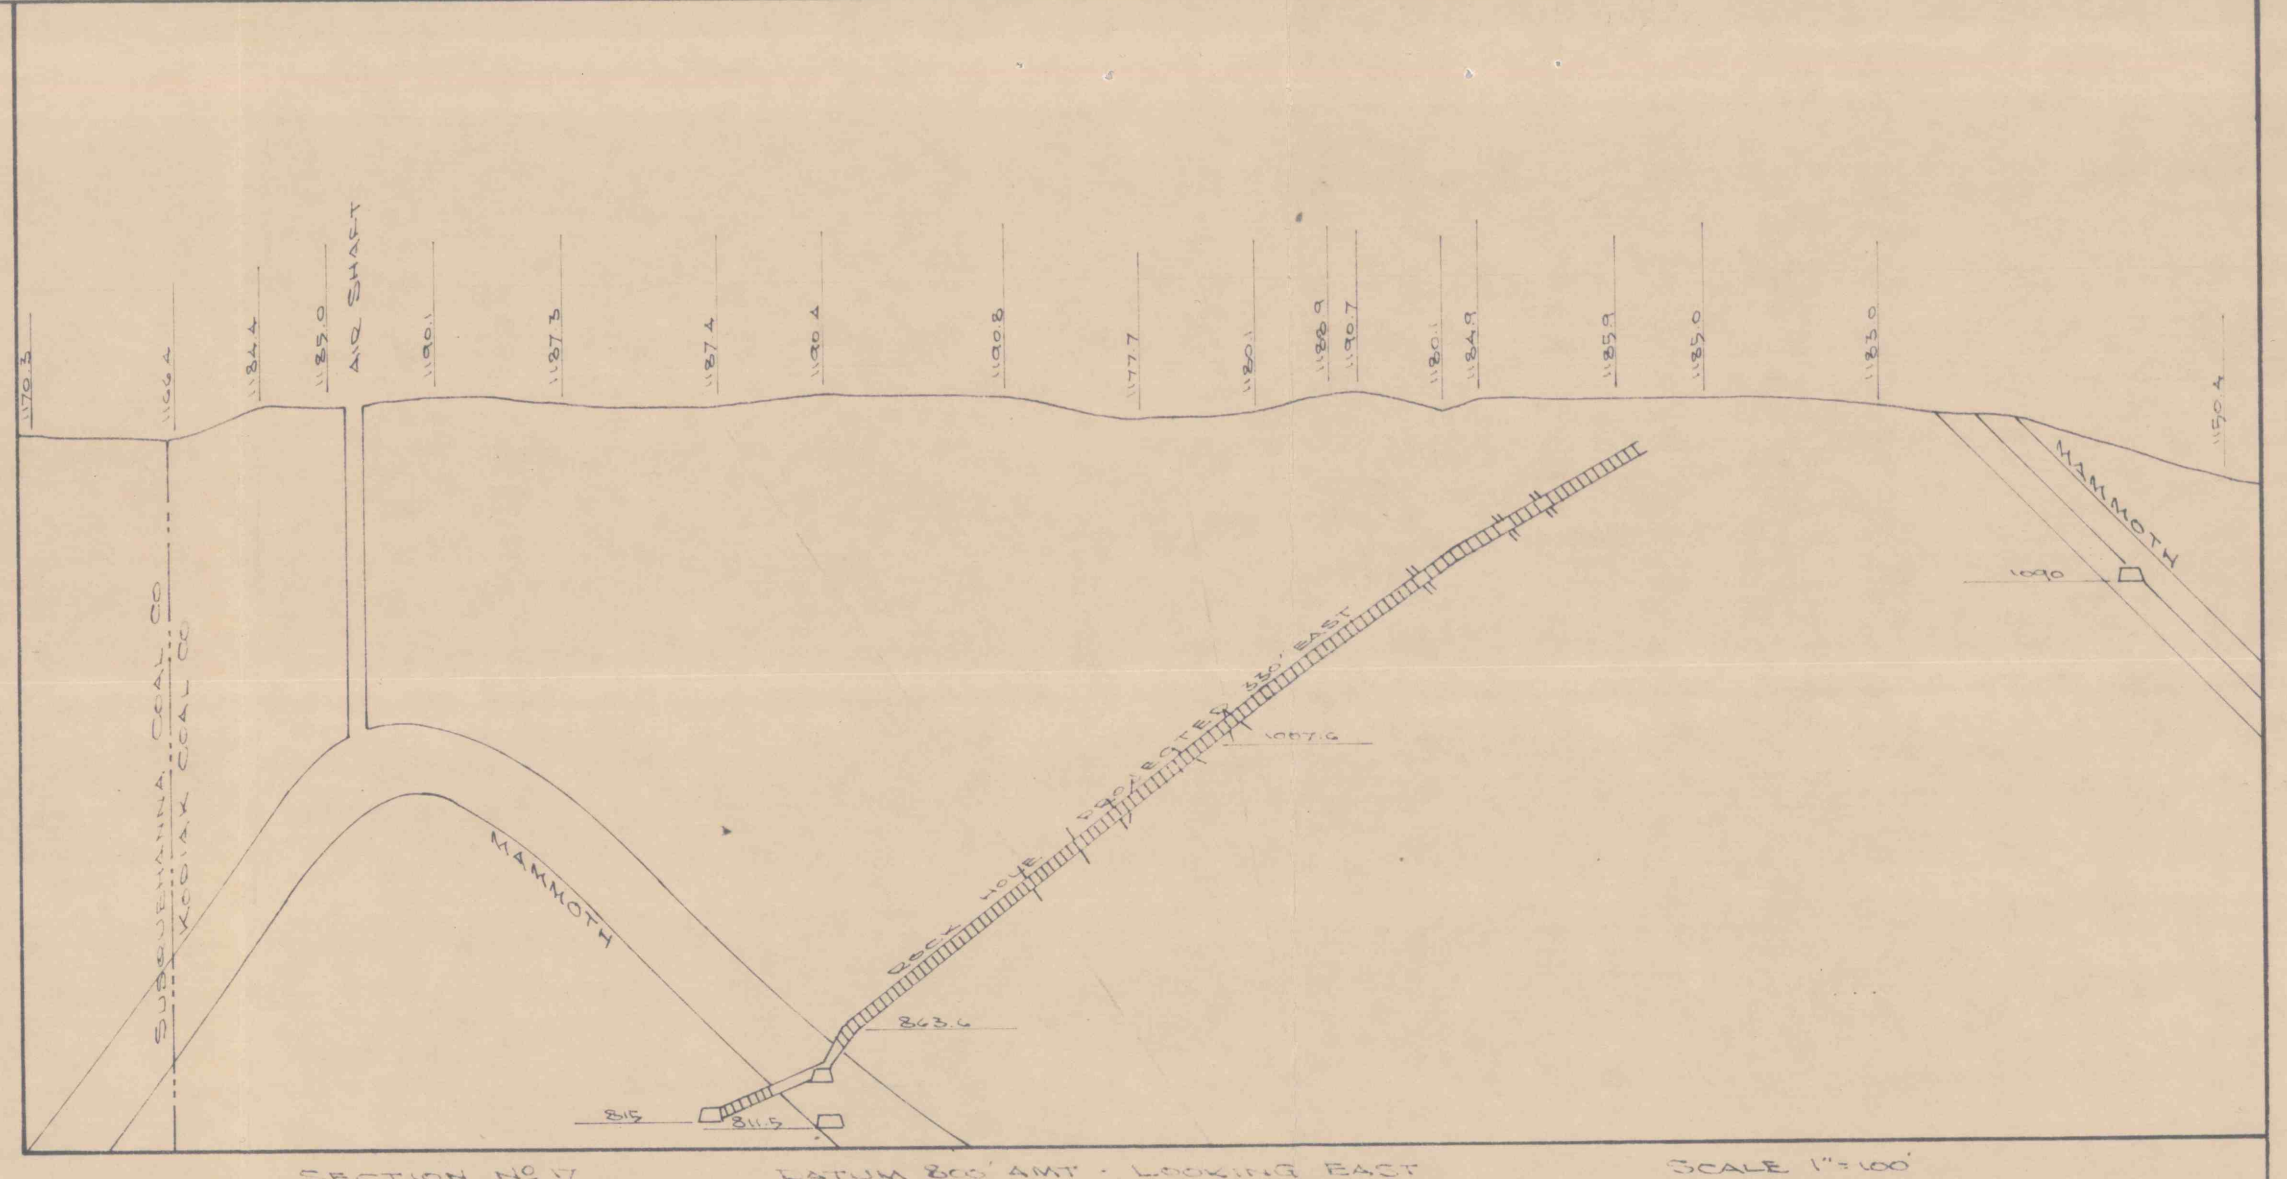


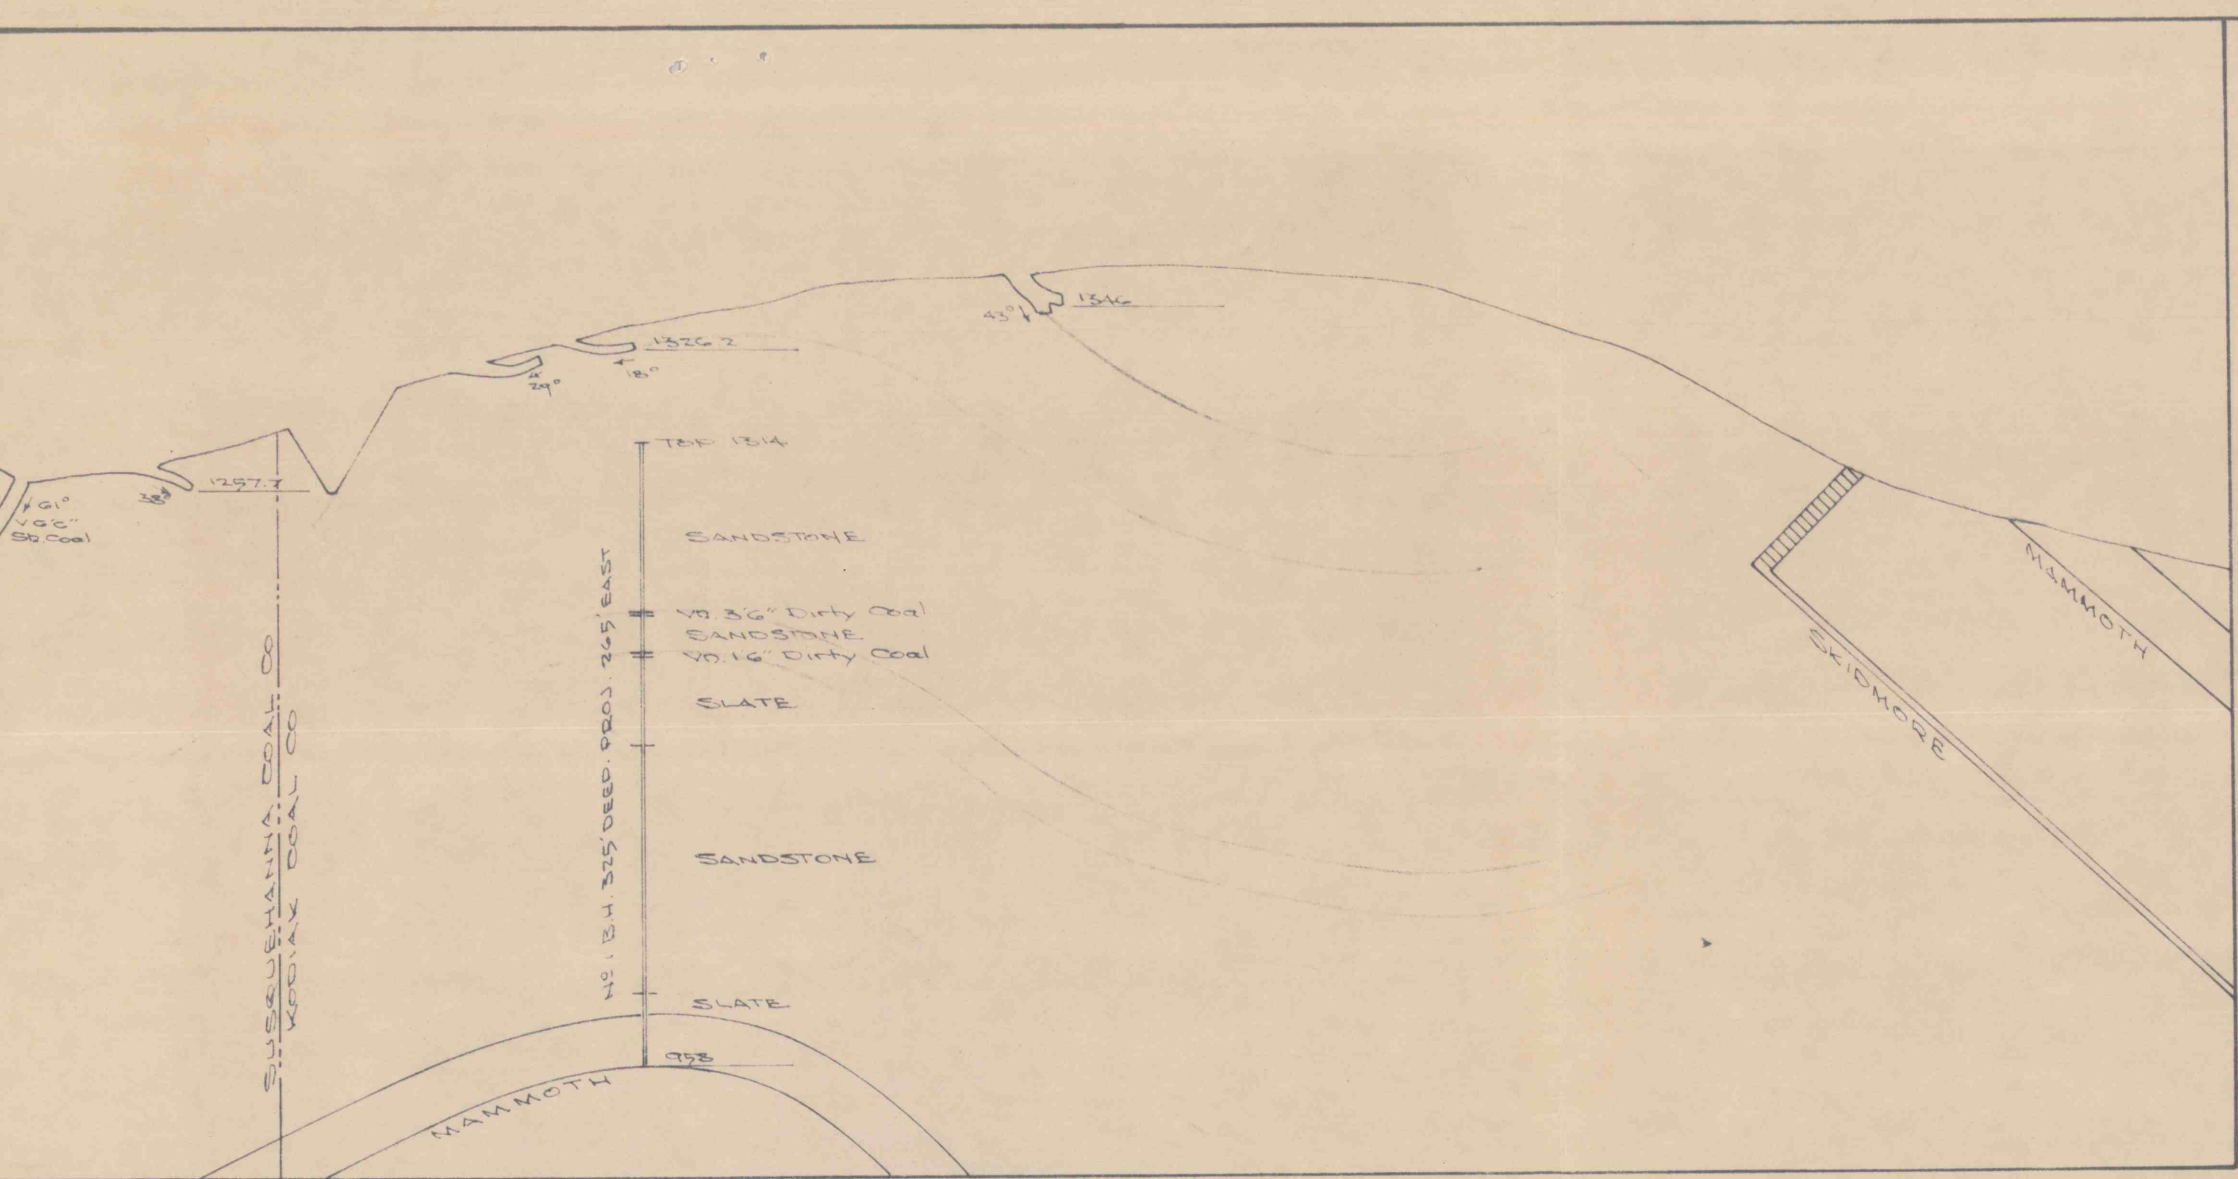

S U S Q U E H A N N A C O A L C O

K O D I A K C O A L C O

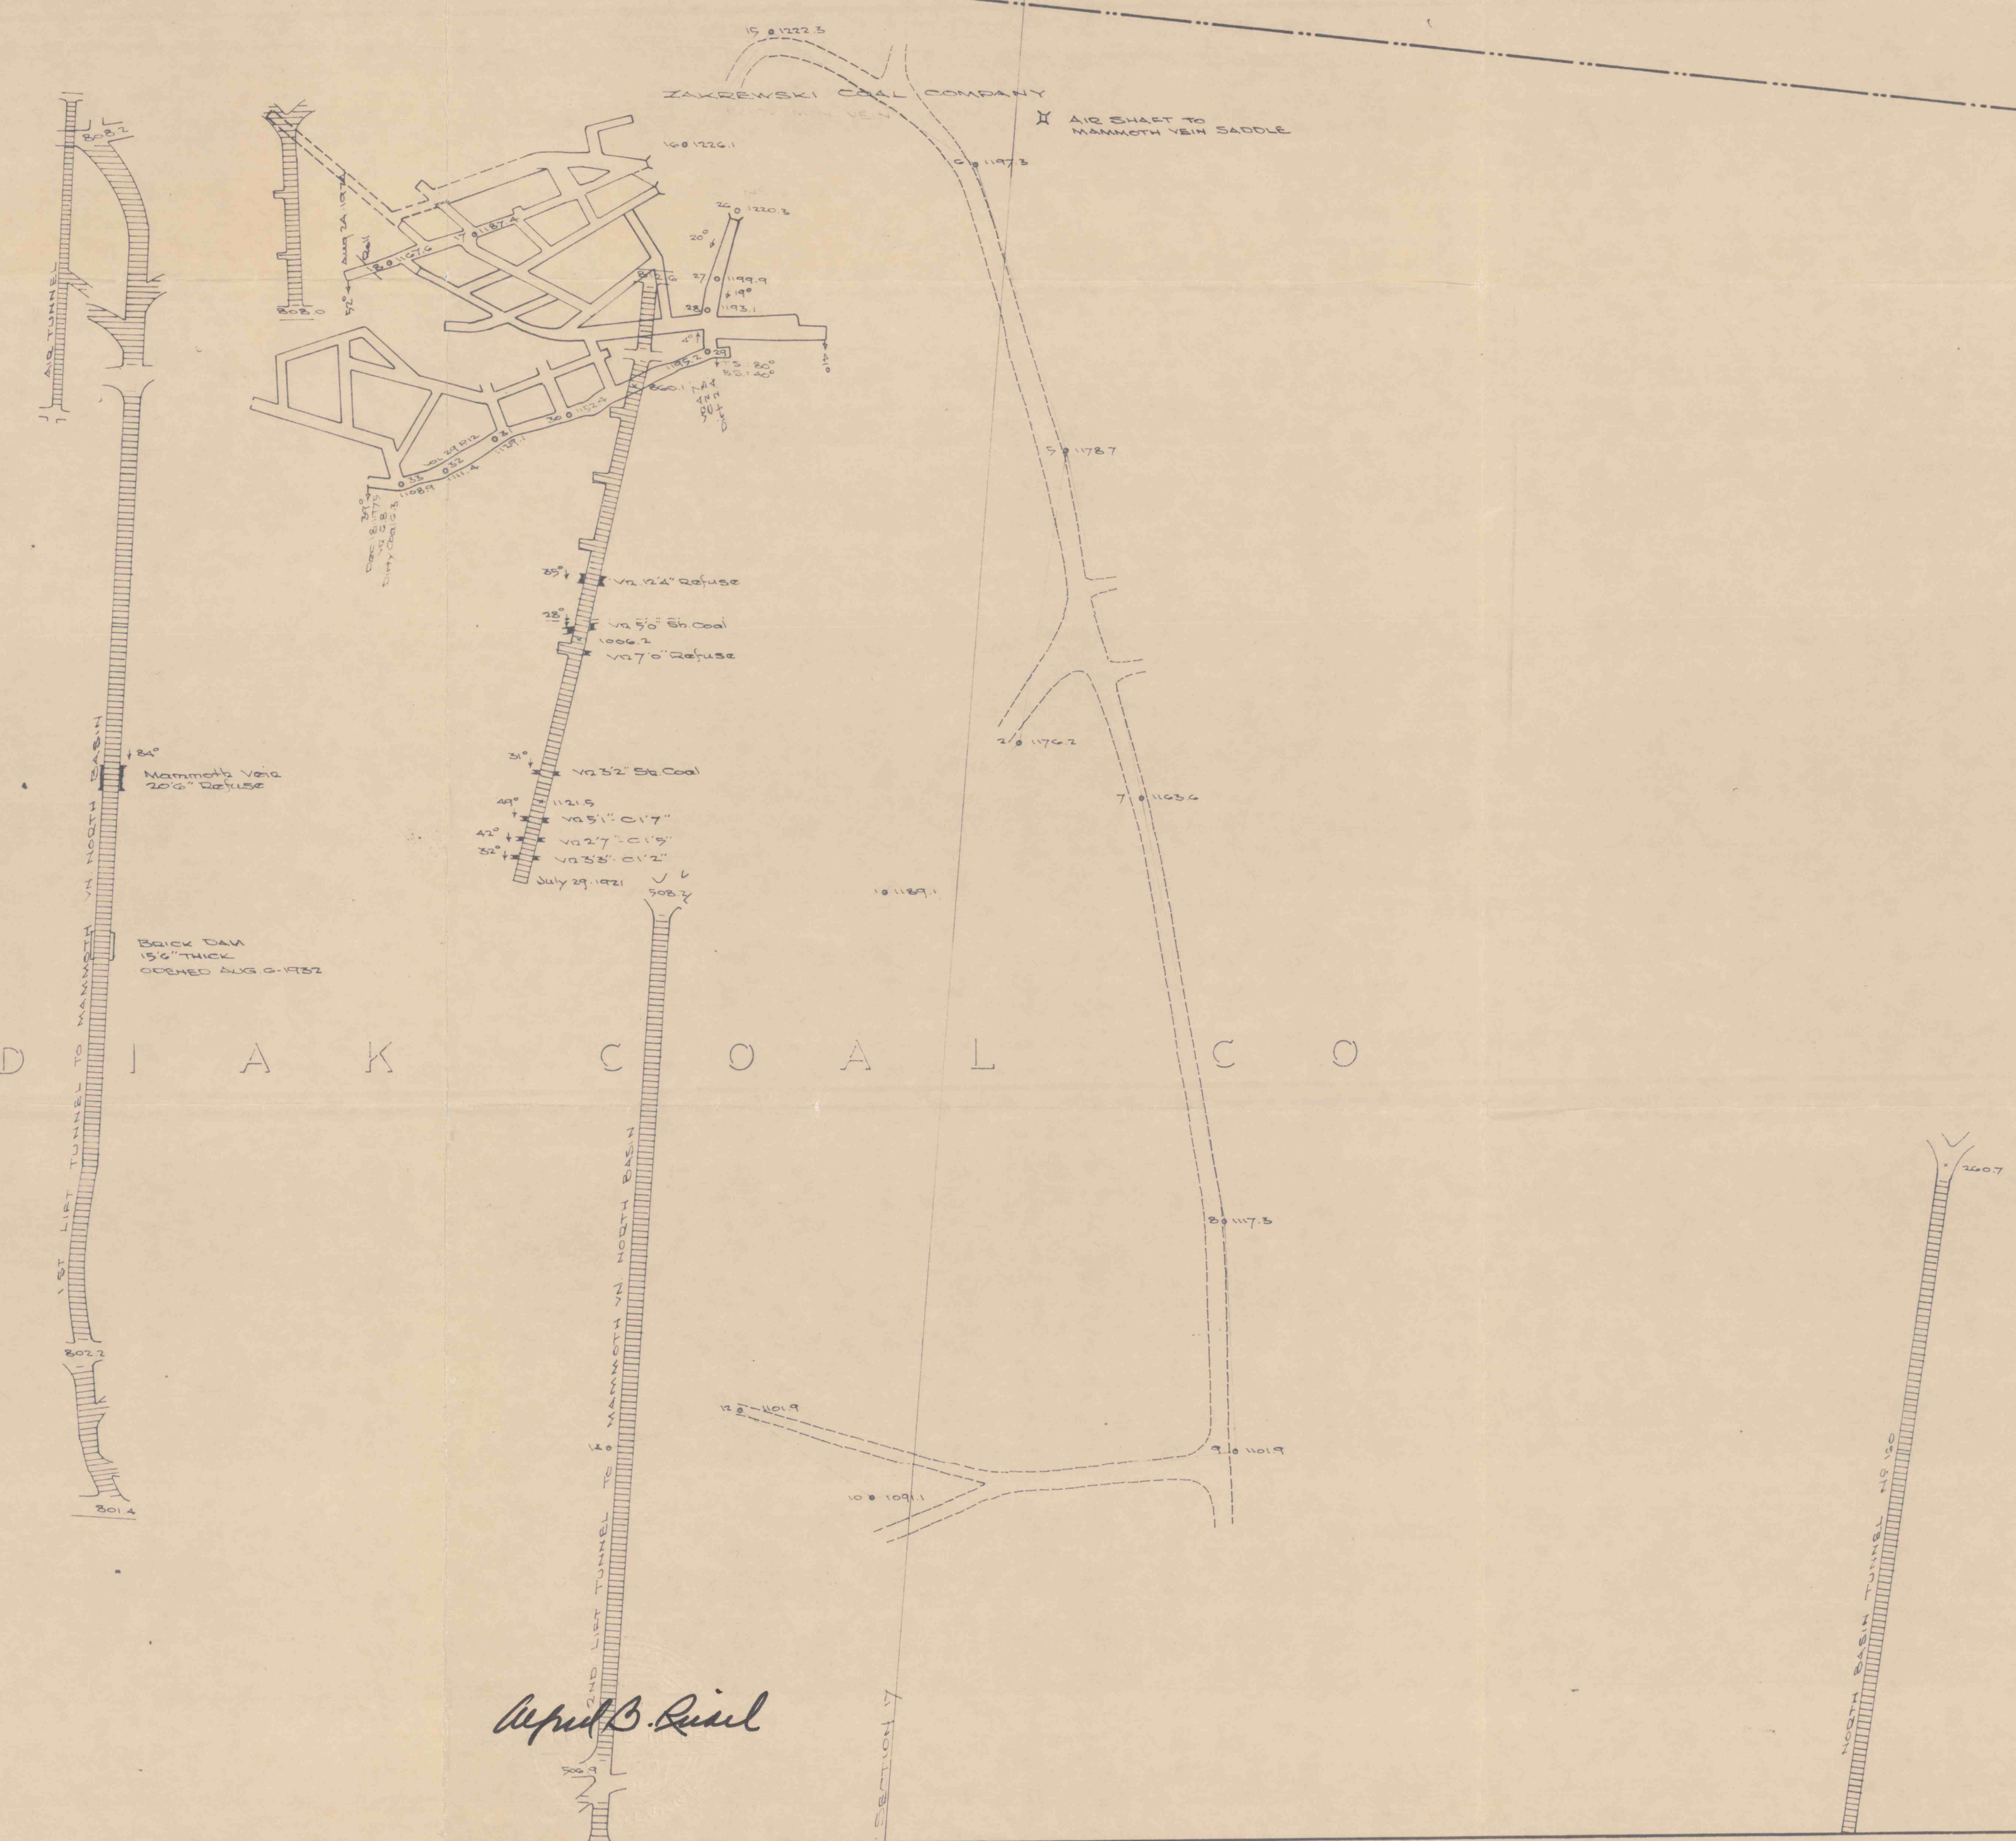

Reidel B. Riedel

MINE MAP
 Showing the location and extent of development of the Zakrewski Coal Co. Slope Mine. Situate on the So. dip Buck Mountain Vein, Conyngham Twp., Columbia County, Pa.
 A.B. Riedel, P.E. Dec. 18, 1975
 Scale 1"=100'