



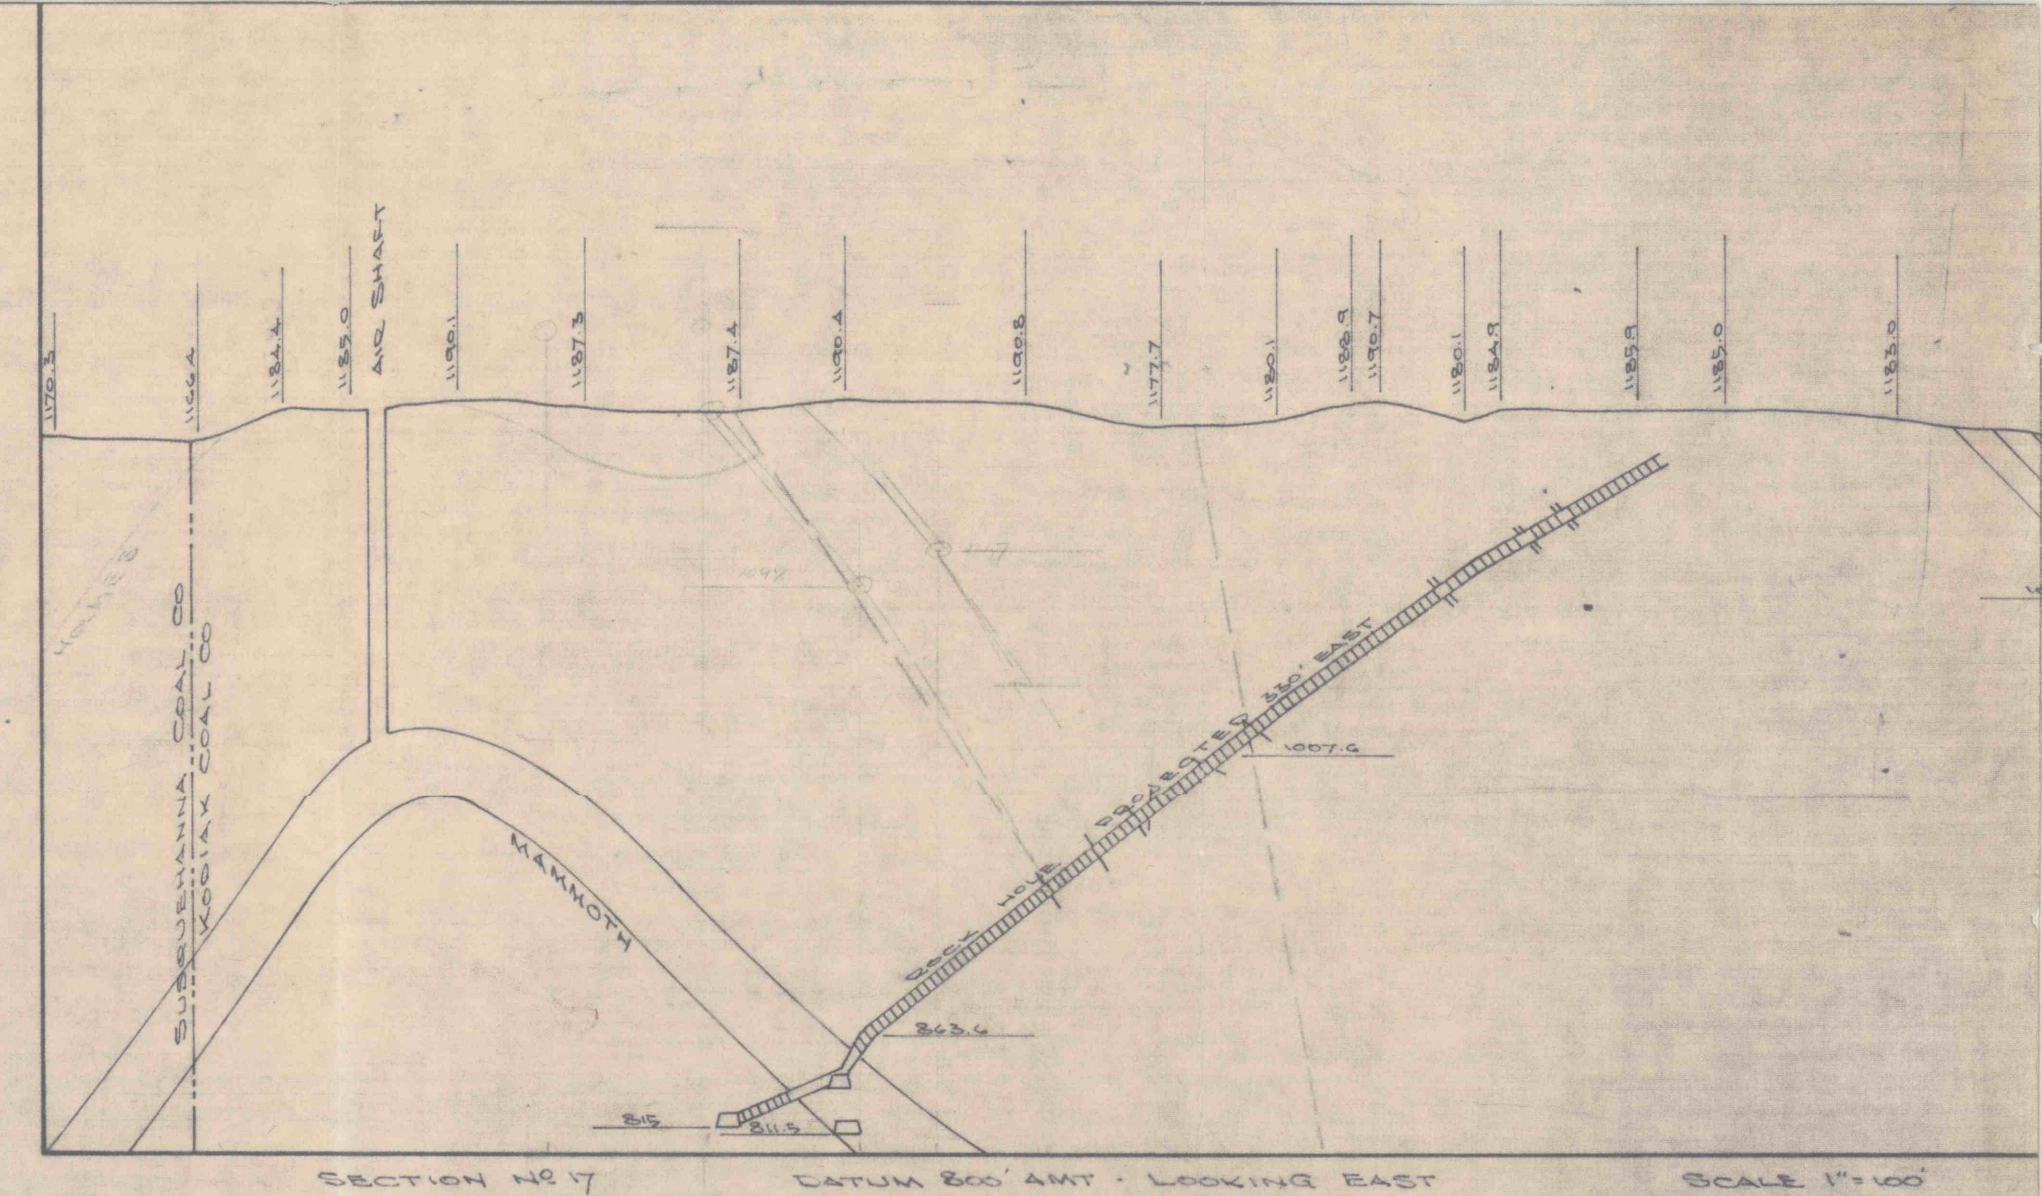

S U S Q U E H A N N A C O A L C O

K O D I A K C O A L C O

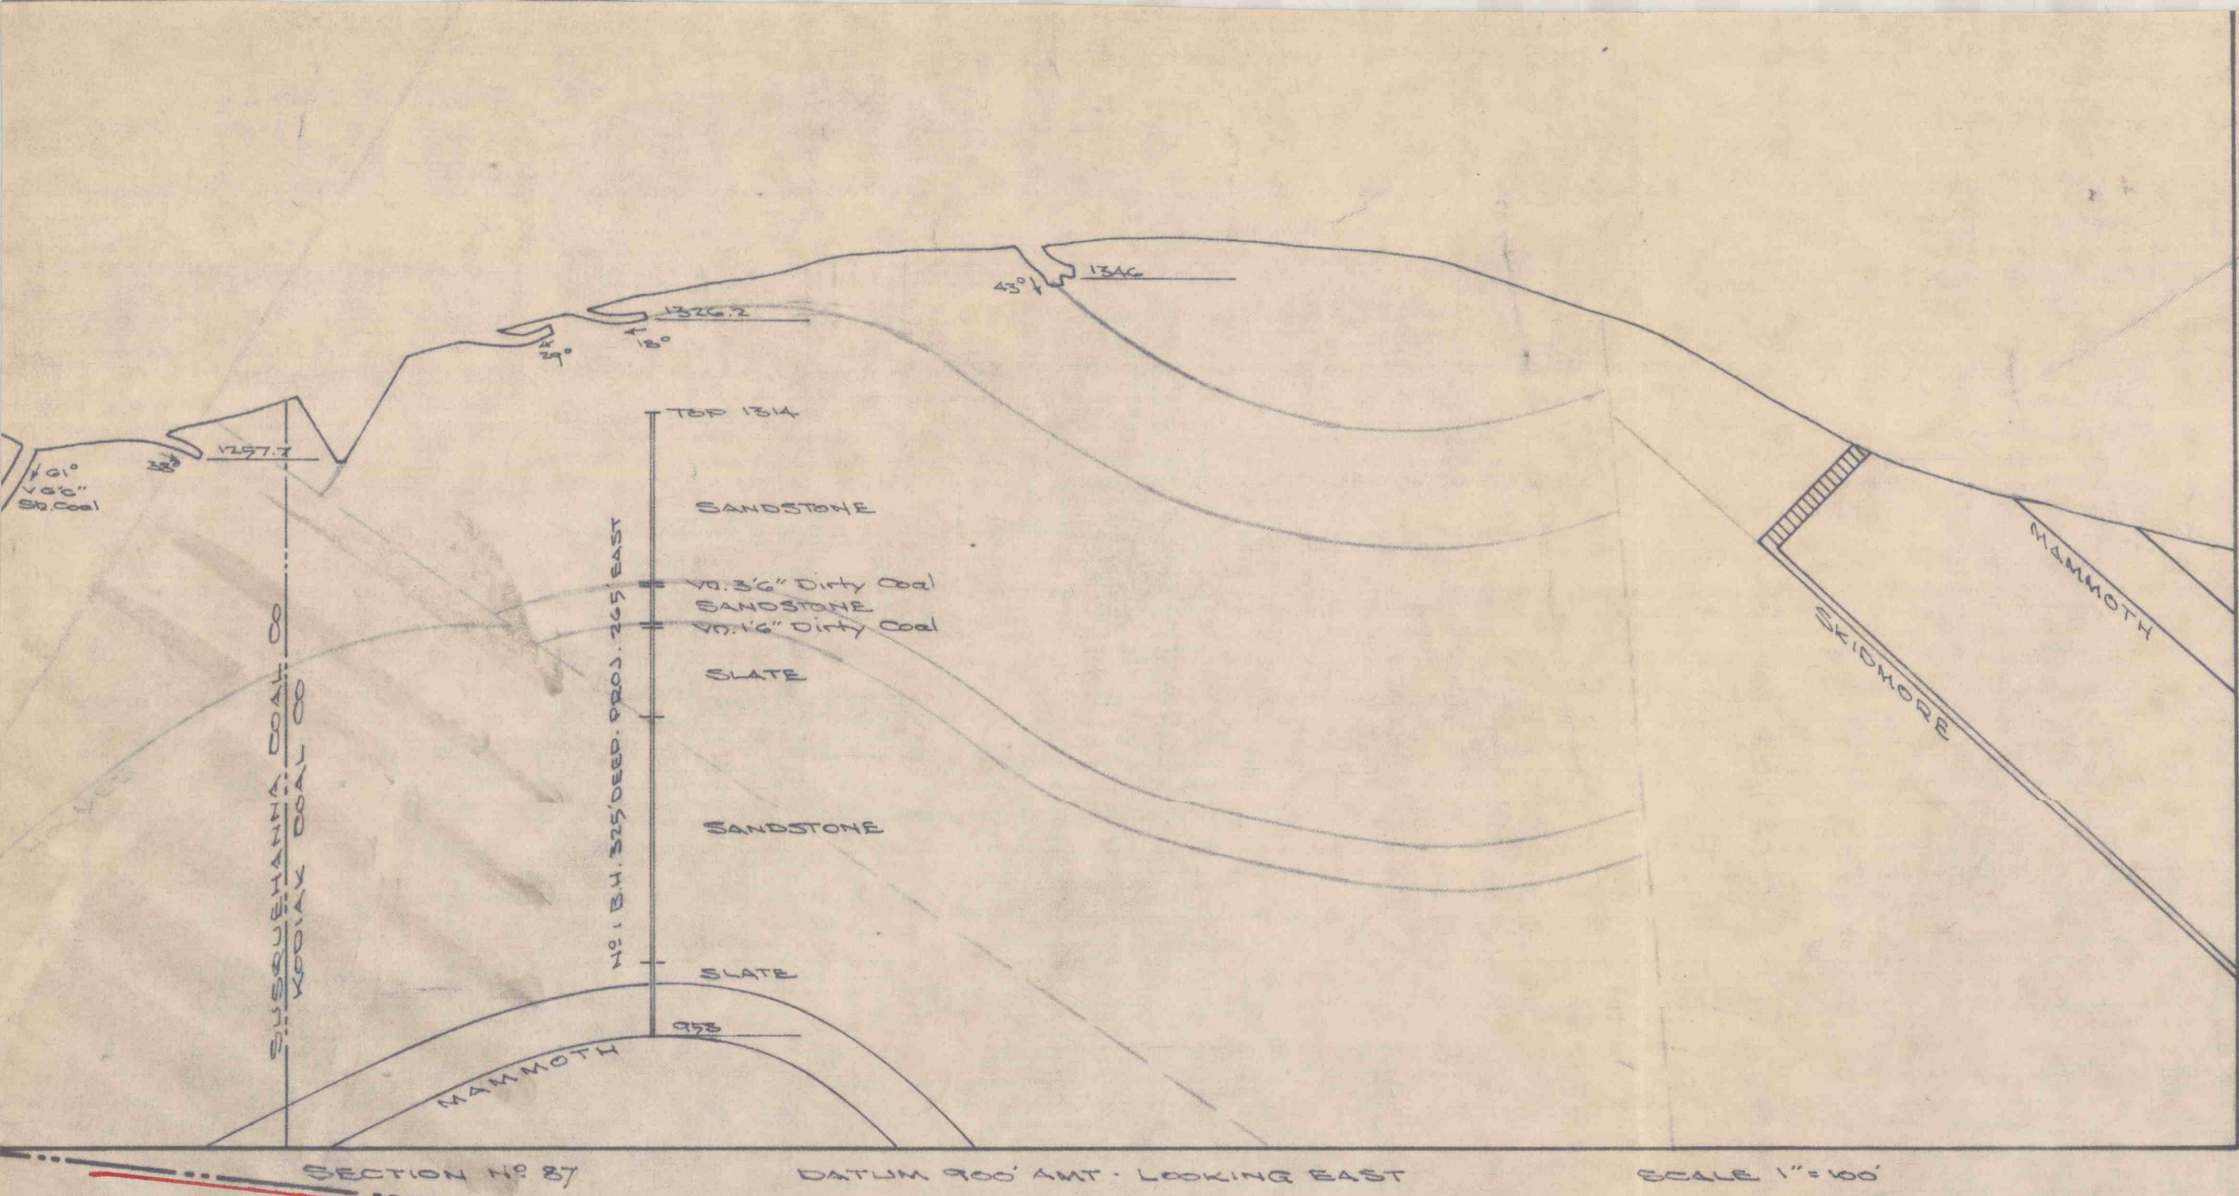

Appl. B. Riedel

Potts Colliery
Water Level = 979.4

MINE MAP
Showing the location and extent of development
of the Zakrewsky Coal Co. Buck Slope. Situate
on the So. dip Holmes Vein, Conyngham Township,
Columbia County, Pa.
A. B. Riedel, P. E. Feb. 15, 1920
Scale 1"=100'

(617)