

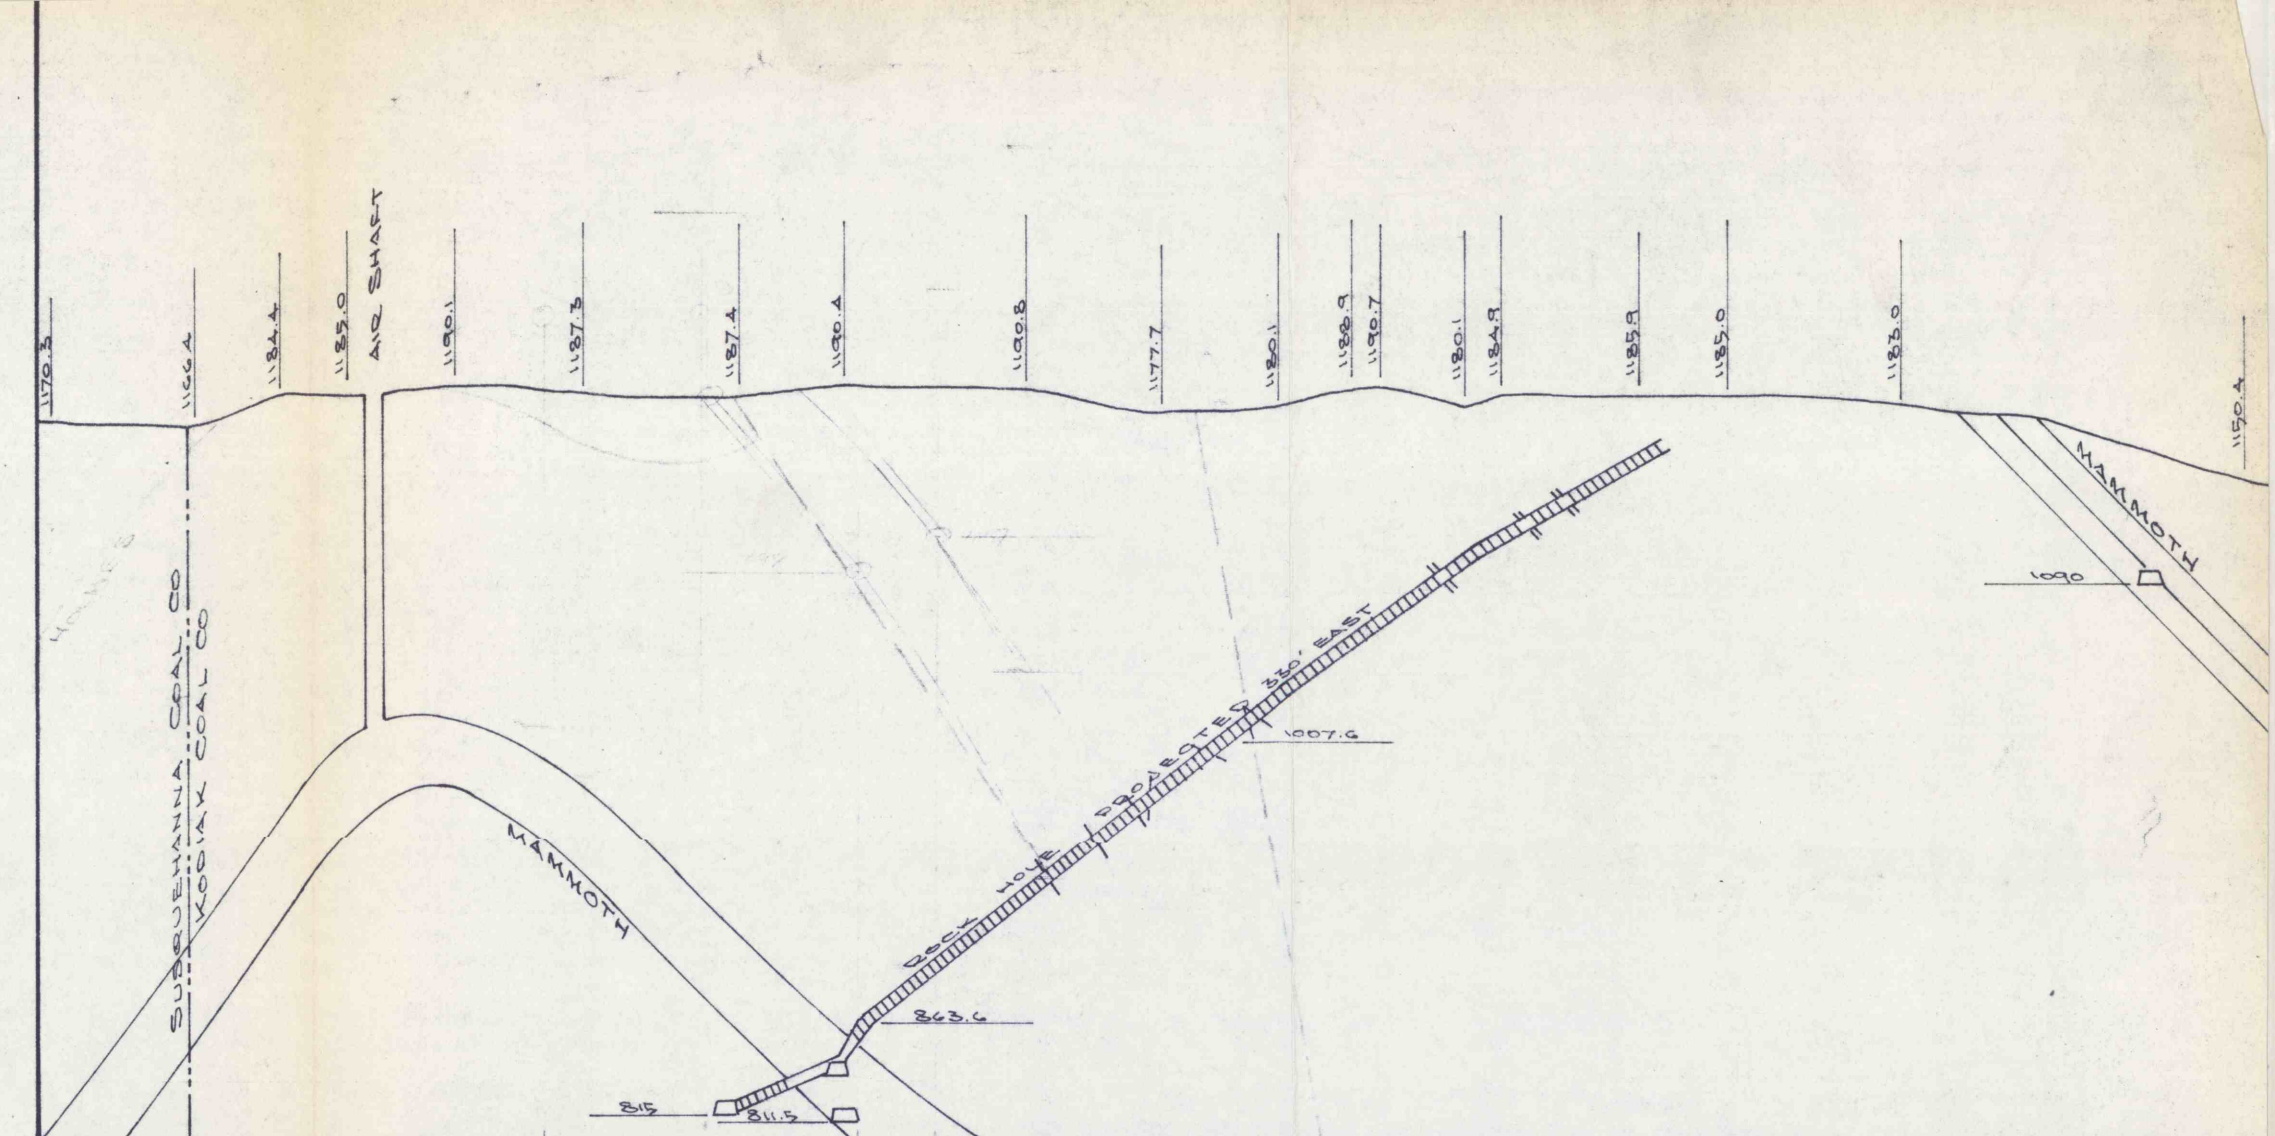


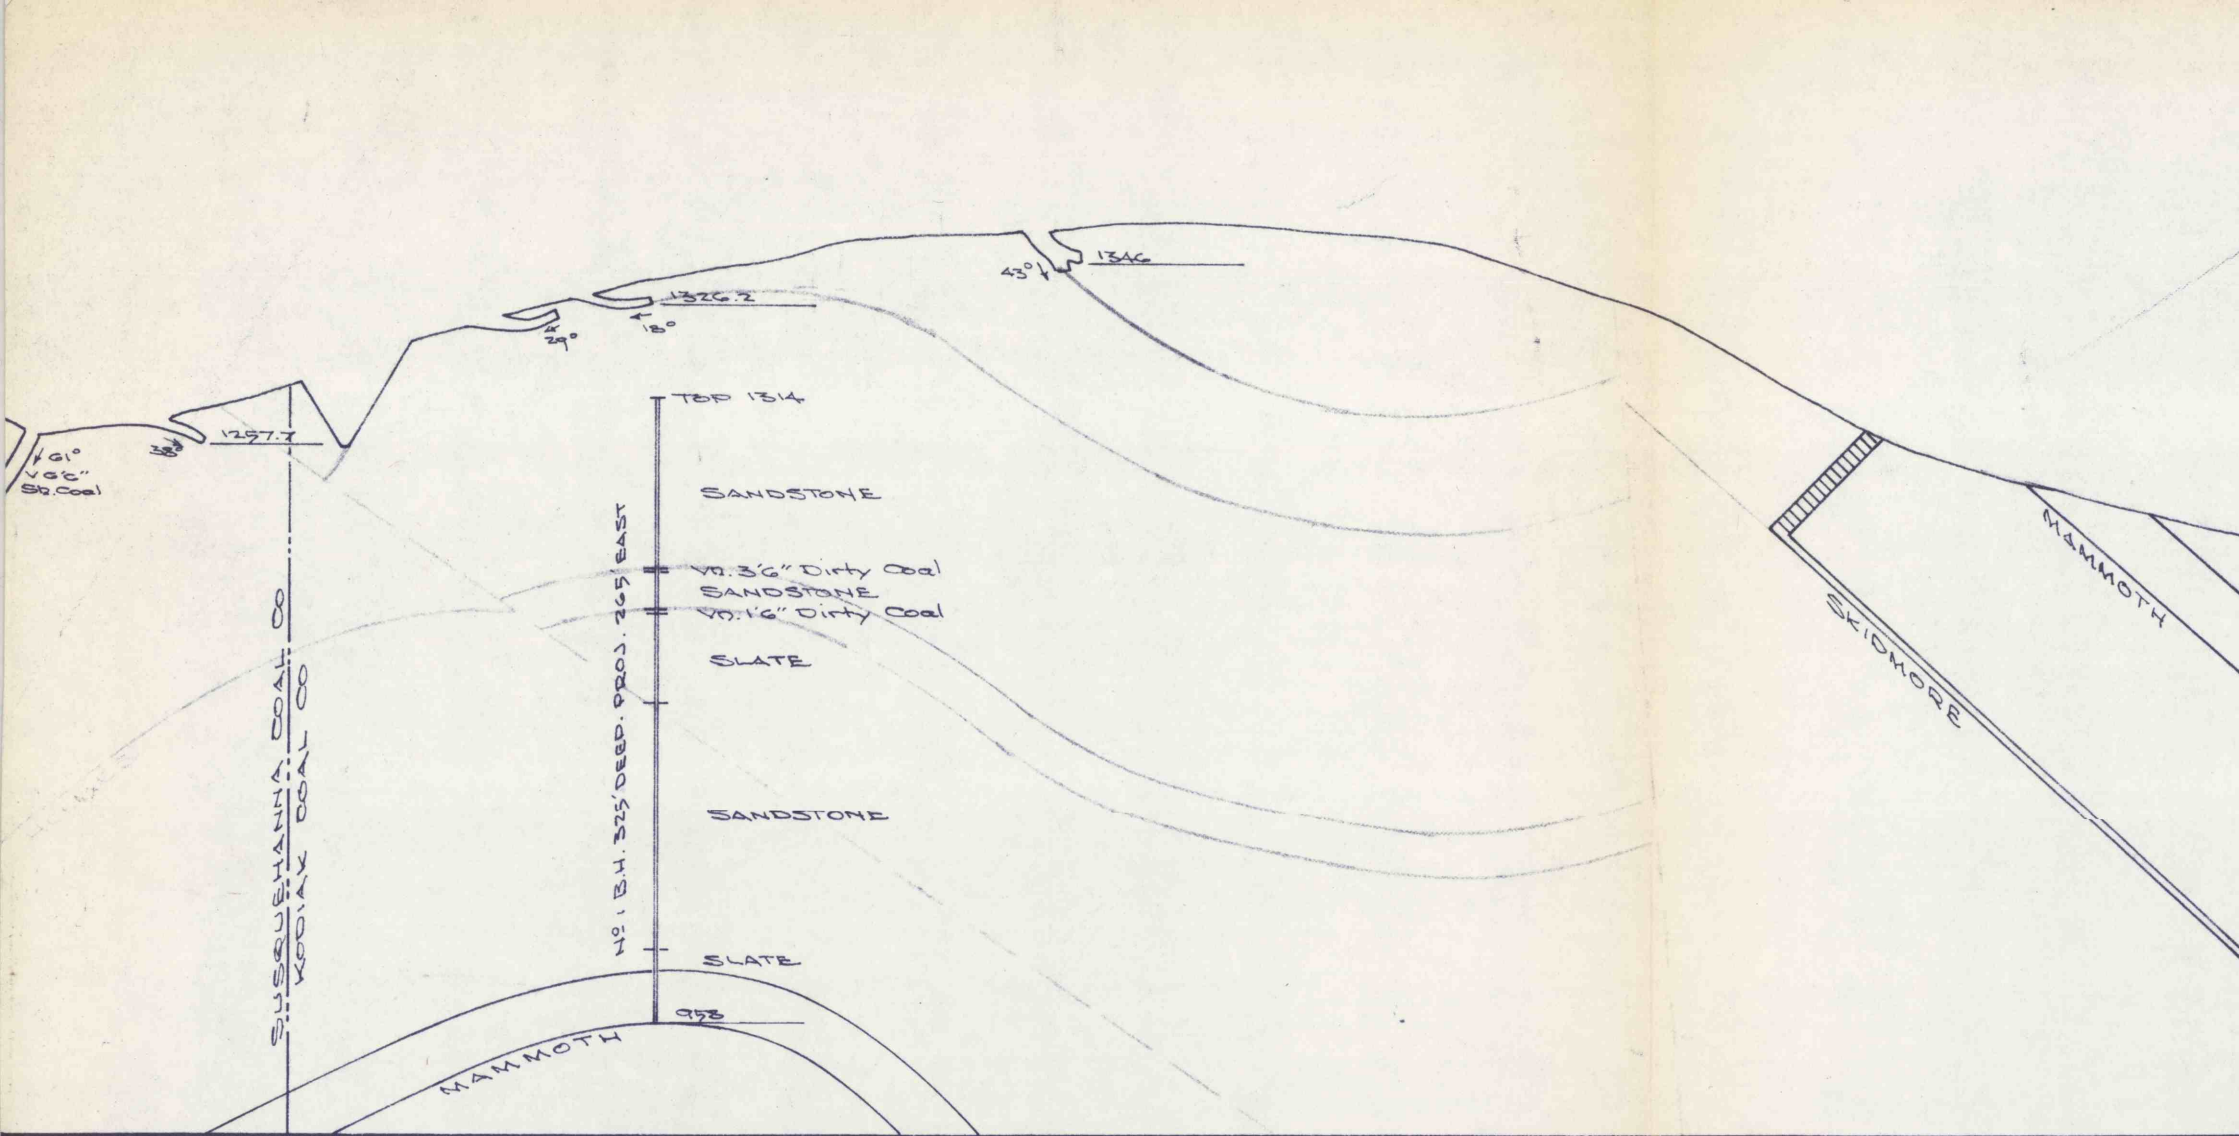

S U S Q U E H A N N A C O A L C O

K O D I A K C O A L C O

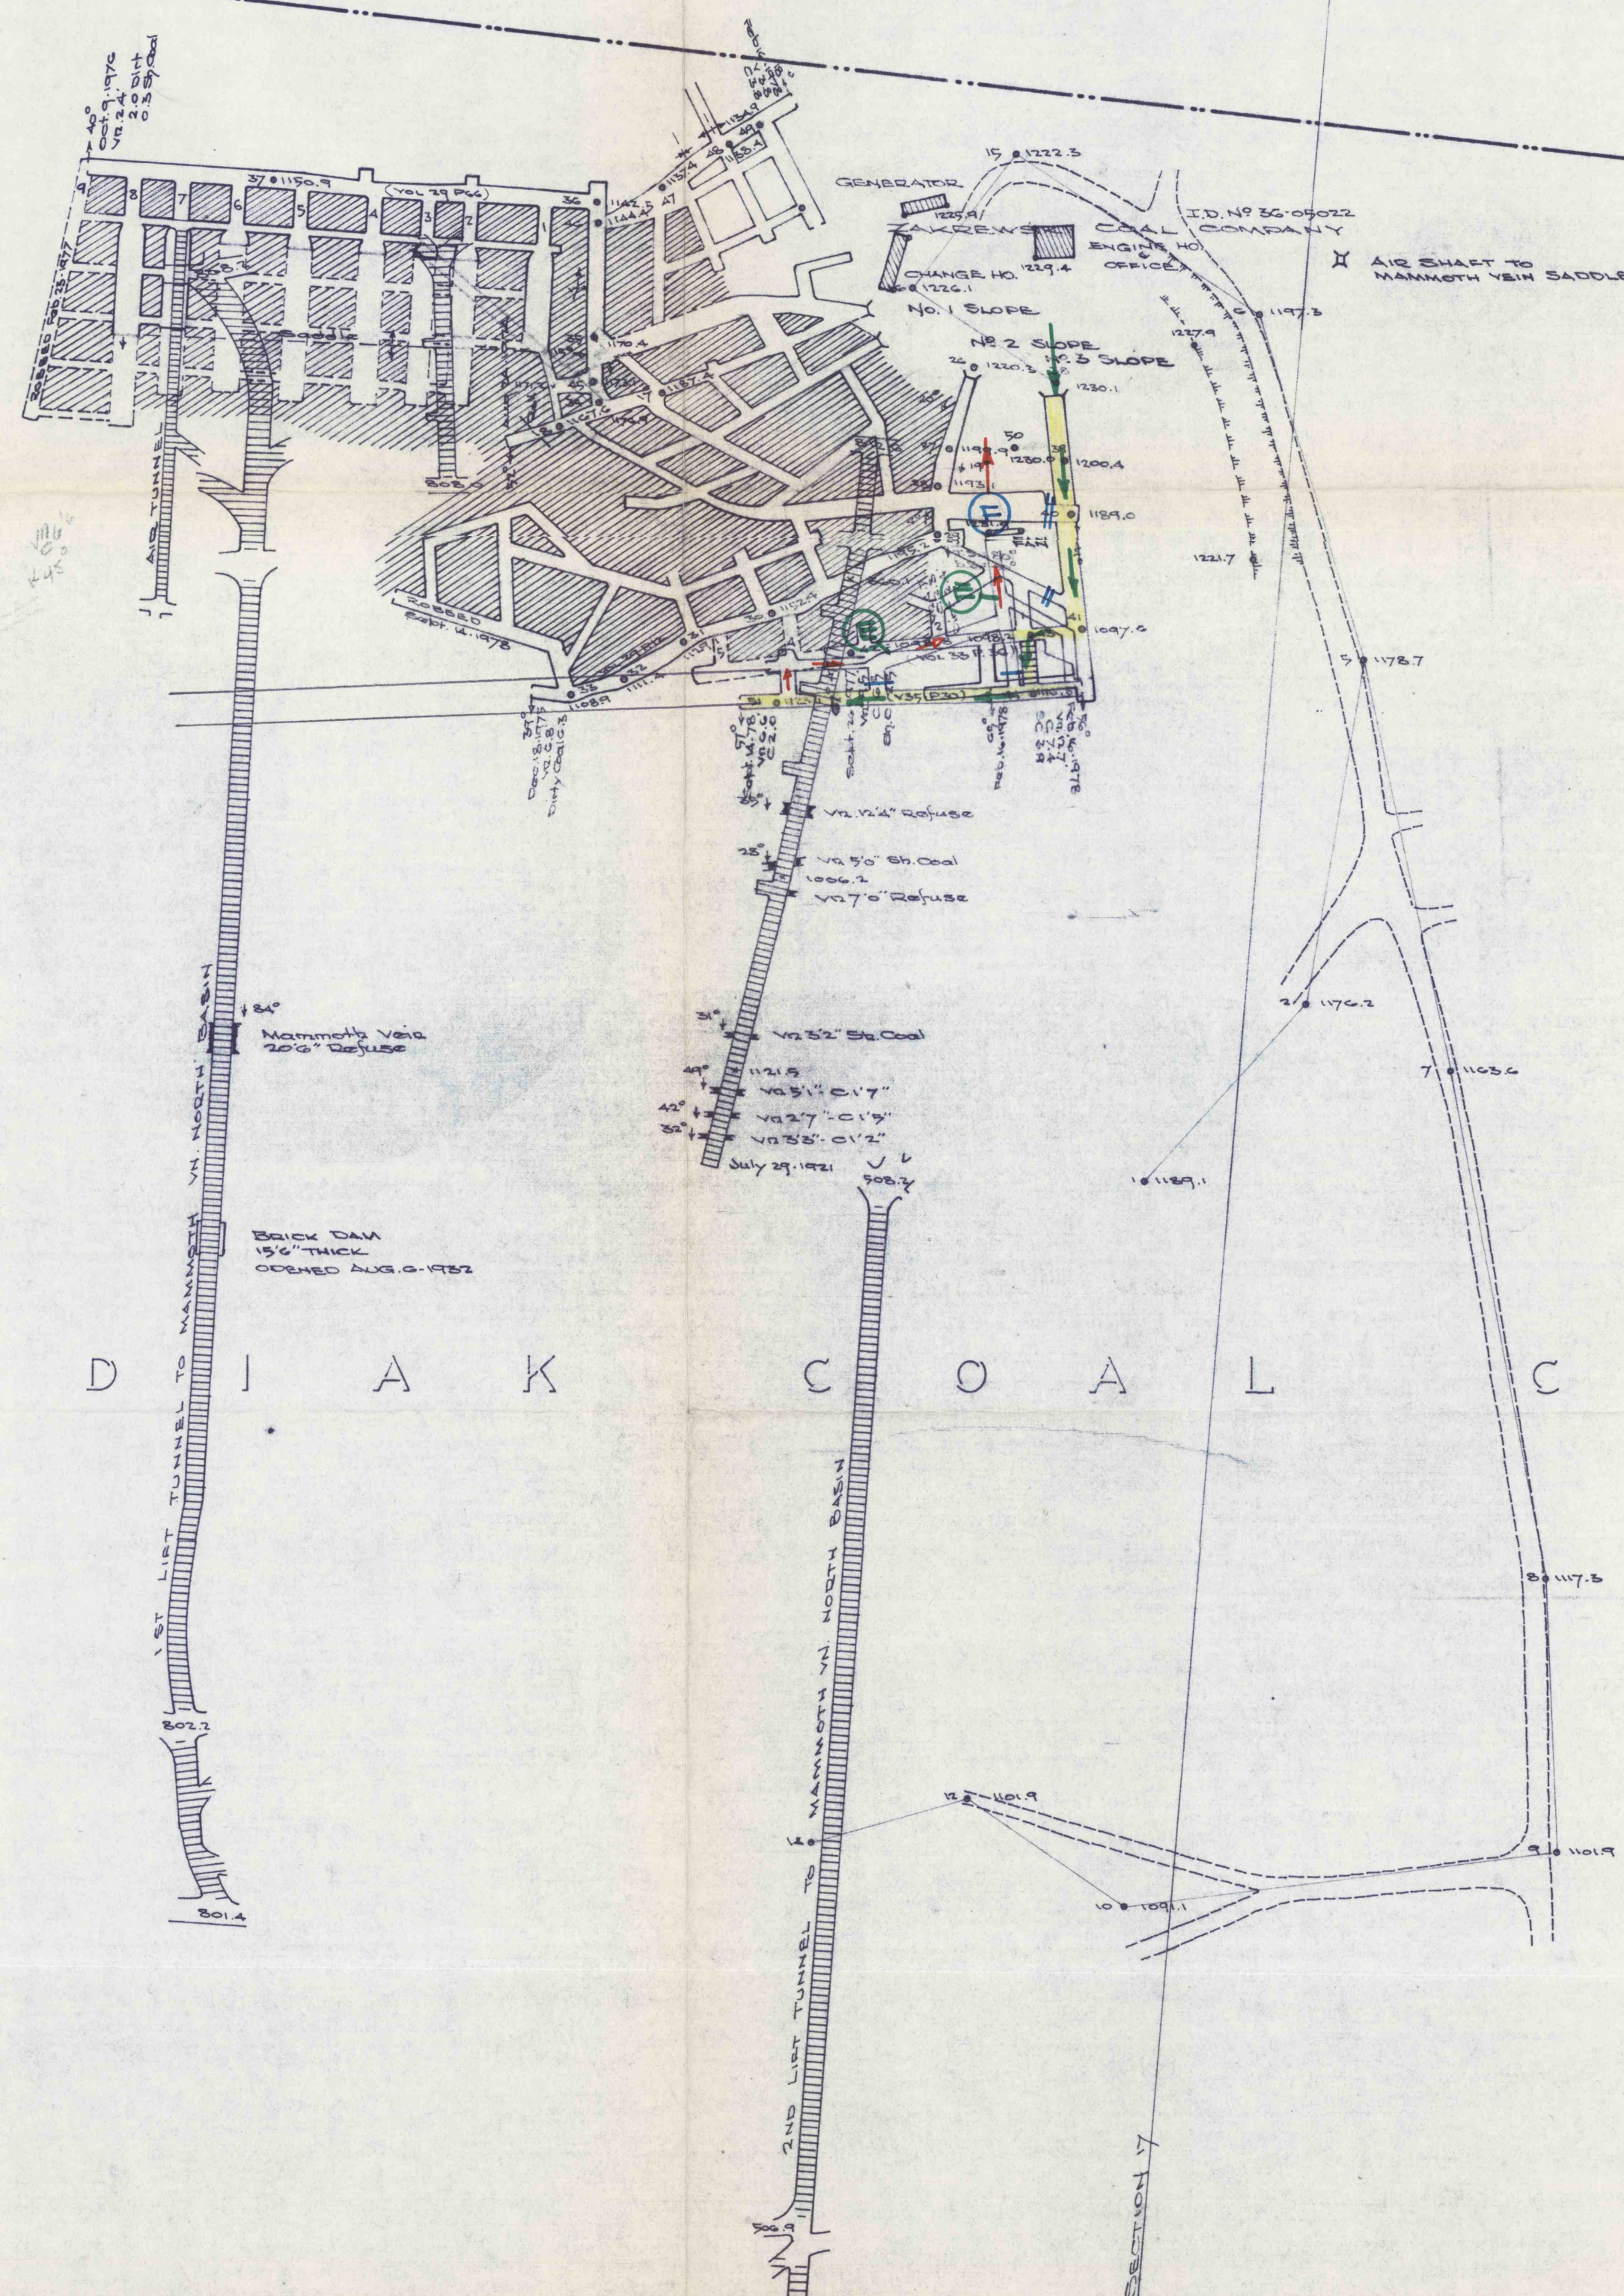

Wm. B. Riedel

MINE MAP
Showing the location and extent of development of the Zakrewsky Coal Company Slope Mine. Situate on the No. and So. dips of the Holmes Vein, Conyngham Twp., Columbia County, Pa.
A.B. Riedel, P.E. Sept. 14, 1978
Scale 1"=100'