

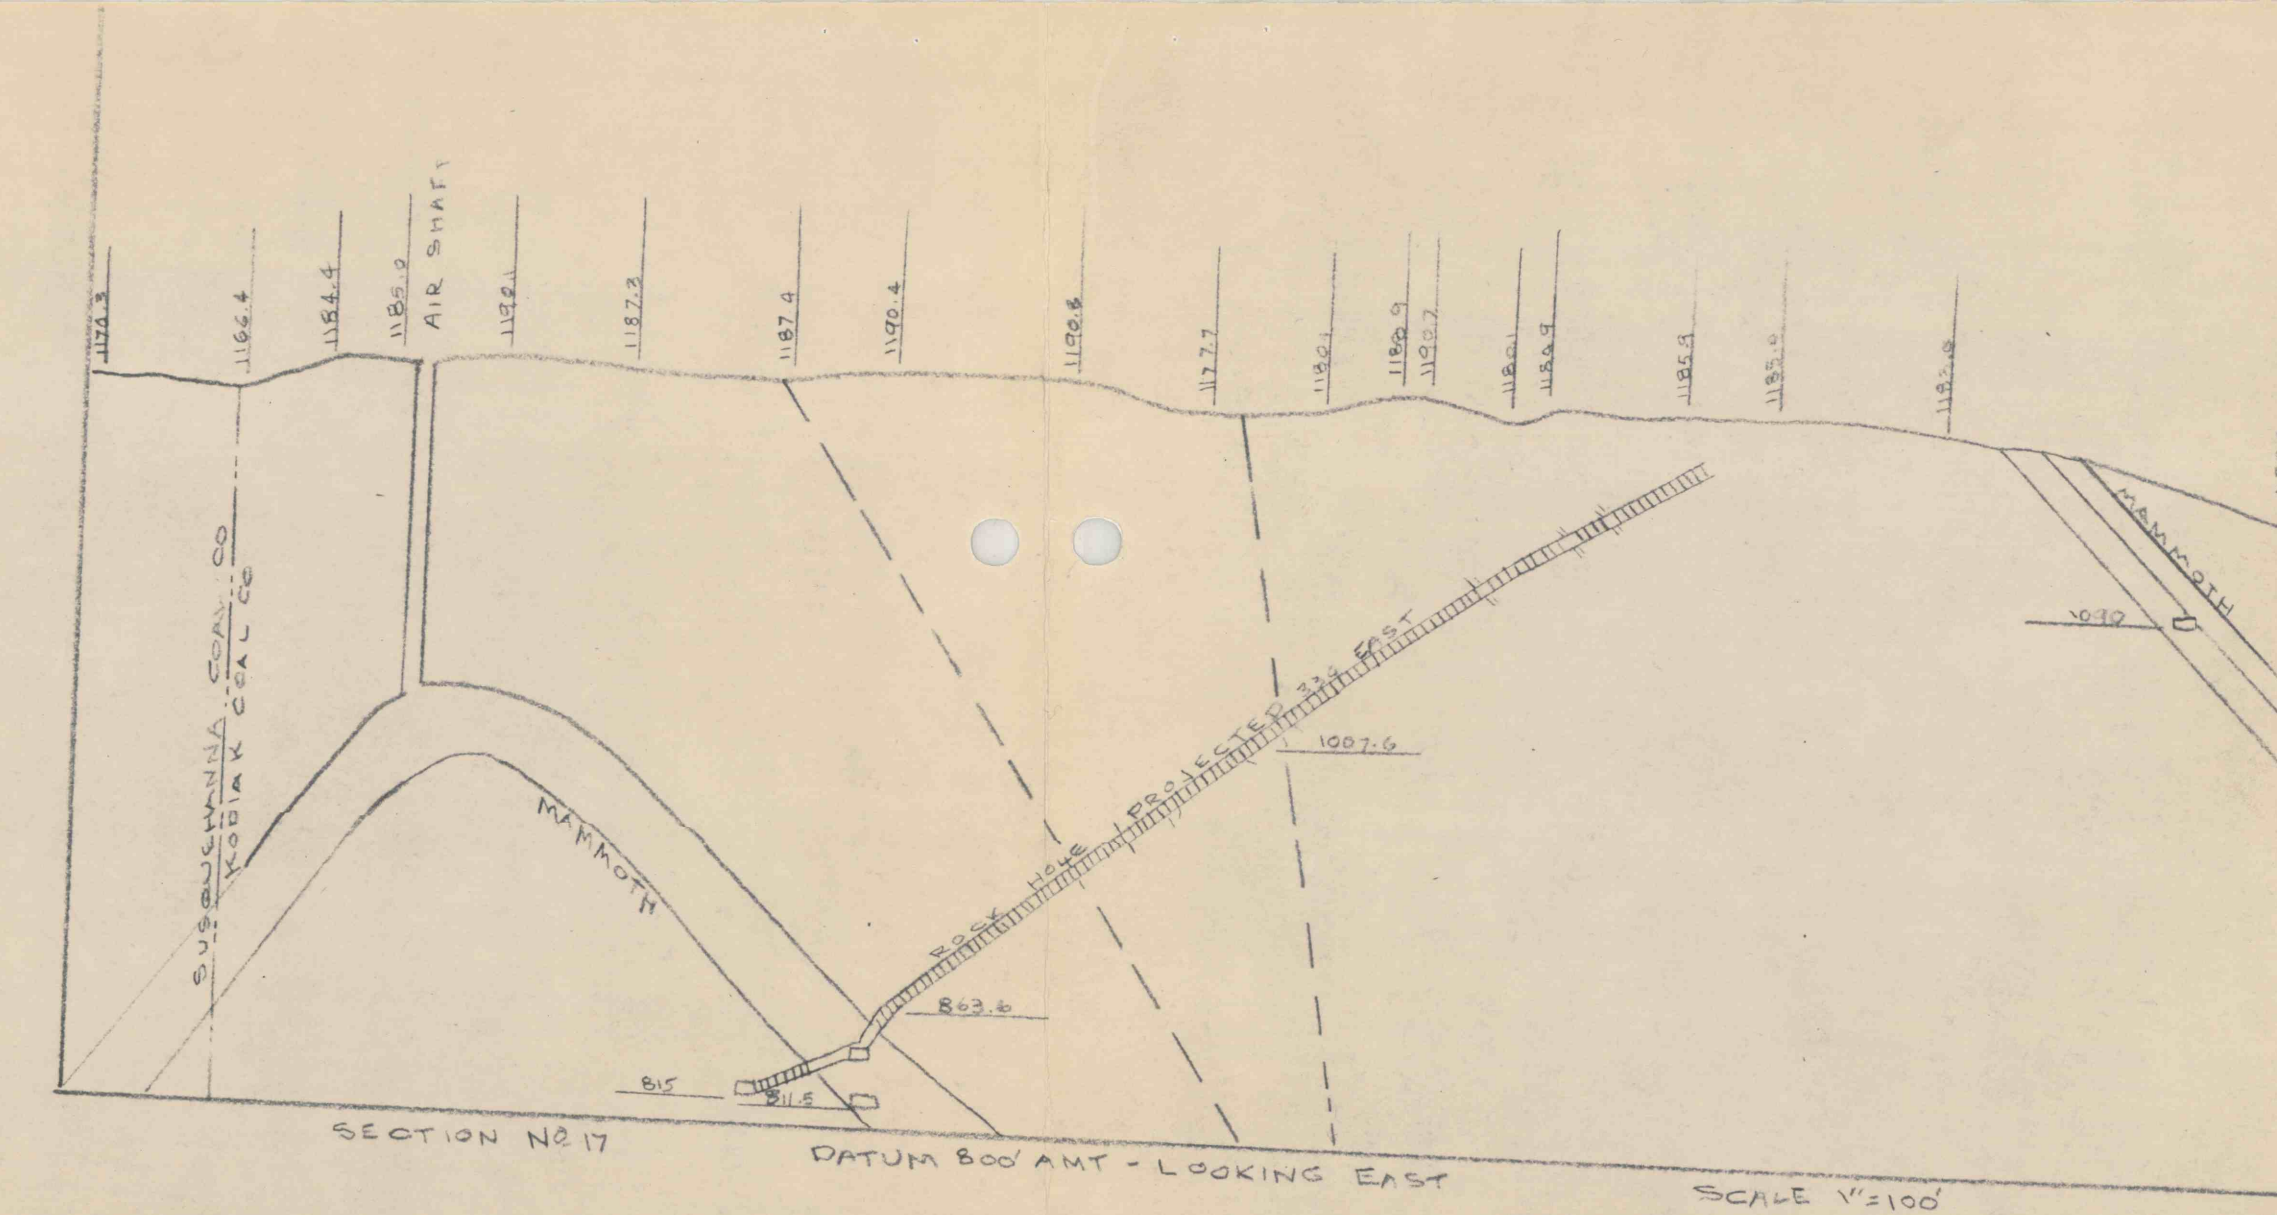


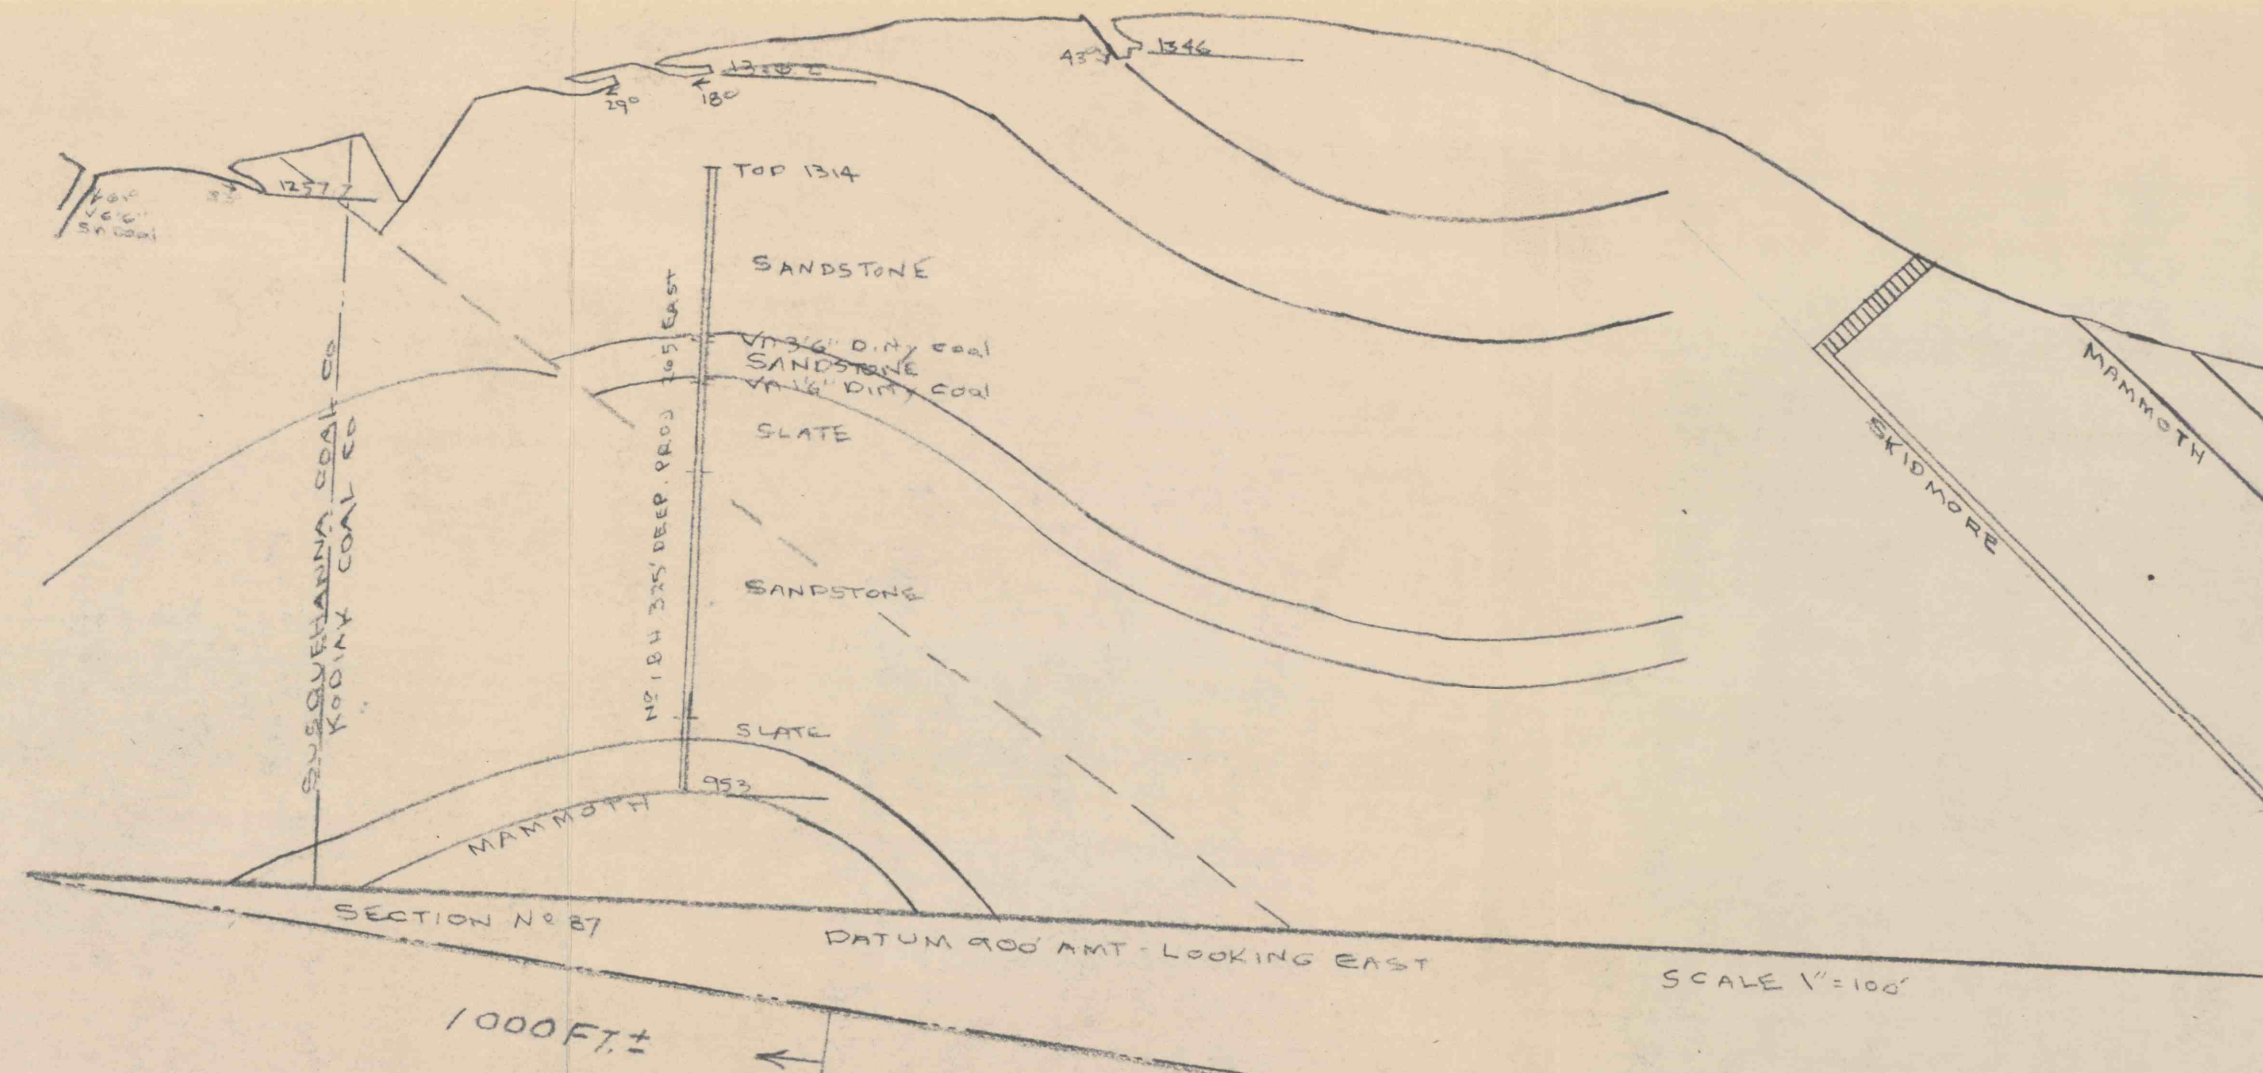

S U S Q U E H A N N A C O A L C O

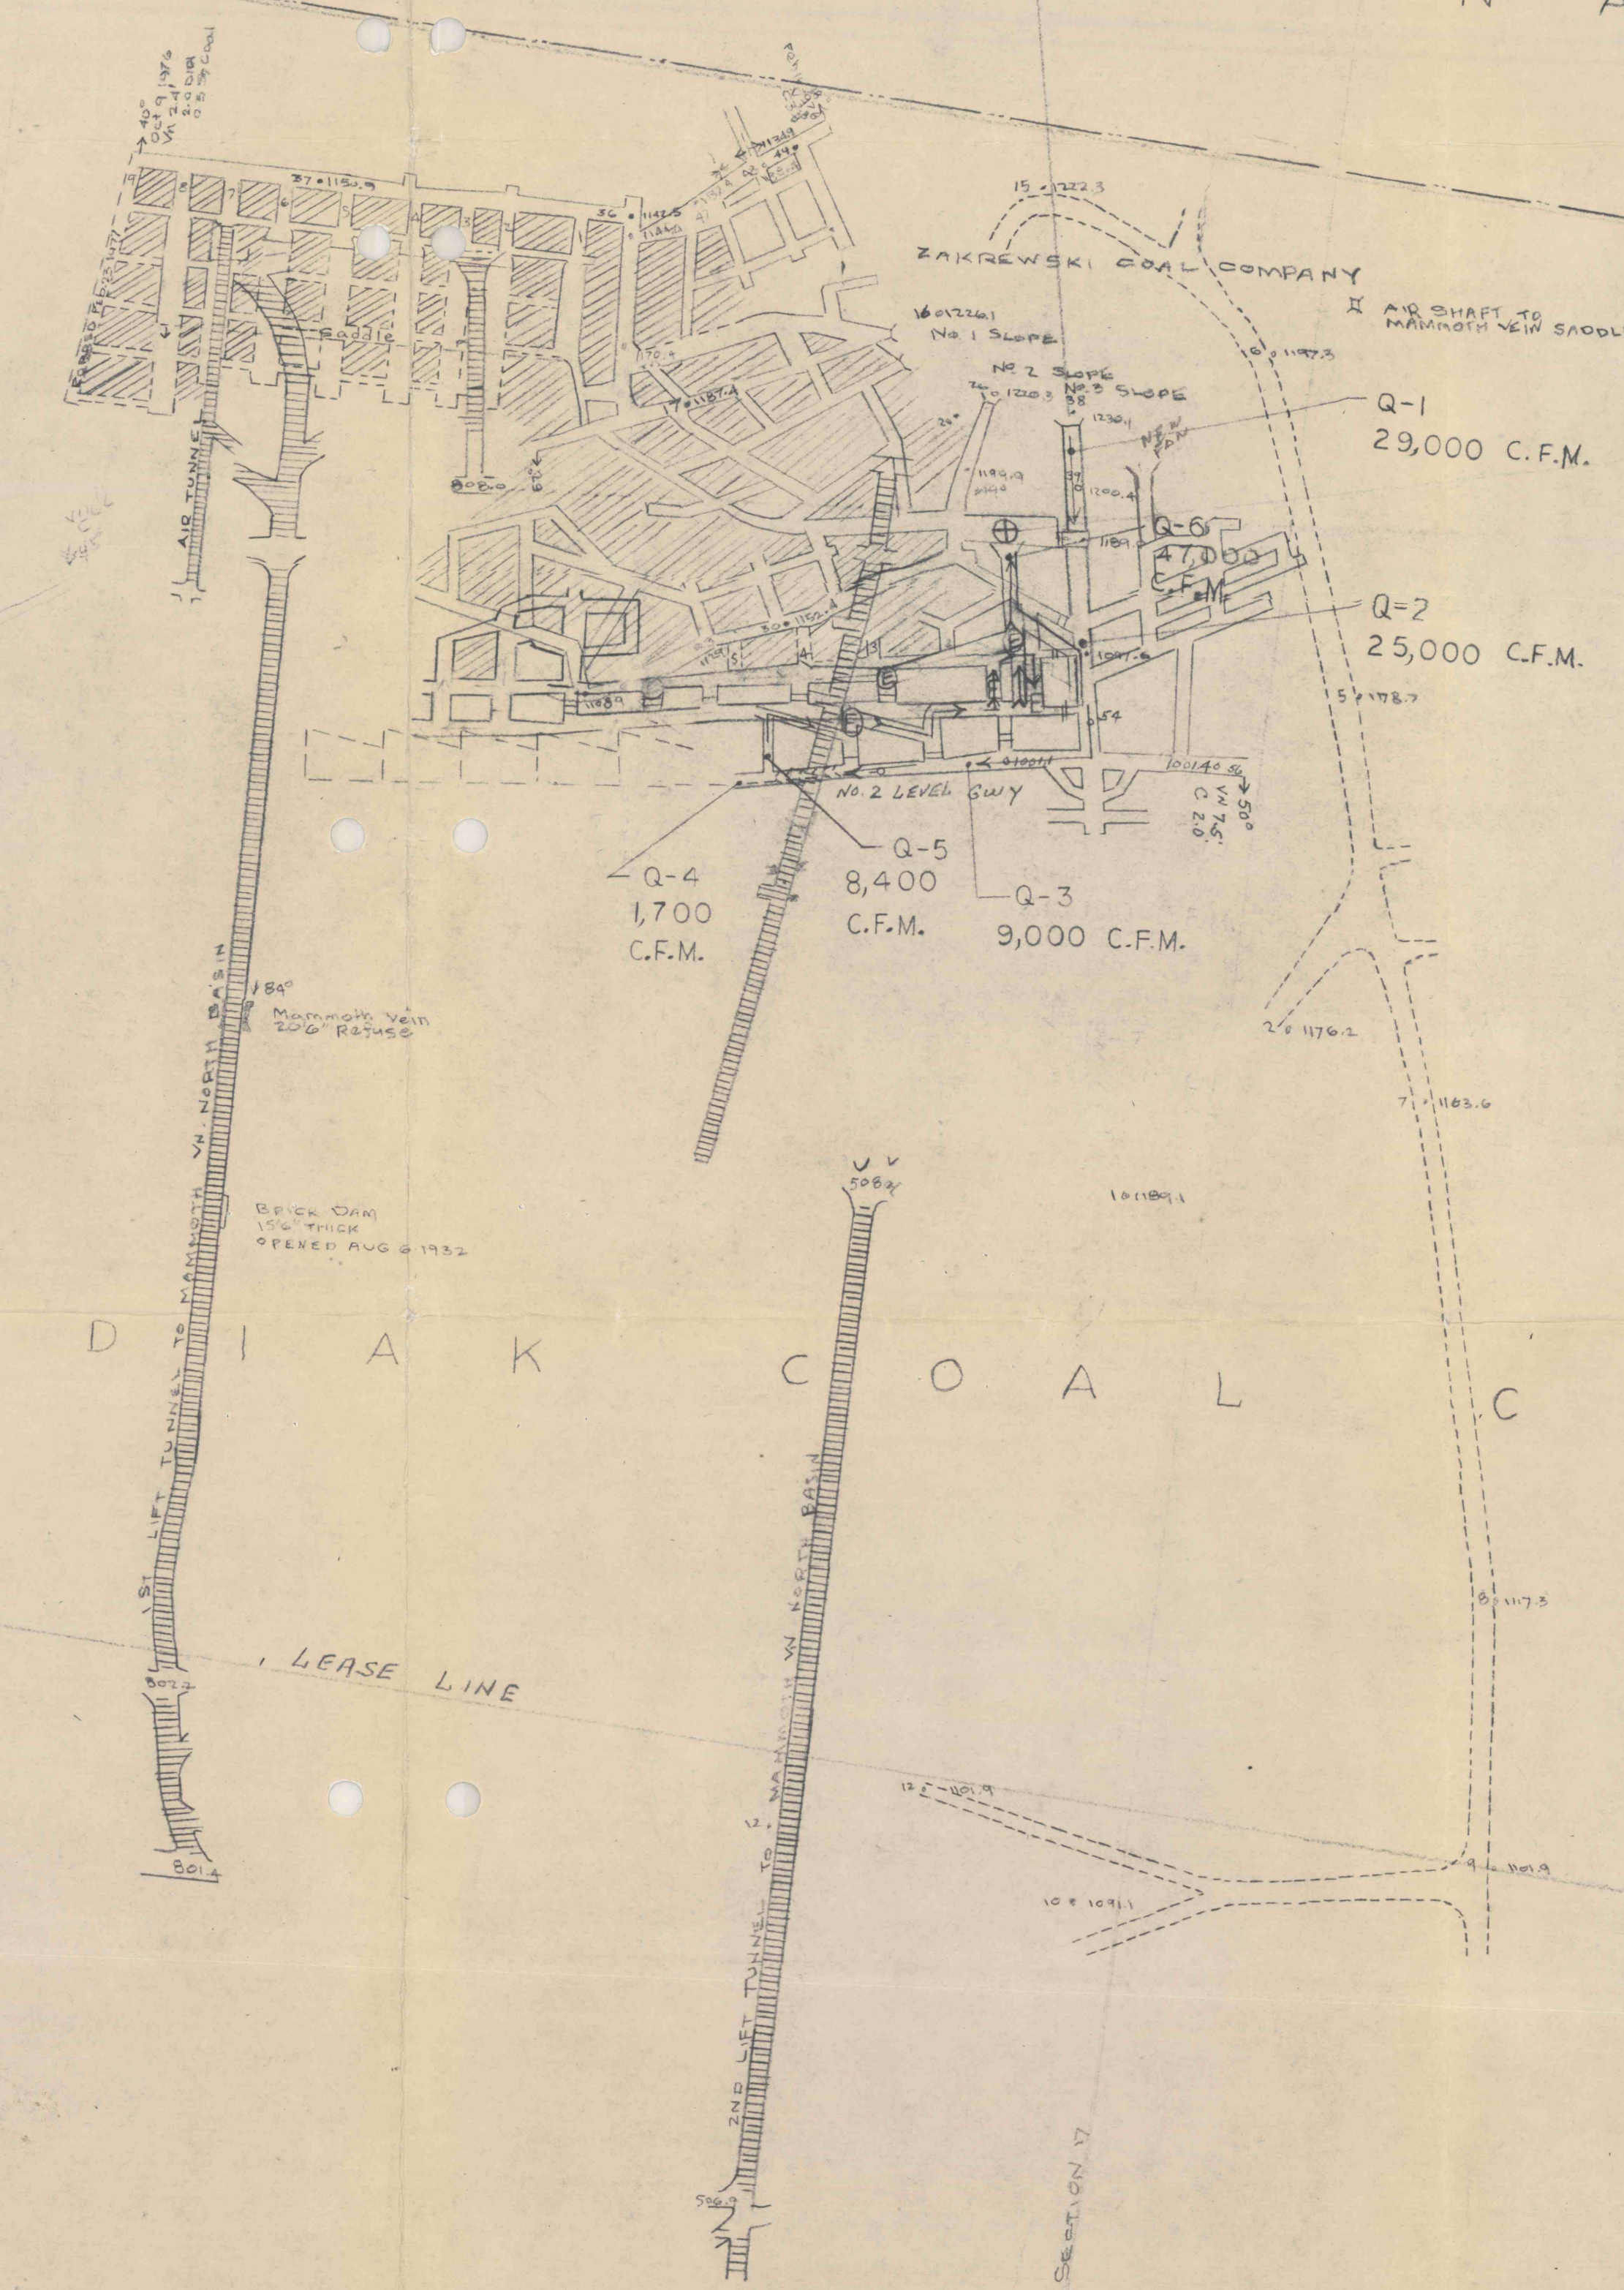

LEHIGH COMPANY
 42-INCH-DIAMETER CENTRIFUGAL FAN
 40 HP - 440 VOLT - 3 PHASE MOTOR
 SPEED OF FAN 575 R.P.M.
 W.G. = 3.8 INCHES
 CH 4 = 0.00%

BUCK SLOPE
 I.D. NO. 36-05022
 ZAKREWSKI COAL COMPANY
 LOCUSTDALE, COLUMBIA COUNTY, PA.
 PRIMROSE VEIN

SCALE - 1"=100' DATE - MAY 9, 1980

K O D I A K C O A L C O

A MINIMUM QUANTITY OF 1,500 C.F.M. WILL BE MAINTAINED AT EACH WORKING FACE.
 A MINIMUM QUANTITY OF 5,000 C.F.M. WILL BE MAINTAINED AT THE LAST OPEN CROSSCUT
 A MINIMUM QUANTITY OF 5,000 C.F.M. WILL BE MAINTAINED AT THE INTAKE END OF
 PILLAR LINE.
 LINE BRATTICE OR VENTILATION TUBING WILL BE MAINTAINED WITHIN 20
 FEET OF EACH WORKING FACE.

LEGEND	
Y	MINE OPENING
⊕	MAIN FAN
→	INTAKE AIR
⇐	RETURN AIR
I	TEMPORARY STOPPING
II	PERMANENT STOPPING
Q	AIR MEASUREMENT LOCATION
---	LINE BRATTICE
---	AIR FAN WITH TUBING
⊕	ESCAPE WAY

I.D. #36-05022
 MINE MAP
 Showing the location and extent of development of the Zakrewski Coal Co. Slope Mine, Situate on the No. and So. dips of the Primrose Vein, Conyngham Twp., Columbia County, Pa.
 SIGNED & SEALED BY
 A.B. Riedel, P.E. Feb. 16, 1978
 Scale 1"=100'