



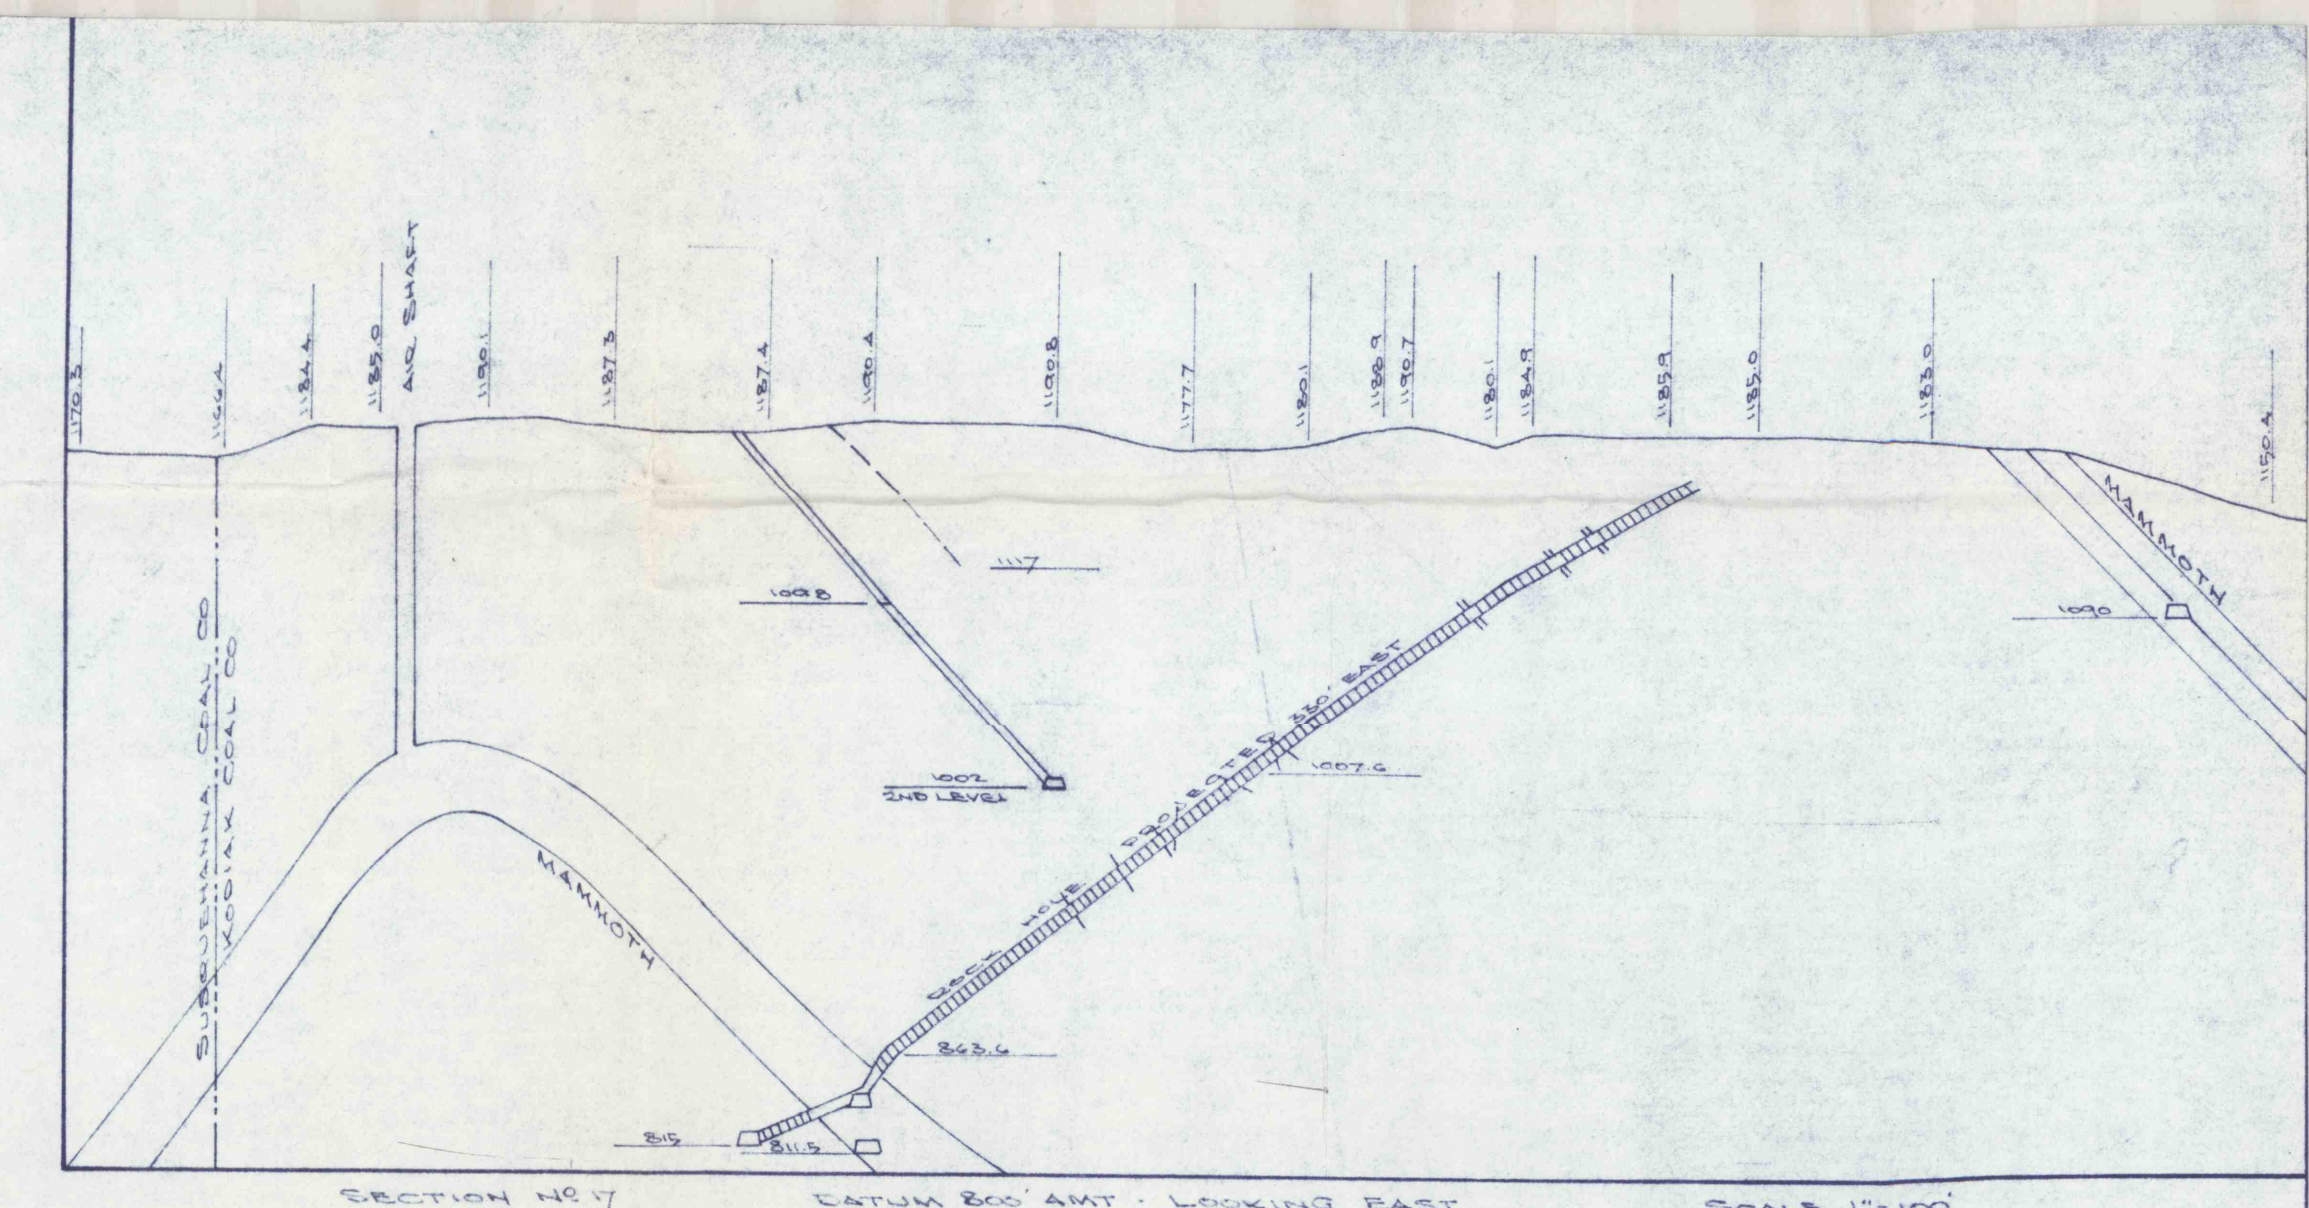

S U S Q U E H A N N A C O A L C O

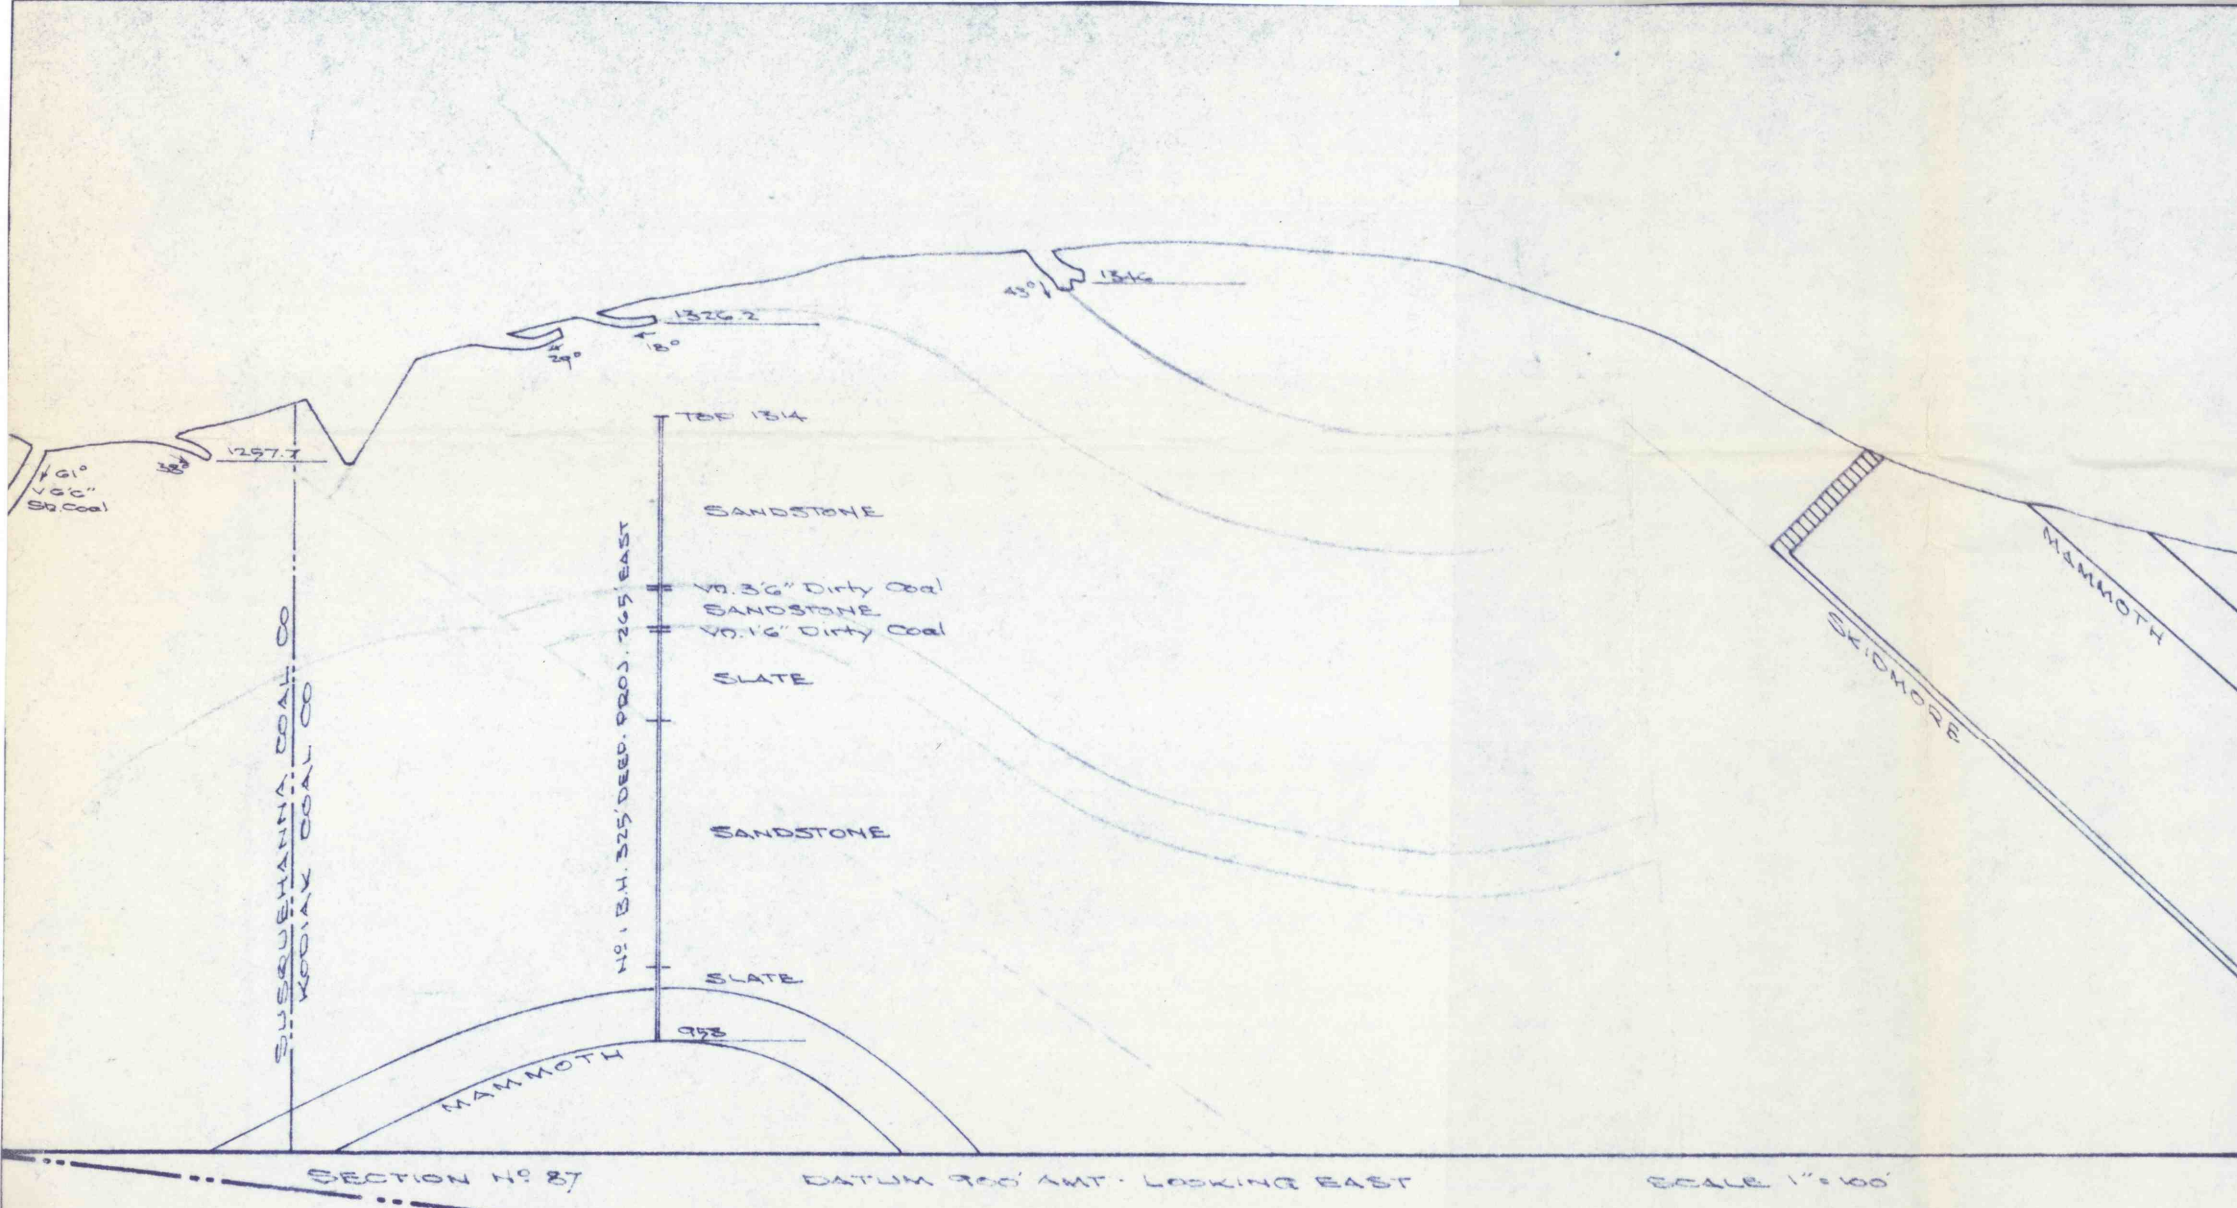

*A.B. Riedel*