


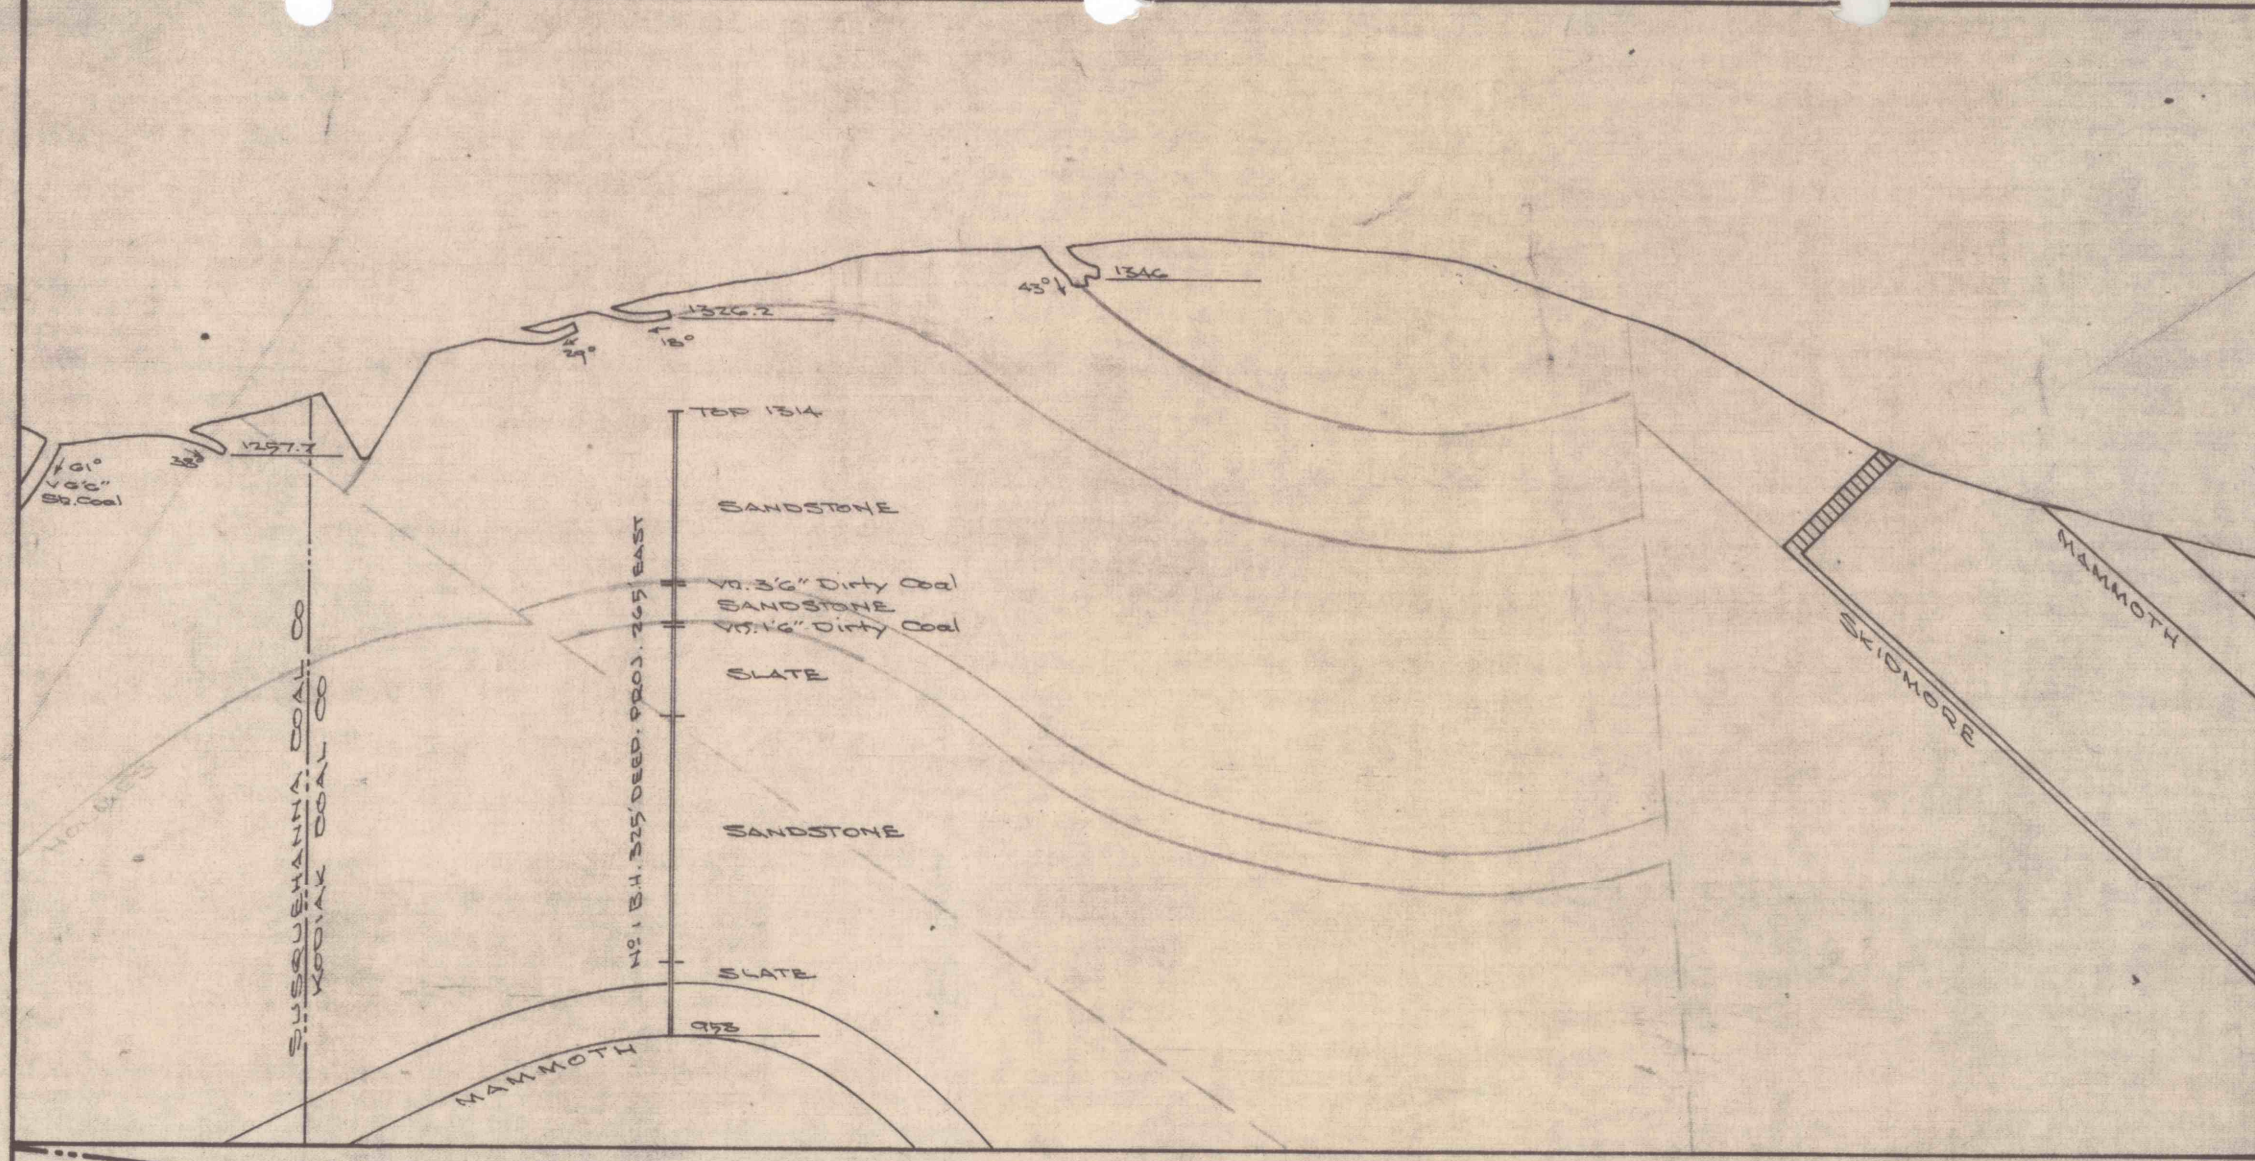

S U S Q U E H A N N A C O A L C O

K O D I A K C O A L C O



*Alfred B. Riedel*