



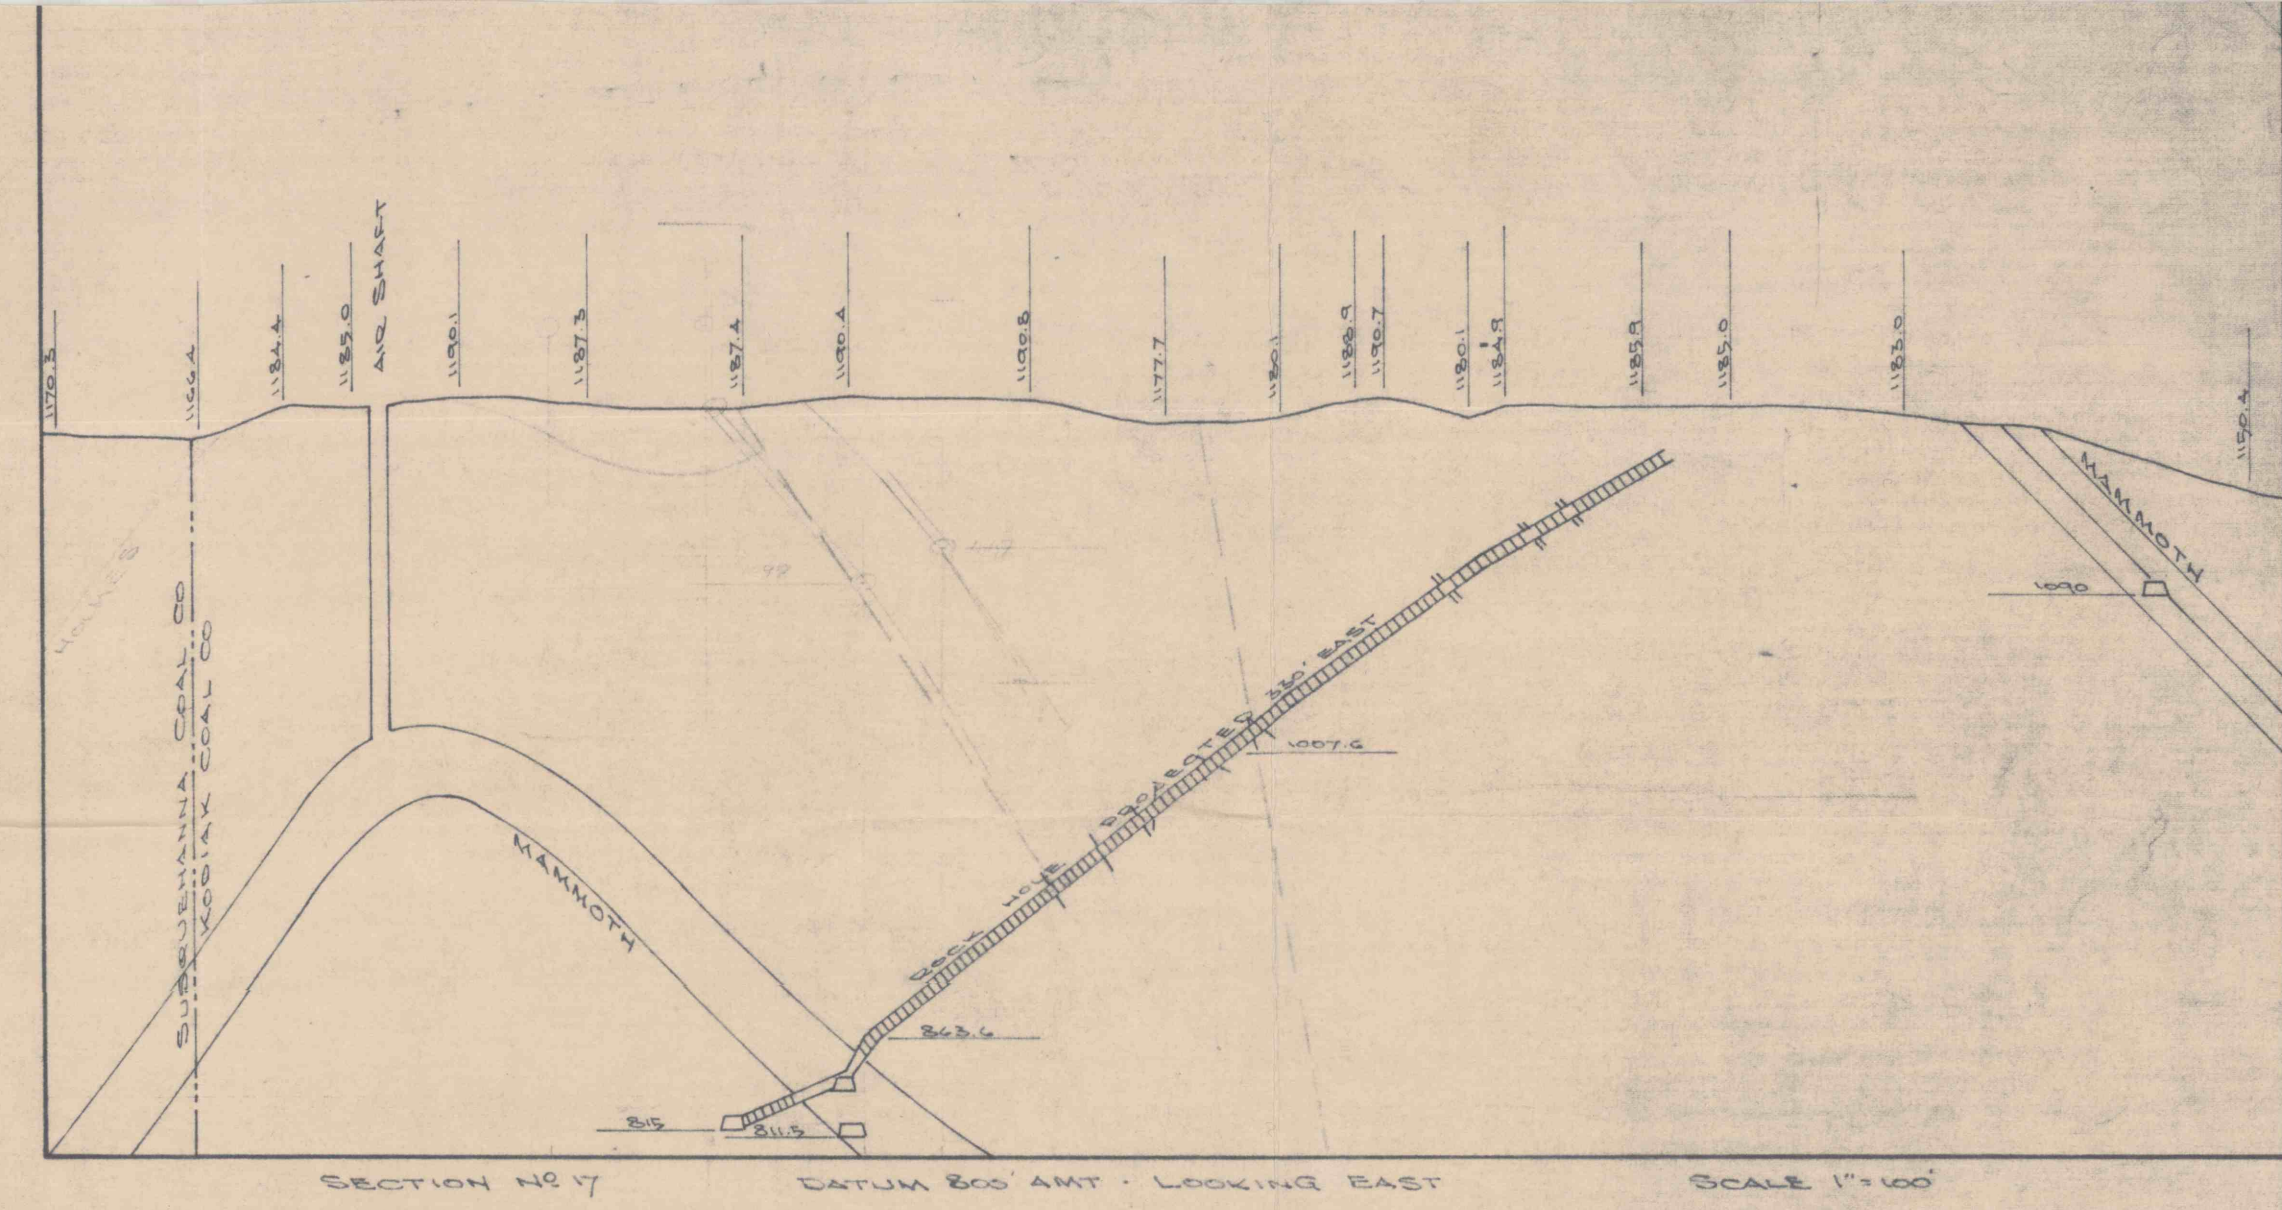

S U S Q U E H A N N A C O A L C O

K O D I A K C O A L C O

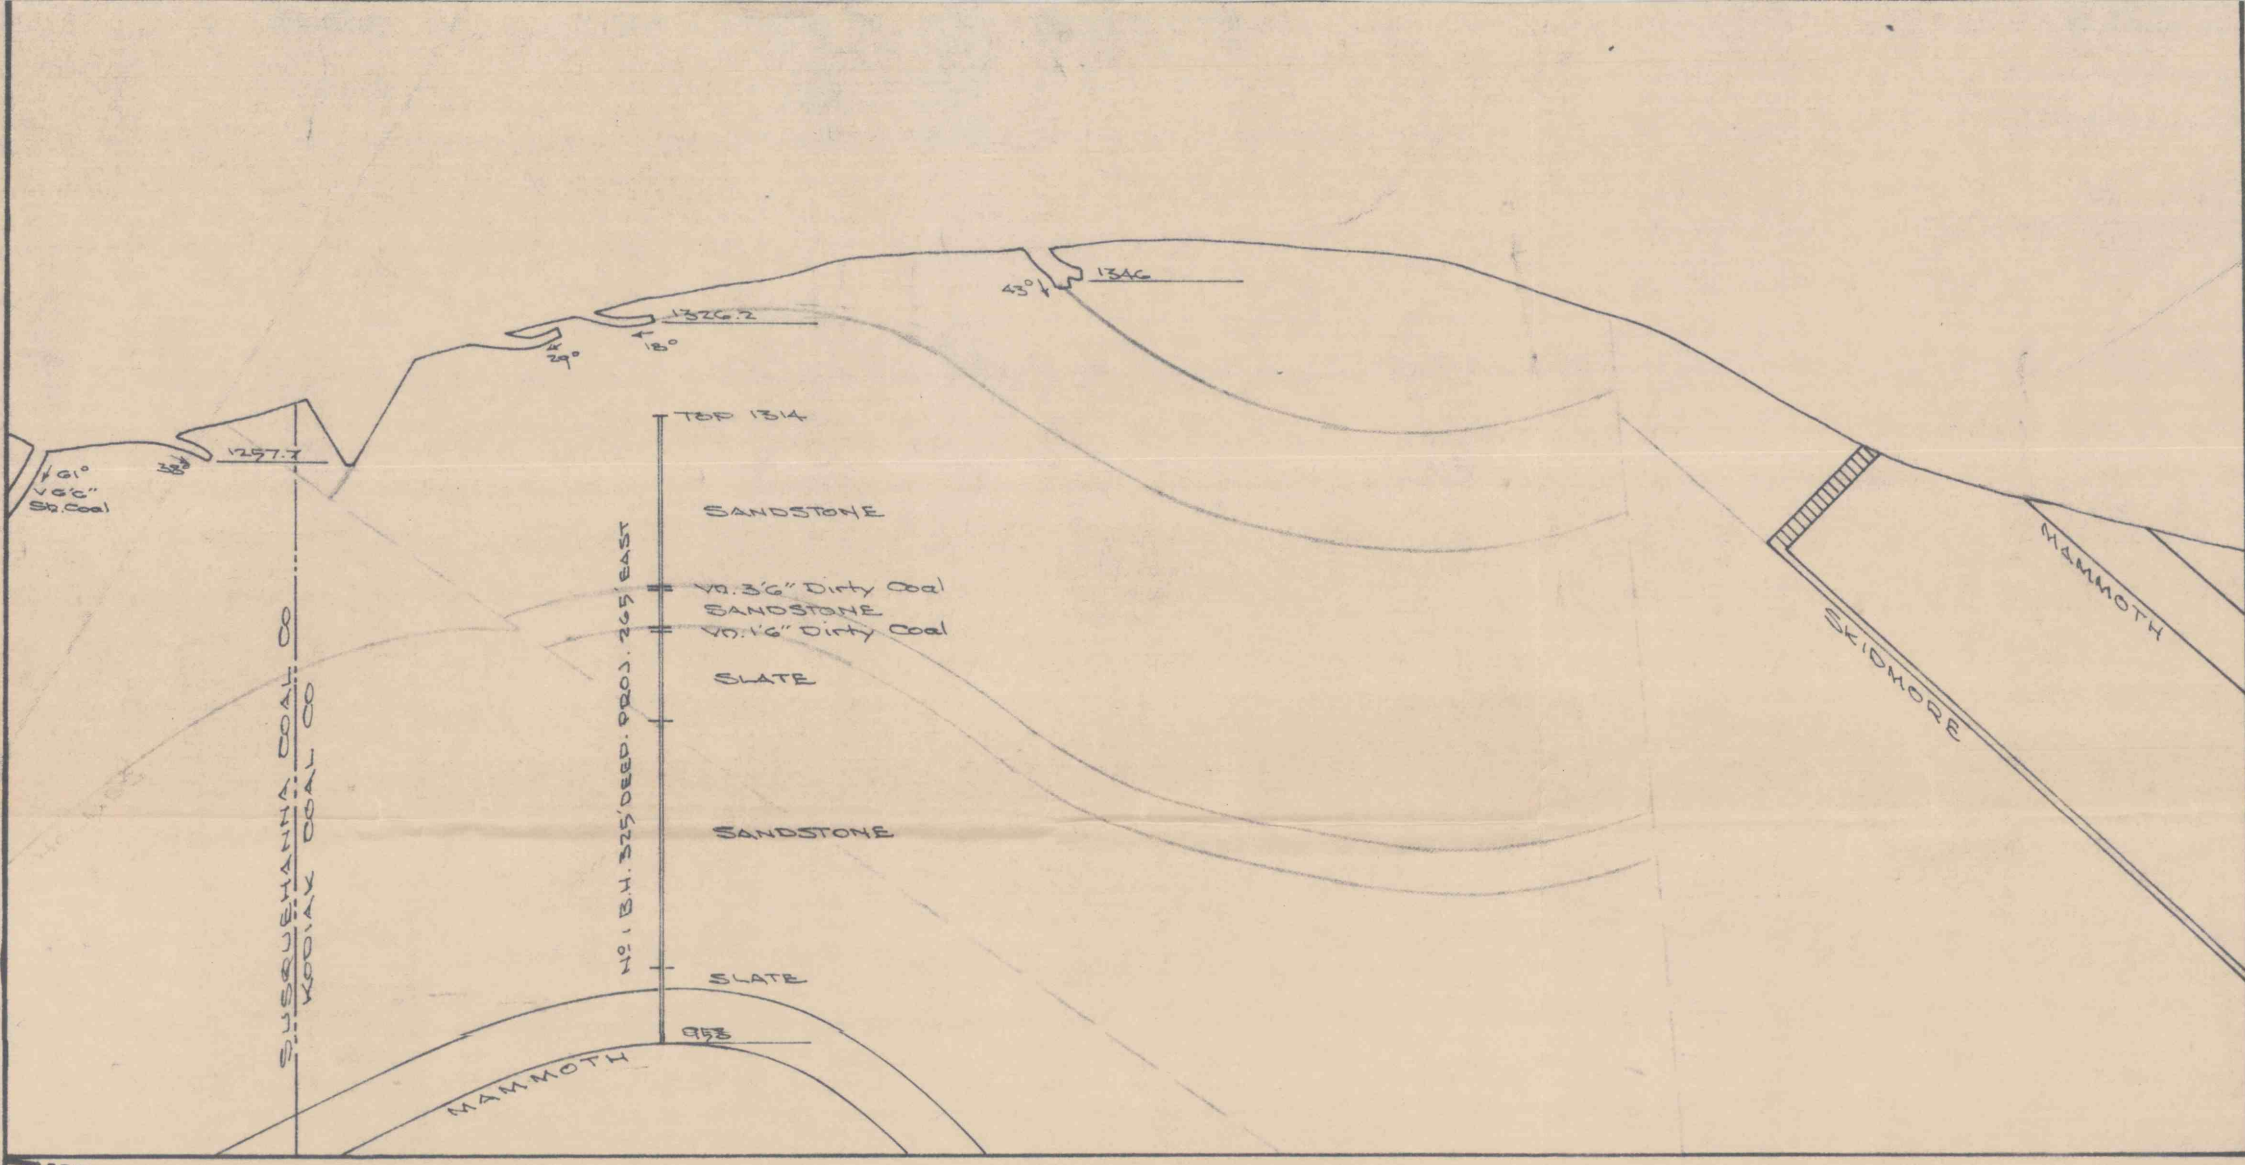

MINE MAP
Showing the location and extent of development of the Zakrewsky #3 Slope Mine. Situate on the South dip Holmes Vein, Conyngham Twp., Columbia County, Pa.
A.B. Riedel, P.E.
Aug. 29, 1980
Scale 1"=100'

A.B. Riedel