


NORTH MOUNTAIN COAL CO.
 NORTHUMBERLAND COUNTY
 COAL TOWNSHIP
 WILLIAM BRADY TRACT
 NO. 2 VEIN

NOTE:
 Points A and B taken
 from ROAD SURVEY dated 10-30-76.

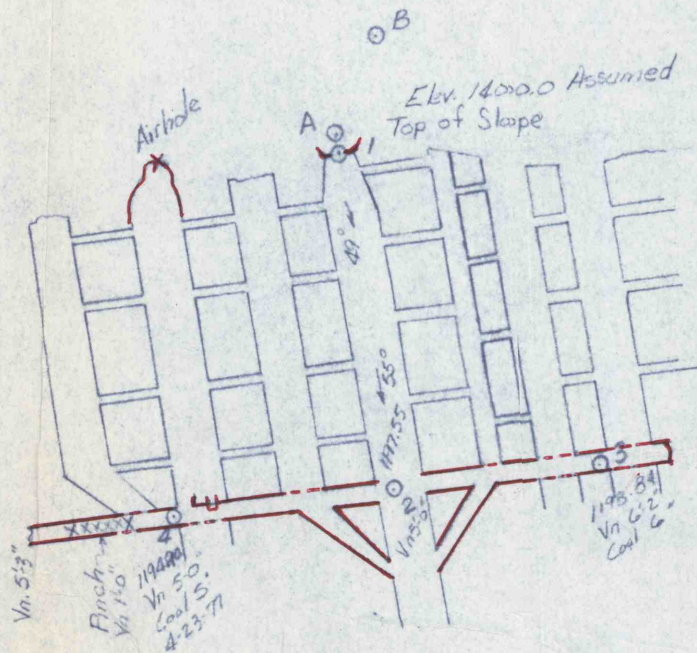

BLUE: Old workings of
 Glen Burn Colliery (Cameron)

RED: New workings of
 North Mountain Coal Co.



PREPARED BY:
 BENJAMIN D. ROCUSKIE, PE
 APRIL 23, 1977