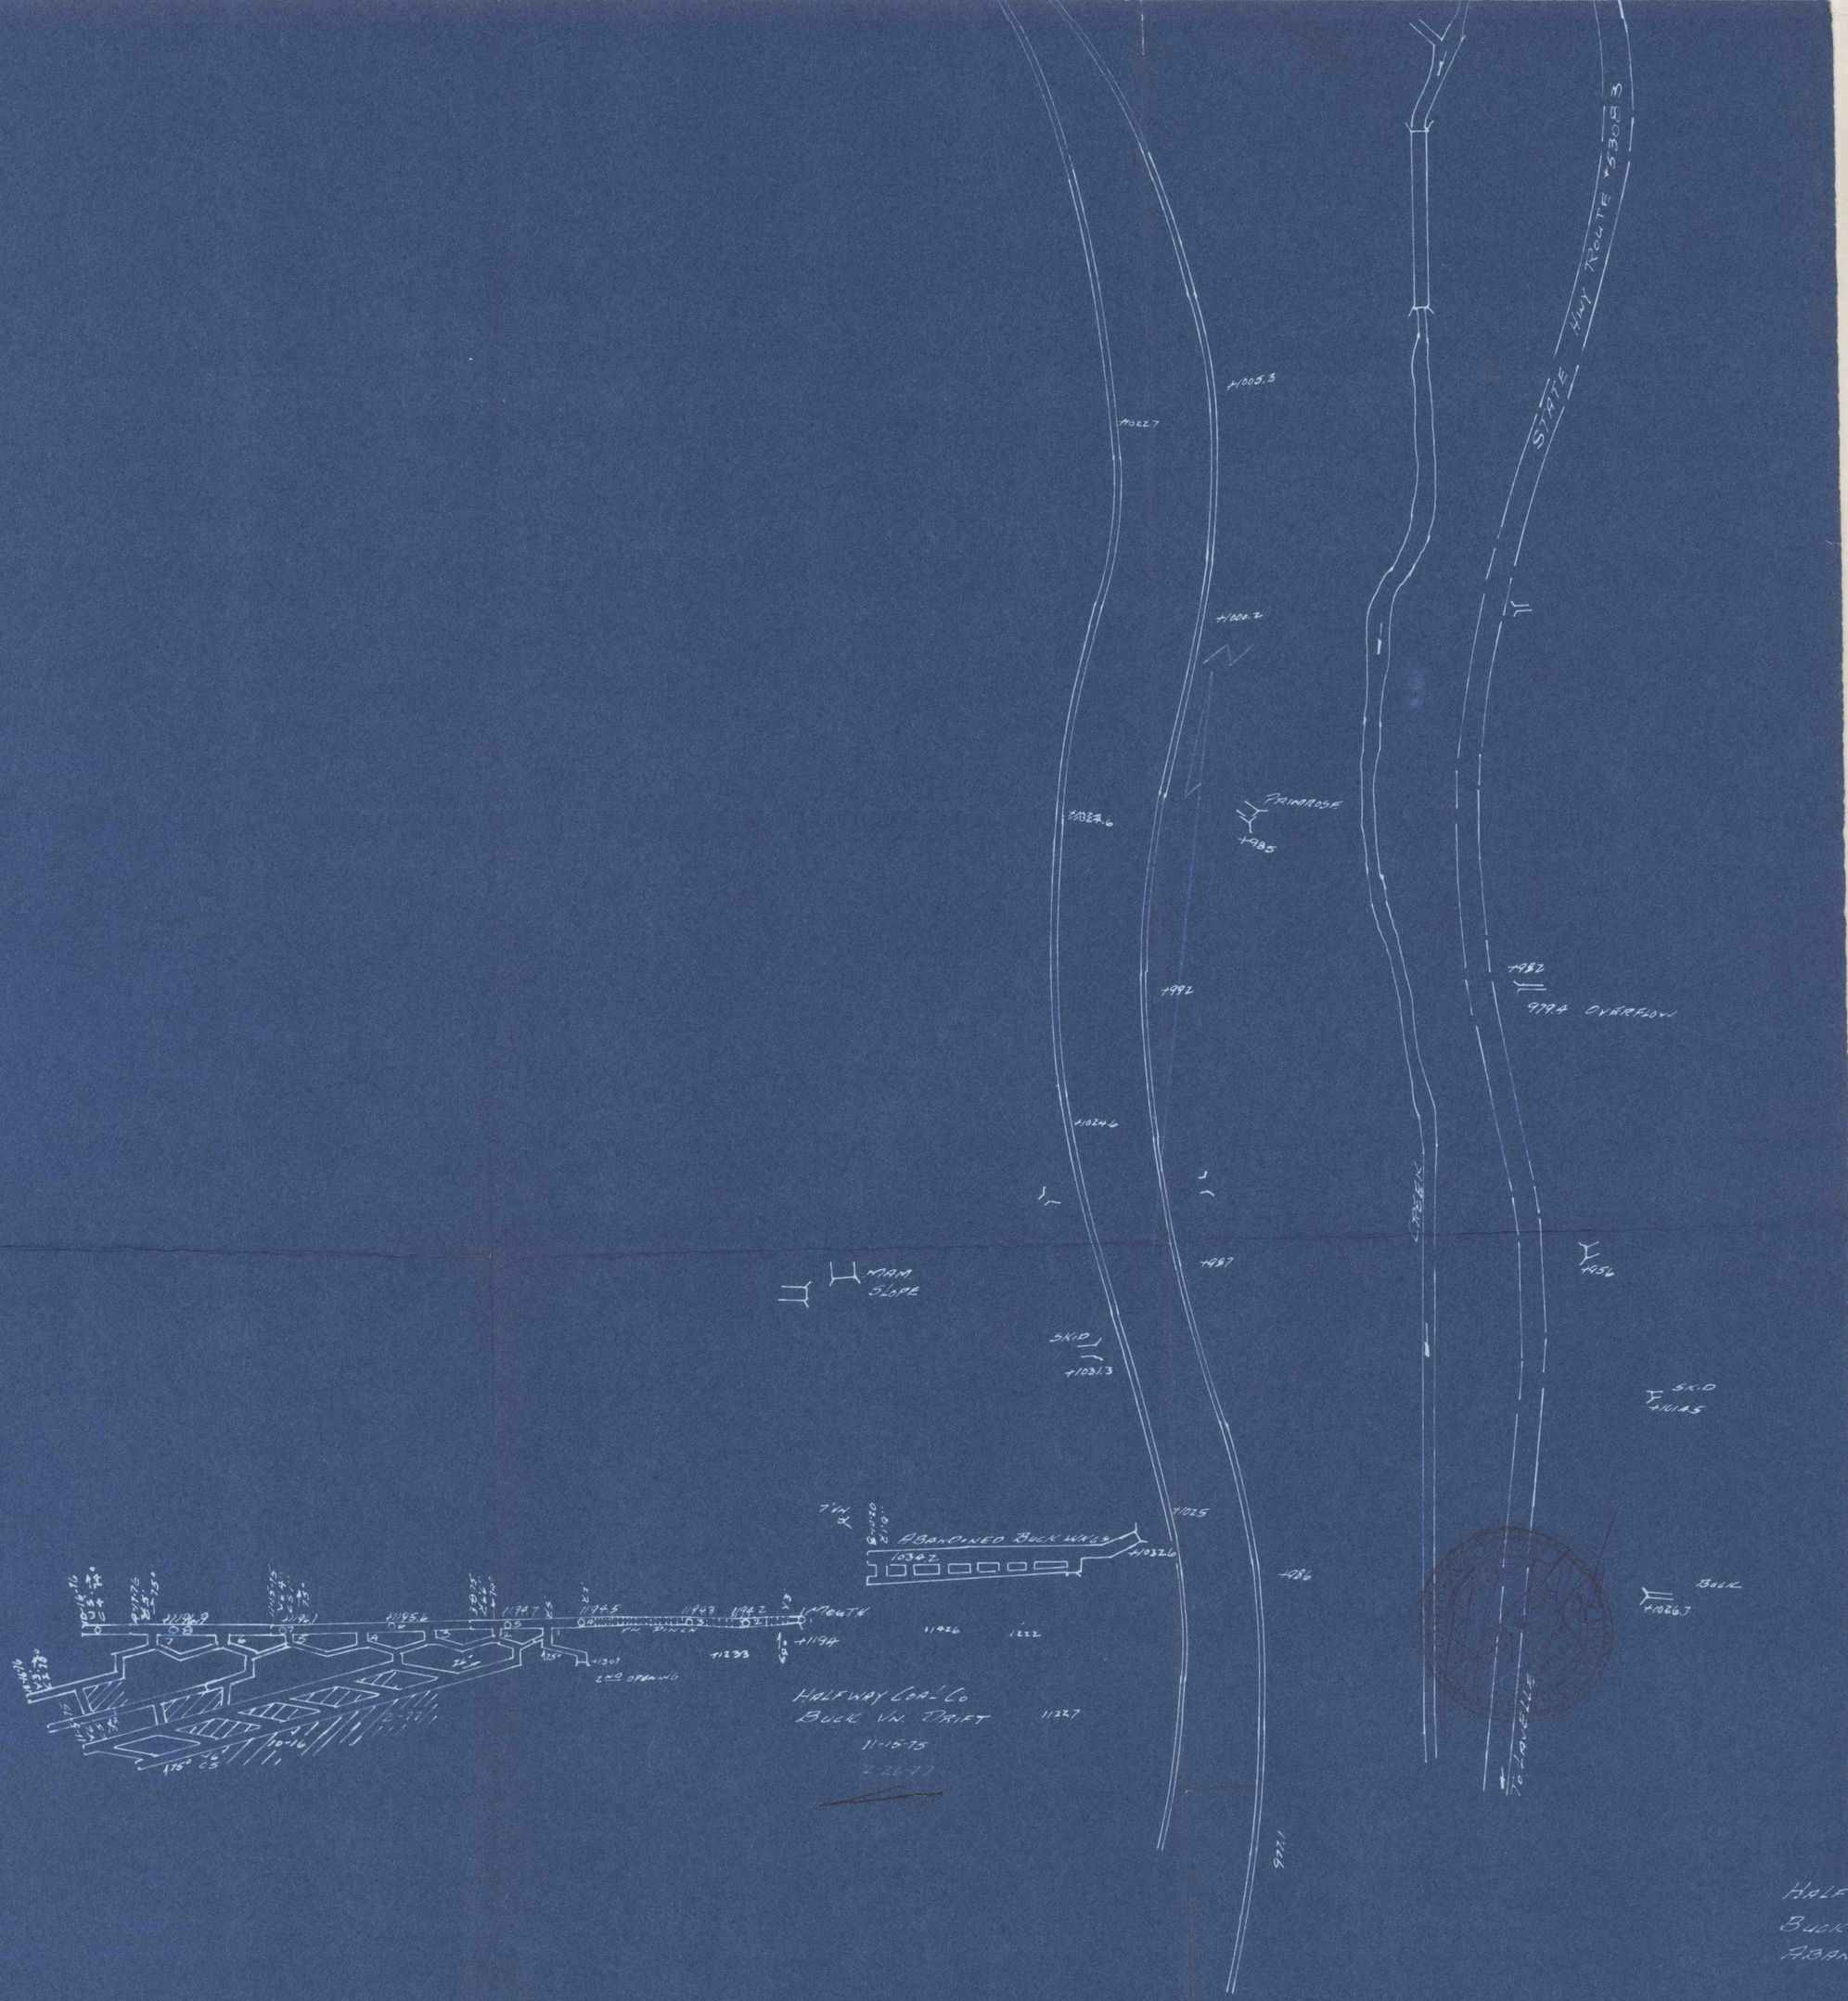
STATE HWY ROUTE #3098
+1005.3
+1022.7
+1000.7
+1034.6
PRIMROSE
+983
+992
+982
979.4 OVERFLOW
+1024.6
+987
MAM. SLOPE
SKID
+1031.3
+956
SKID
+1018.5
+1025
ABANDONED BUCK WALLS
+1034.7
+1032.6
+986
BUCK
+1026.7
+1194
+1233
+1301
2ND OPENING
HALFWAY COAL CO
BUCK VN. DRIFT
11-15-75
TO LAVELLE
11226
1222
11227
1226