

PETER PETERY TRACT

TYPICAL SECTION THRU
A&D COAL CO. SLOPE
SCALE 1"=100'-0"

TYPICAL SECTION THRU
K&L COAL CO. SLOPE
SCALE 1"=100'-0"

MINE MAP SCALE 1"=100'-0"

MINE MAP

Showing the location and extent of development of A&D COAL CO. slope mine
SITUATED ON THE SOUTH DIP OF #0 VEIN, AND IN THE BIG MOUNTAIN SECTION
OF ZERRE TWP NORTHUMBERLAND CO. PA. JAN 7, 1985

Showing the location and extent of development of K&L COAL CO.
SITUATED ON THE SOUTH DIP OF #0 VEIN, AND IN THE BIG MOUNTAIN SECTION
OF ZERRE TWP NORTHUMBERLAND CO. PA. JAN 7, 1985


THOMAS GRANT TRACT

THOMAS HAMILTON TRACT

TREVORTON ESTATE TRACT

LEGEND

RETURN AIR	— —
STOPPING	— —
INTAKE AIR	— —
ESCAPEWAY	— —
STATION	— —
ALL ADVANCEMENT SHOW AS OF JAN. 1985	
ROBBED	— —
OVERCAST	— —

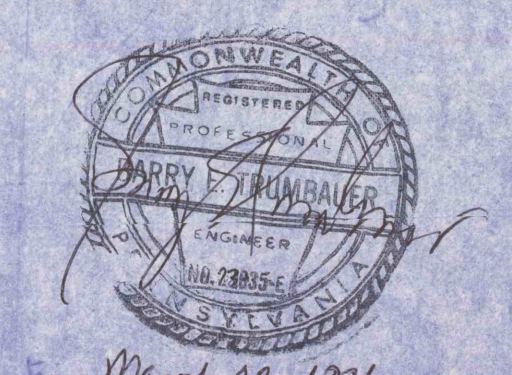

K. & L. COAL COMPANY
R.D. #1, BOX 266
SHAMOKIN PA. 17872
NO. 1 SLOPE ID 36 06649

OWNER: MR. LAMAR A. LENIG R. D. #1, BOX 266 SHAMOKIN PA. 17872 (717) 797-4545

DEC '85
JAN 1-1990
DEC 12-1990

0-169 1649