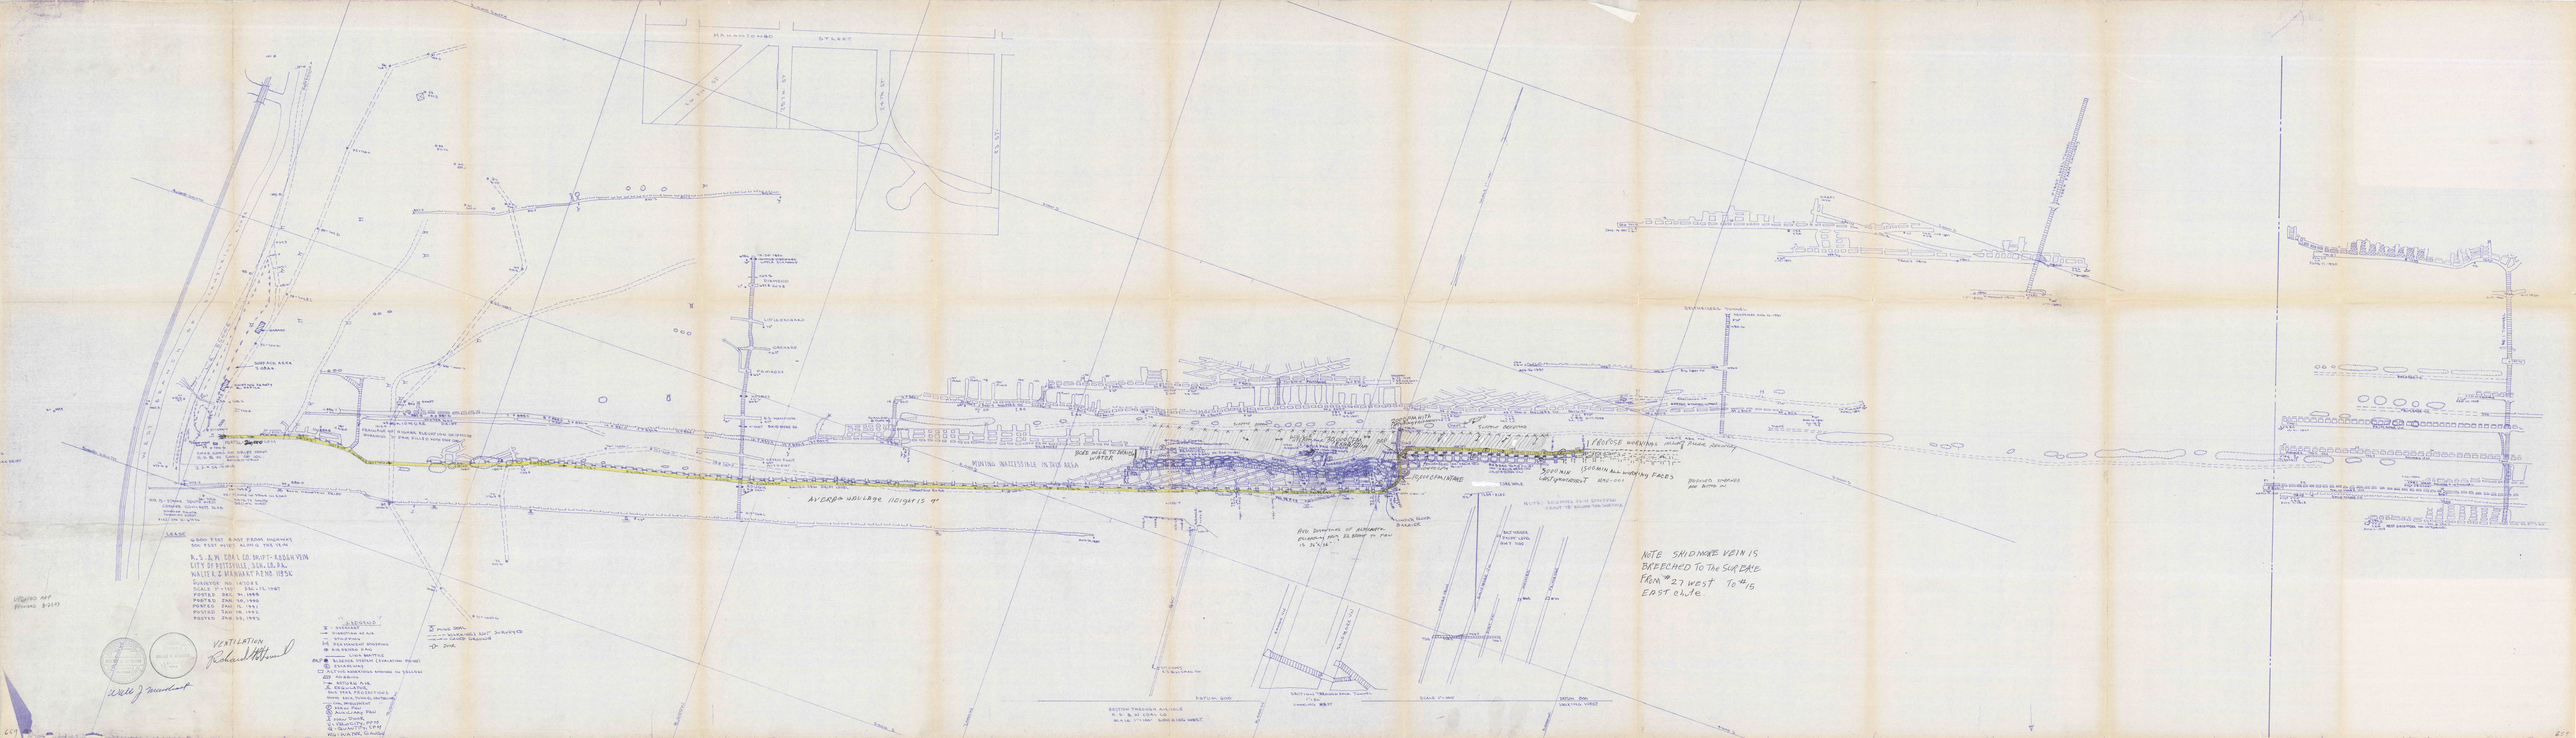
MAHANTONGO STREET
AVERAGE HEADAGE HEIGHTS 4'
MINING INACCESSIBLE IN THIS AREA
PROPOSED WORKINGS MIDDLE PARK SECTION
NOTE SKIDMORE VEIN IS BREECHED TO THE SURFACE FROM #27 WEST TO #15 EAST GATE.
SECTION THROUGH ADJACENT N. S. & W. COAL CO.
SCALE 1" = 100'
SURVEYED IN 1896 WEST
DATUM 500
SCALE 1" = 100'
DATUM 500
UNSURVEYED WEST
LEGEND
GRID BEAR EAST FROM BUCHANAN
500 EAST PARES ALONG 0. 1195 SPLIT
R. S. & W. COAL CO. SKIDT-KOBAN VEIN
CITY OF POTTSVILLE, SCH. CO. PA.
WALTER R. & MARGARET A. NO. 1195K
SURVEYOR NO. 14 CHIEF
SCALE 1" = 100' 300-15, 1947
PLOTTED JAN 20, 1948
VENTILATION
Richard Hatford
LEGEND
SURFACE
DIRECTION OF AIR
STOPPING
PERMANENT STOPPING
MAIN CROSS CUT
MAIN CROSS CUT WITH TROLLEY
BENCH MARK (ELEVATION FEET)
ACTIVE WORKINGS MINING IN SEAM
PILLARING
