


1995
VENT MAP
Richard J. McManhart
VENTILATION

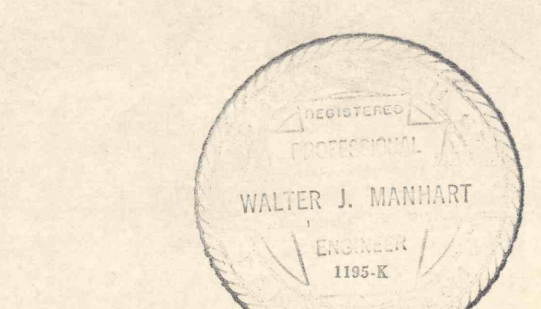


LEAD
6000 FEET EAST FROM HIGHWAY
500 FEET WIDE ALONG THE VEIN
R. S. & N. COAL CO. DRIFT-KODGE VEIN
CITY OF PITTSVILLE, SCH. CO. PA.
WALTER J. MANHART RENO. 1956
SURVEYOR NO. 14708 E
SCALE 1" = 100' DEC. 12, 1987
POSTED DEC. 31, 1988
POSTED JAN. 20, 1990
POSTED JAN. 15, 1991
POSTED JAN. 18, 1992
POSTED JAN. 10, 1993
POSTED JAN. 2, 1994
POSTED JAN. 28, 1995

- LEGEND
- OVERCAST
 - DIRECTION OF AIR
 - STOPPING
 - PERMANENT STOPPING
 - AIR DRIVEN FAN
 - AIR BATTERY
 - BLEEDER SYSTEM (EVALUATION POINT)
 - CHARGE WAYS
 - ACTING WORKINGS SHOWN IN YELLOW
 - AD DRIFT
 - NATURAL AIR
 - ONE YEAR PROJECTIONS
 - WITH ROCK TUNNEL CONTINUING
 - CHAL. DISCONTINUED

