
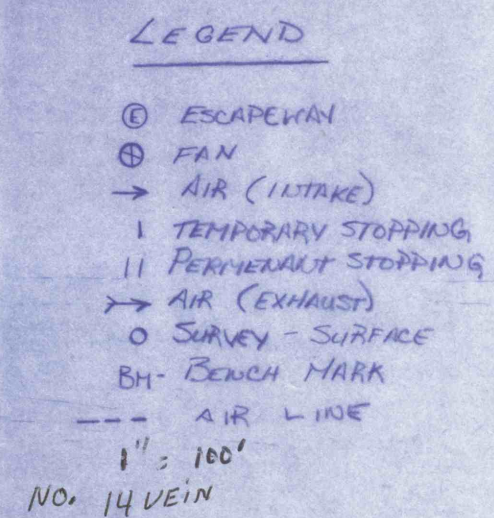


NOTES

1. TIE IN WITH TAG, B.J. TRIPLES, LONE PINE COAL CO. & P-R-C-I PROPERTY
2. VERT. WITH P-R-C-I AND USC+GS
3. STA. CORD. POINTS POSTED AT MINE

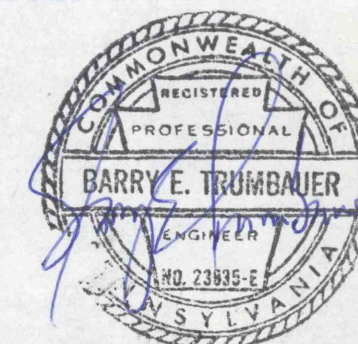

**TAG COAL CO.**  
**No. 14 VEIN**  
**I.D.-36-07018**

ORIGINAL: 3-25-86.  
REVISED: 8-26-87

o OPERATION PLAN MAP FOR TAG COAL CO. NORTHUMBERLAND CO. ZERBE TWP.