



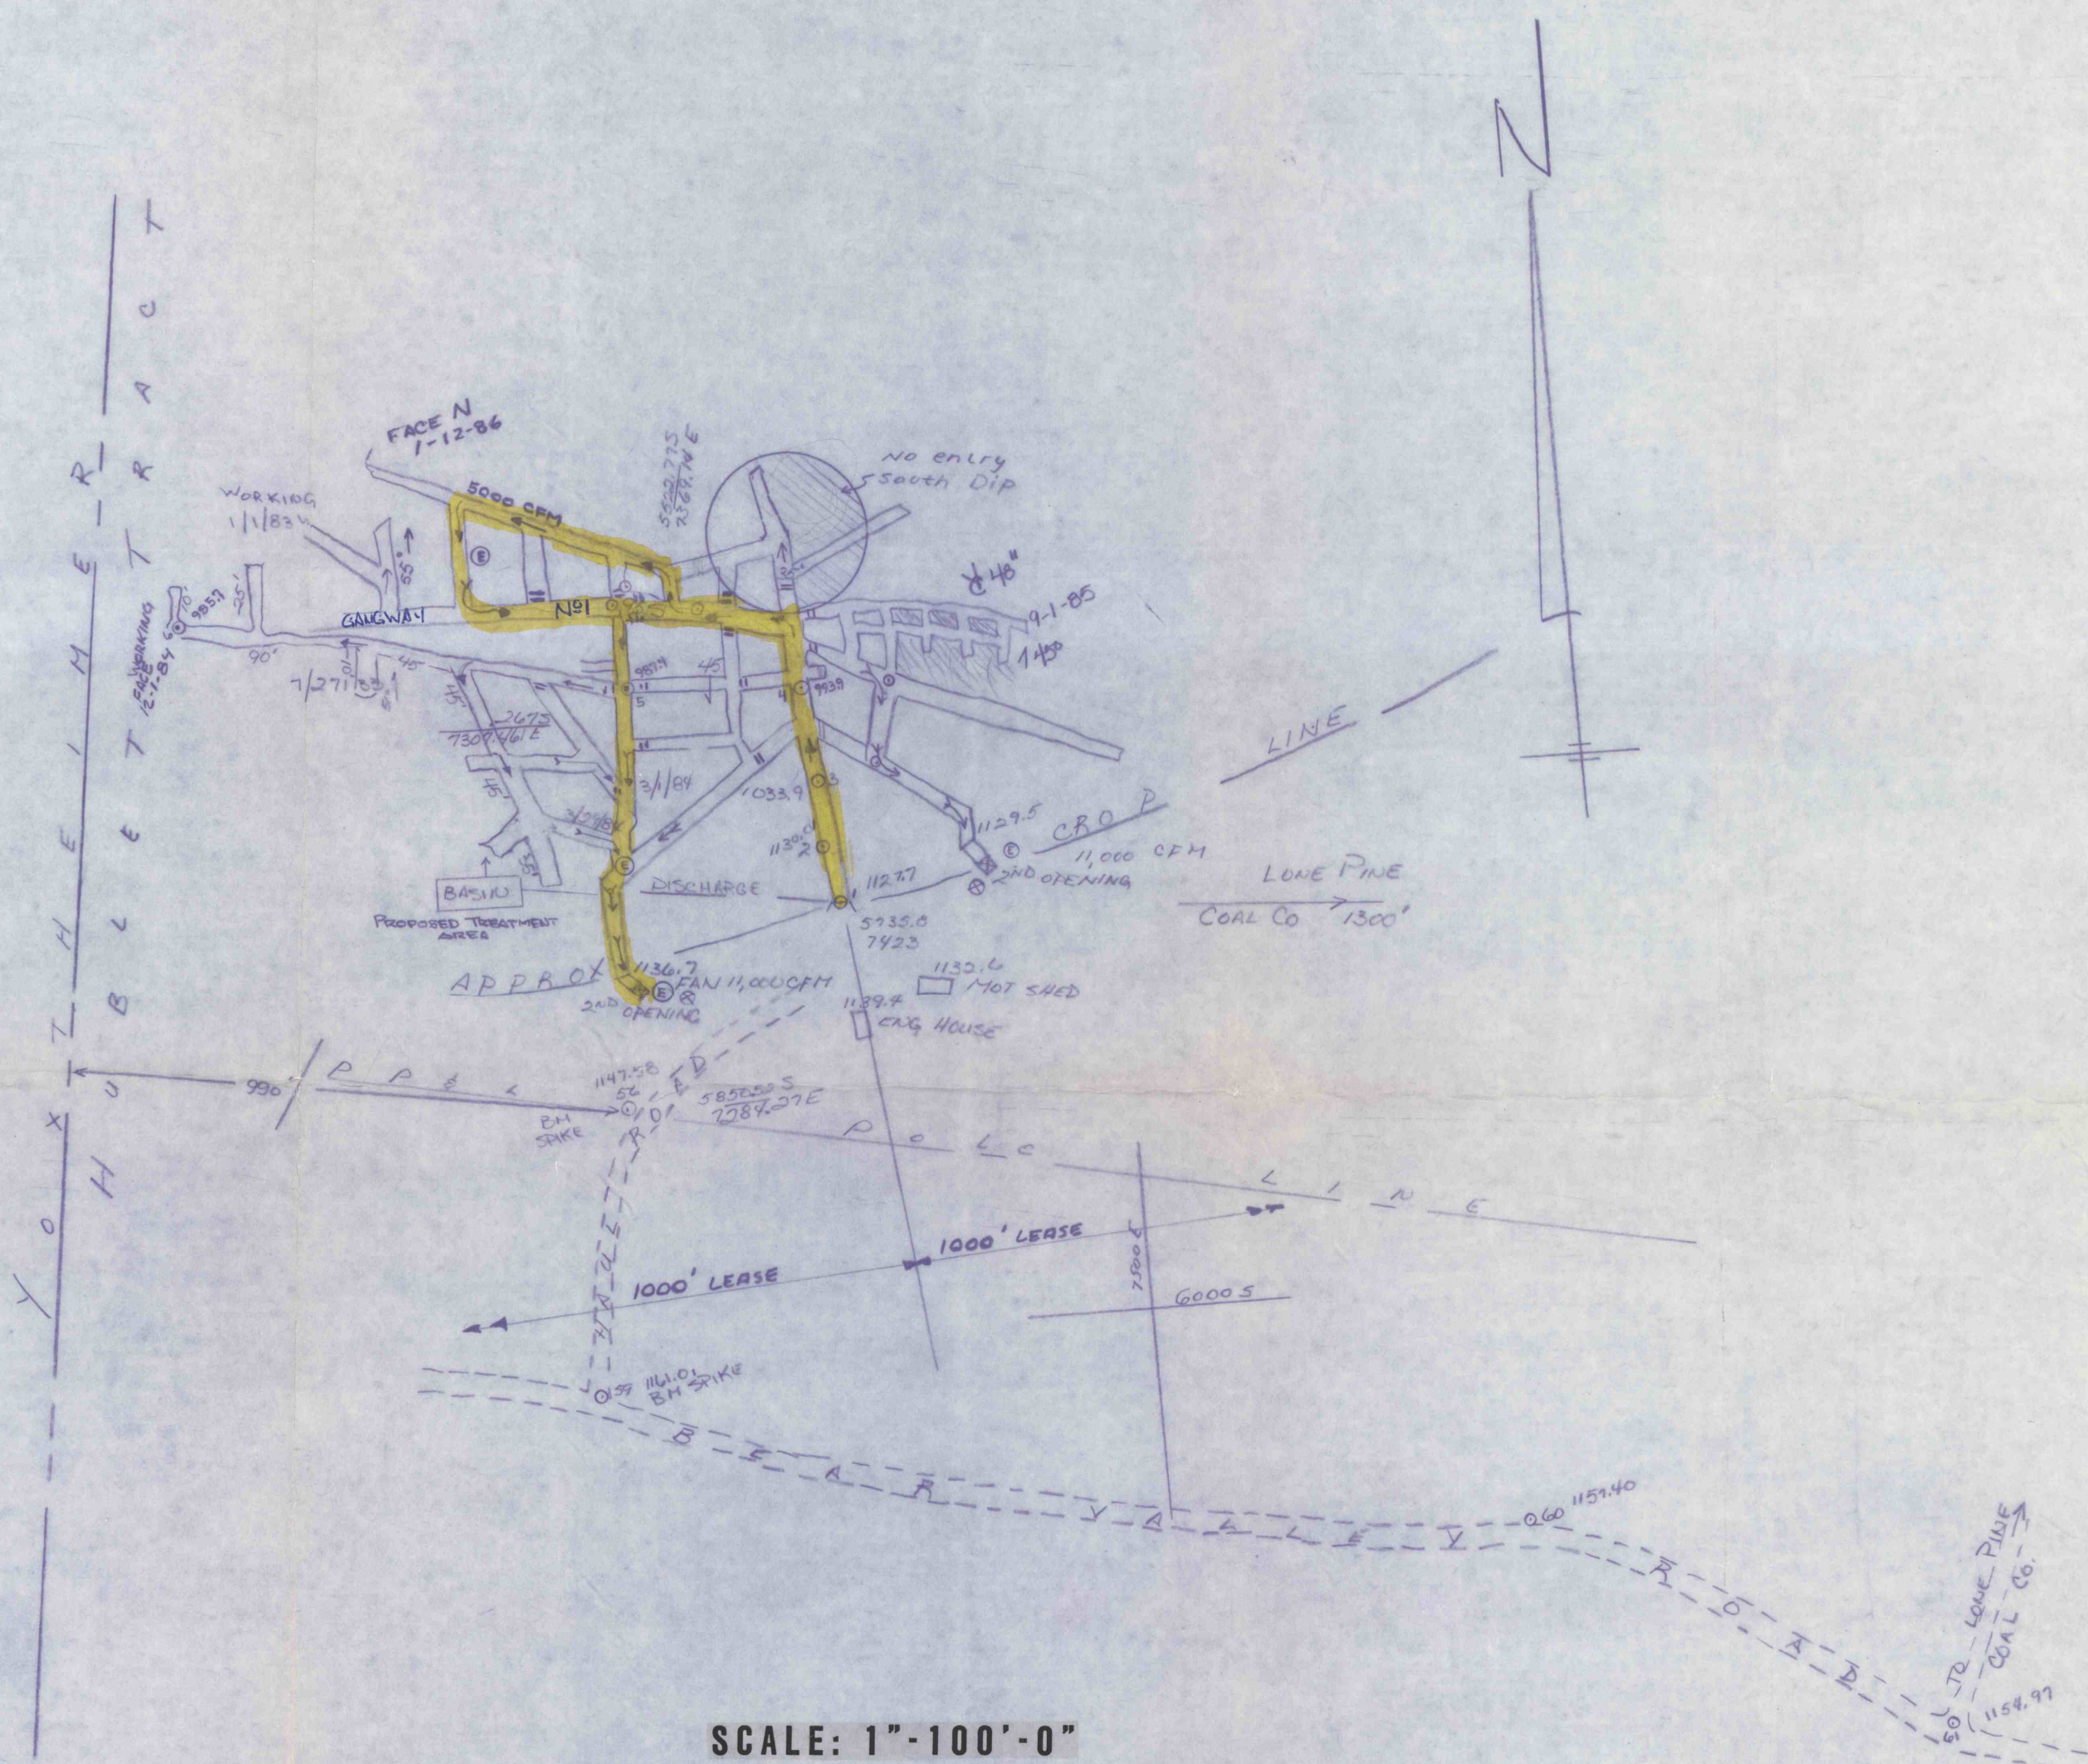


- LEGEND**
- ⊙ ESCAPEWAY
 - ⊕ FAN
 - AIR (INTAKE)
 - I TEMPORARY STOPPING
 - II PERMANENT STOPPING
 - AIR (EXHAUST)
 - SURVEY - SURFACE
 - BH BENCH MARK
 - AIR LINE

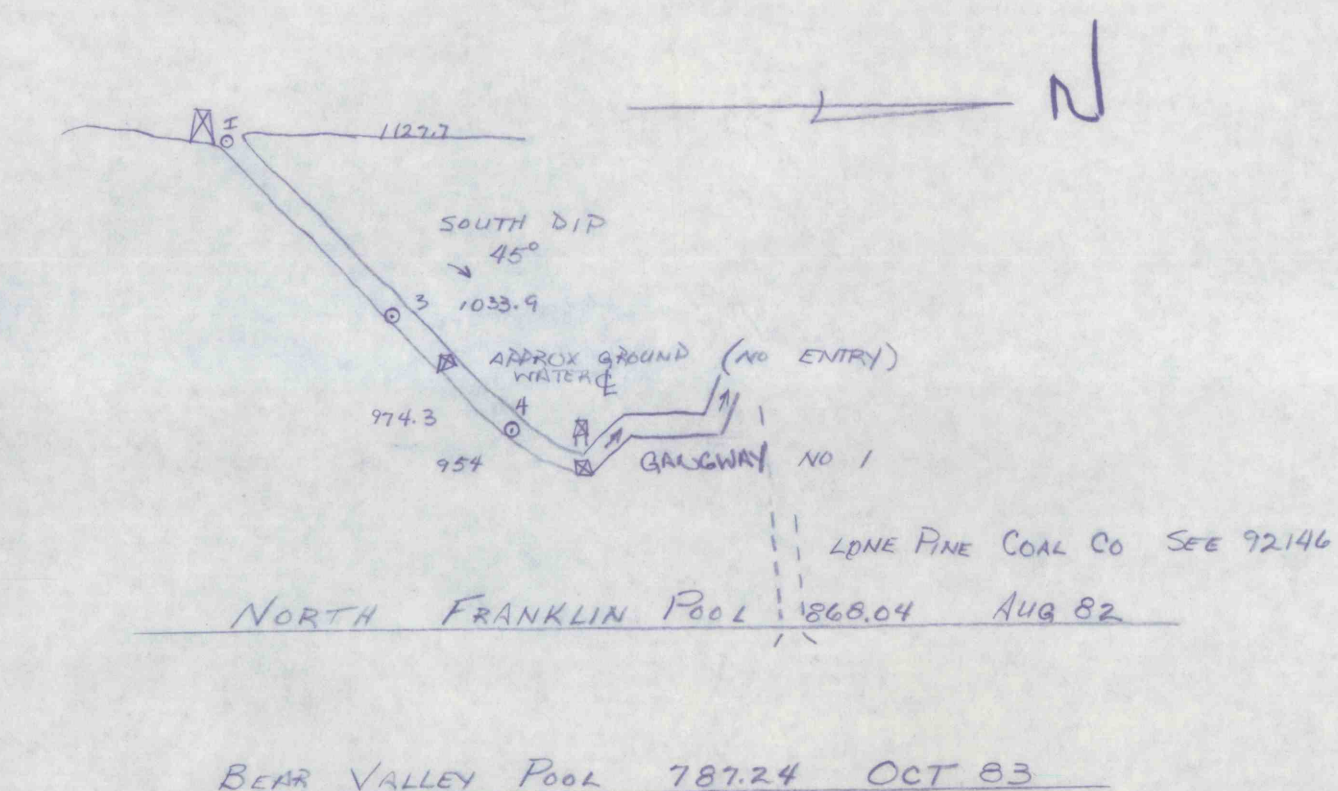

CROSS SECTION
LOOKING WEST THRU VEIN

- NOTES**
1. TIE IN WITH TAG, B.J. TRIPLES, LONE PINE COAL CO. & P.R.C.I. PROPERTY
 2. VERT. WITH P.R.C.I. AND USC+GS
 3. STA. COORD. POINTS POSTED AT MINE

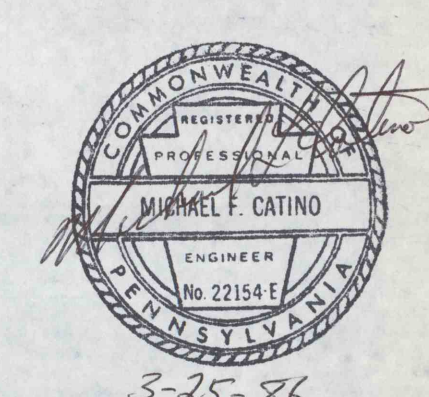

TAG COAL CO.
NR 14 VEIN
ID 36-07018