


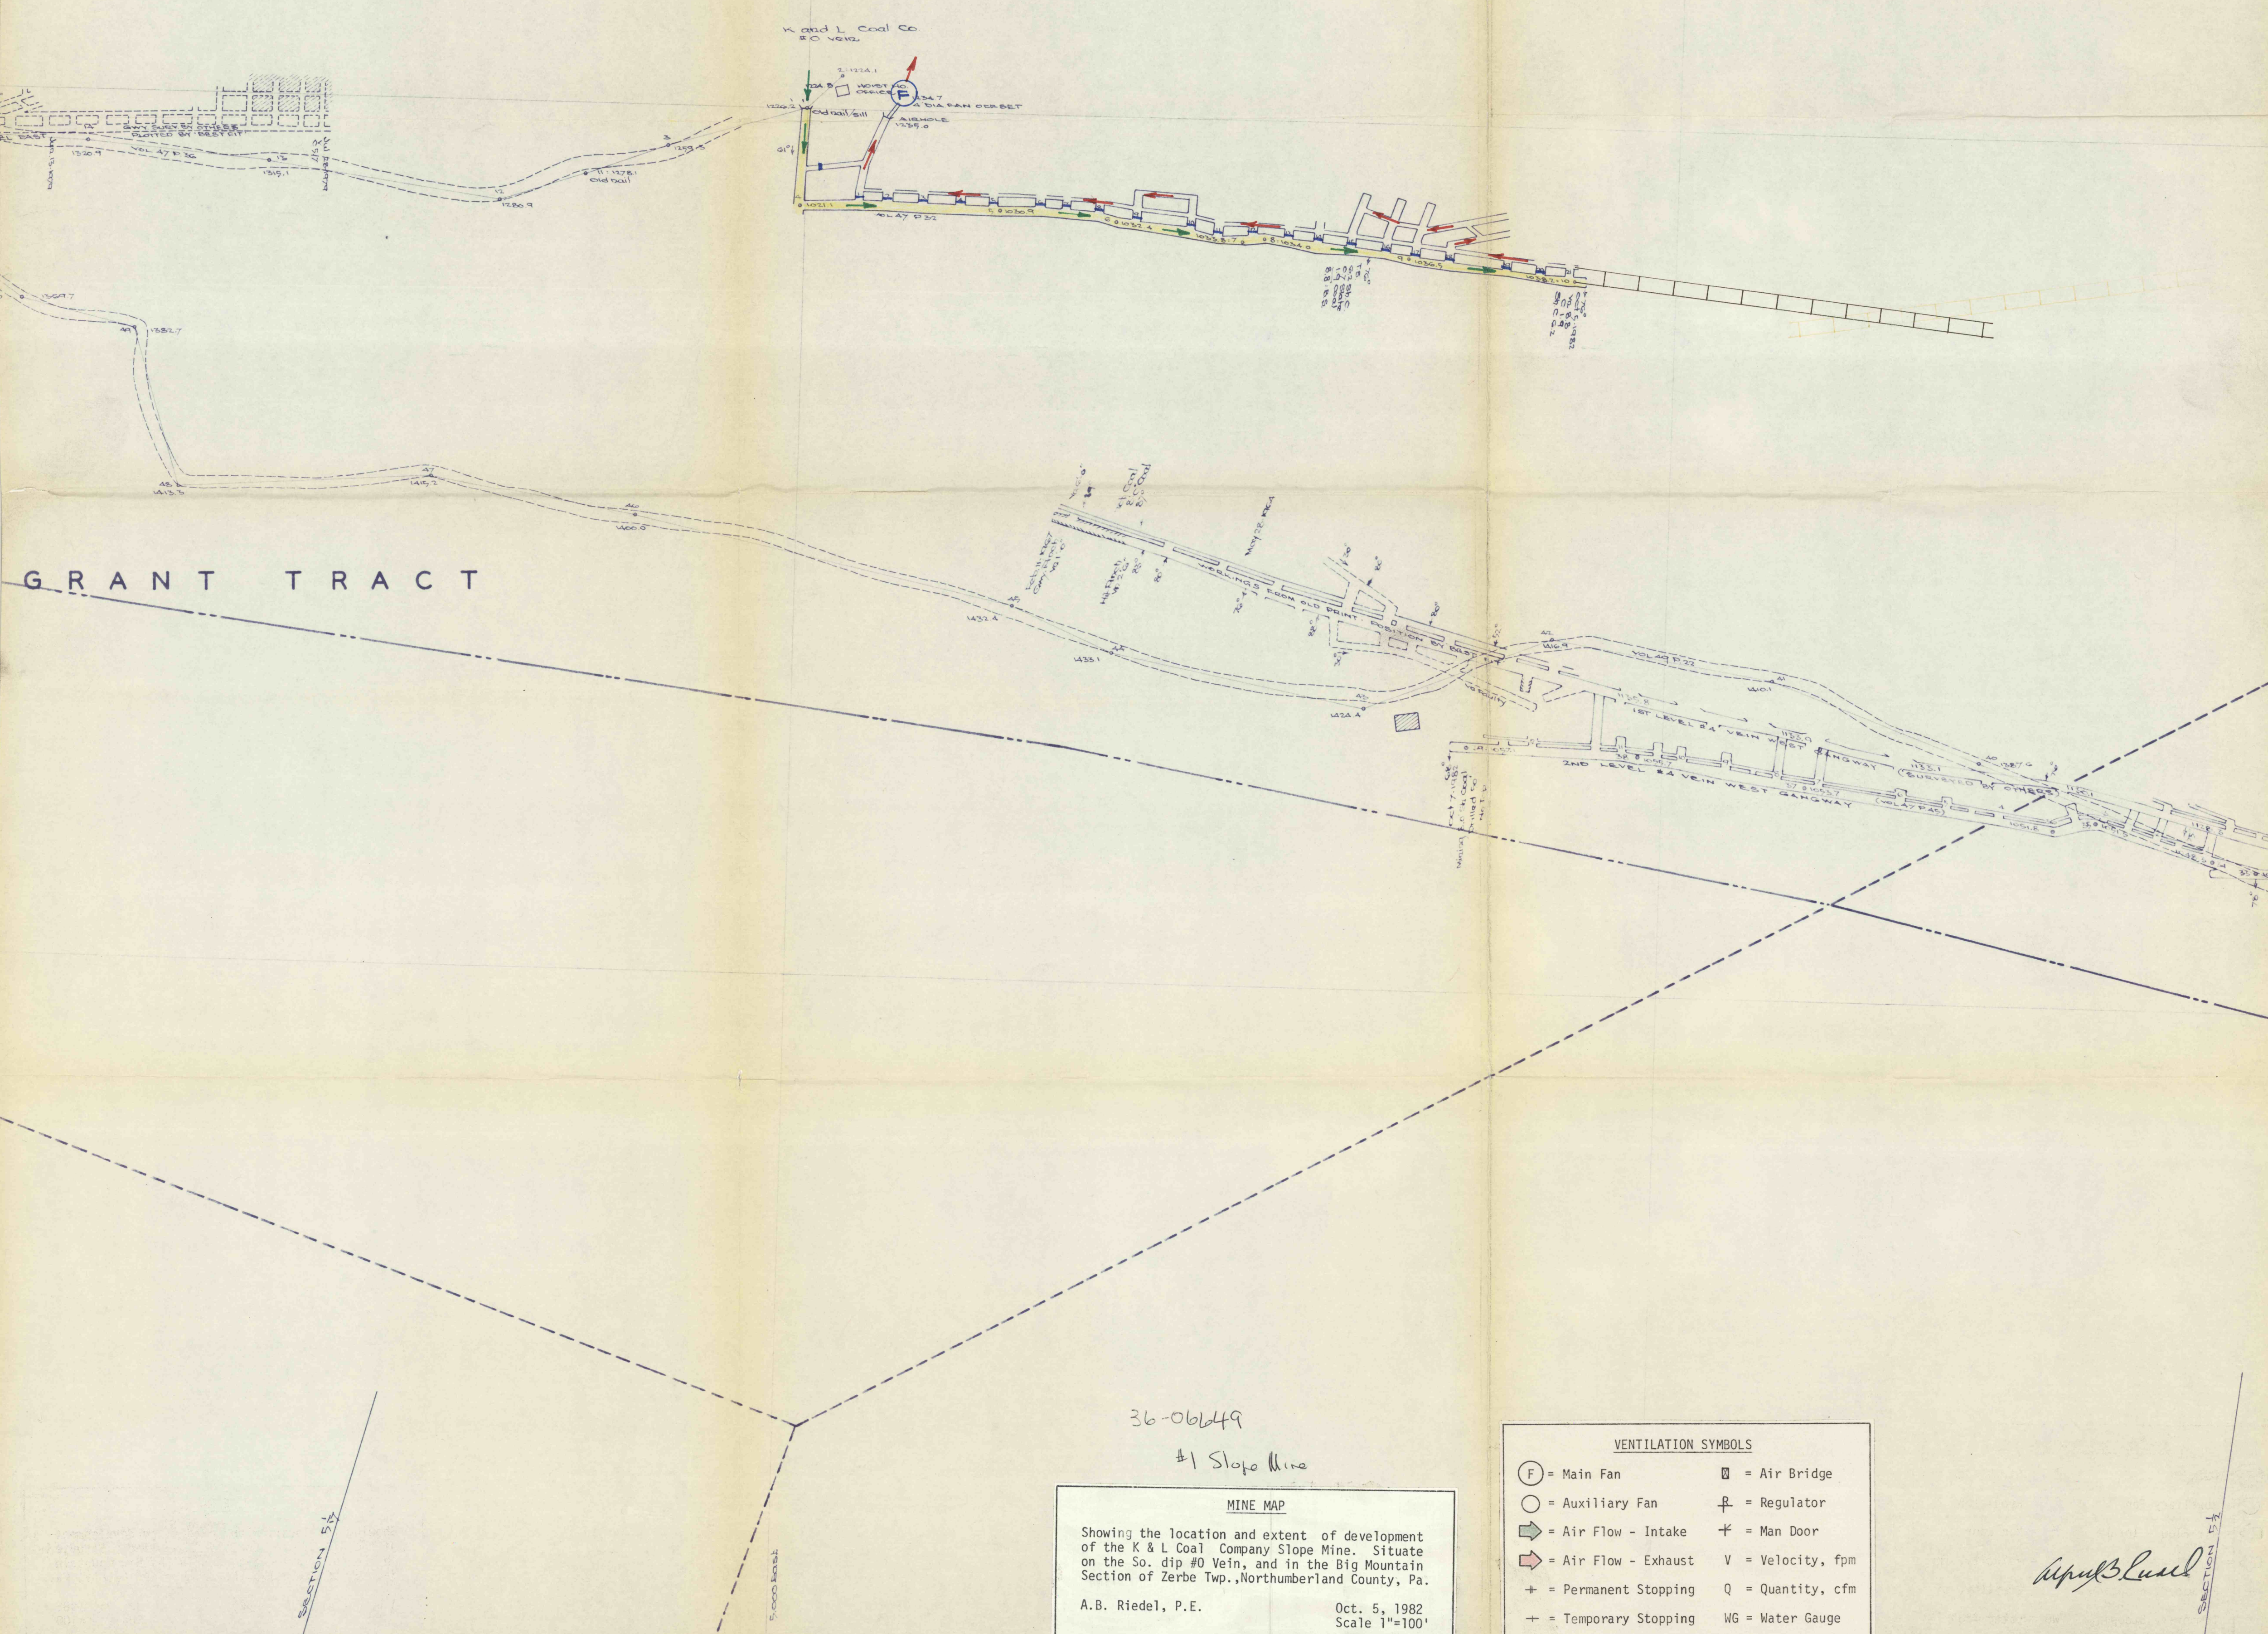

36-06649
#1 Slope Mine

MINE MAP

Showing the location and extent of development of the K & L Coal Company Slope Mine. Situate on the So. dip #0 Vein, and in the Big Mountain Section of Zerbe Twp., Northumberland County, Pa.

A.B. Riedel, P.E.

Oct. 5, 1982
Scale 1"=100'

VENTILATION SYMBOLS

- | | |
|--------------------------|-------------------|
| (F) = Main Fan | [A] = Air Bridge |
| (O) = Auxiliary Fan | [R] = Regulator |
| [>] = Air Flow - Intake | [M] = Man Door |
| [<] = Air Flow - Exhaust | V = Velocity, fpm |
| + | Q = Quantity, cfm |
| + | WG = Water Gauge |

Handwritten signature: Riedel