


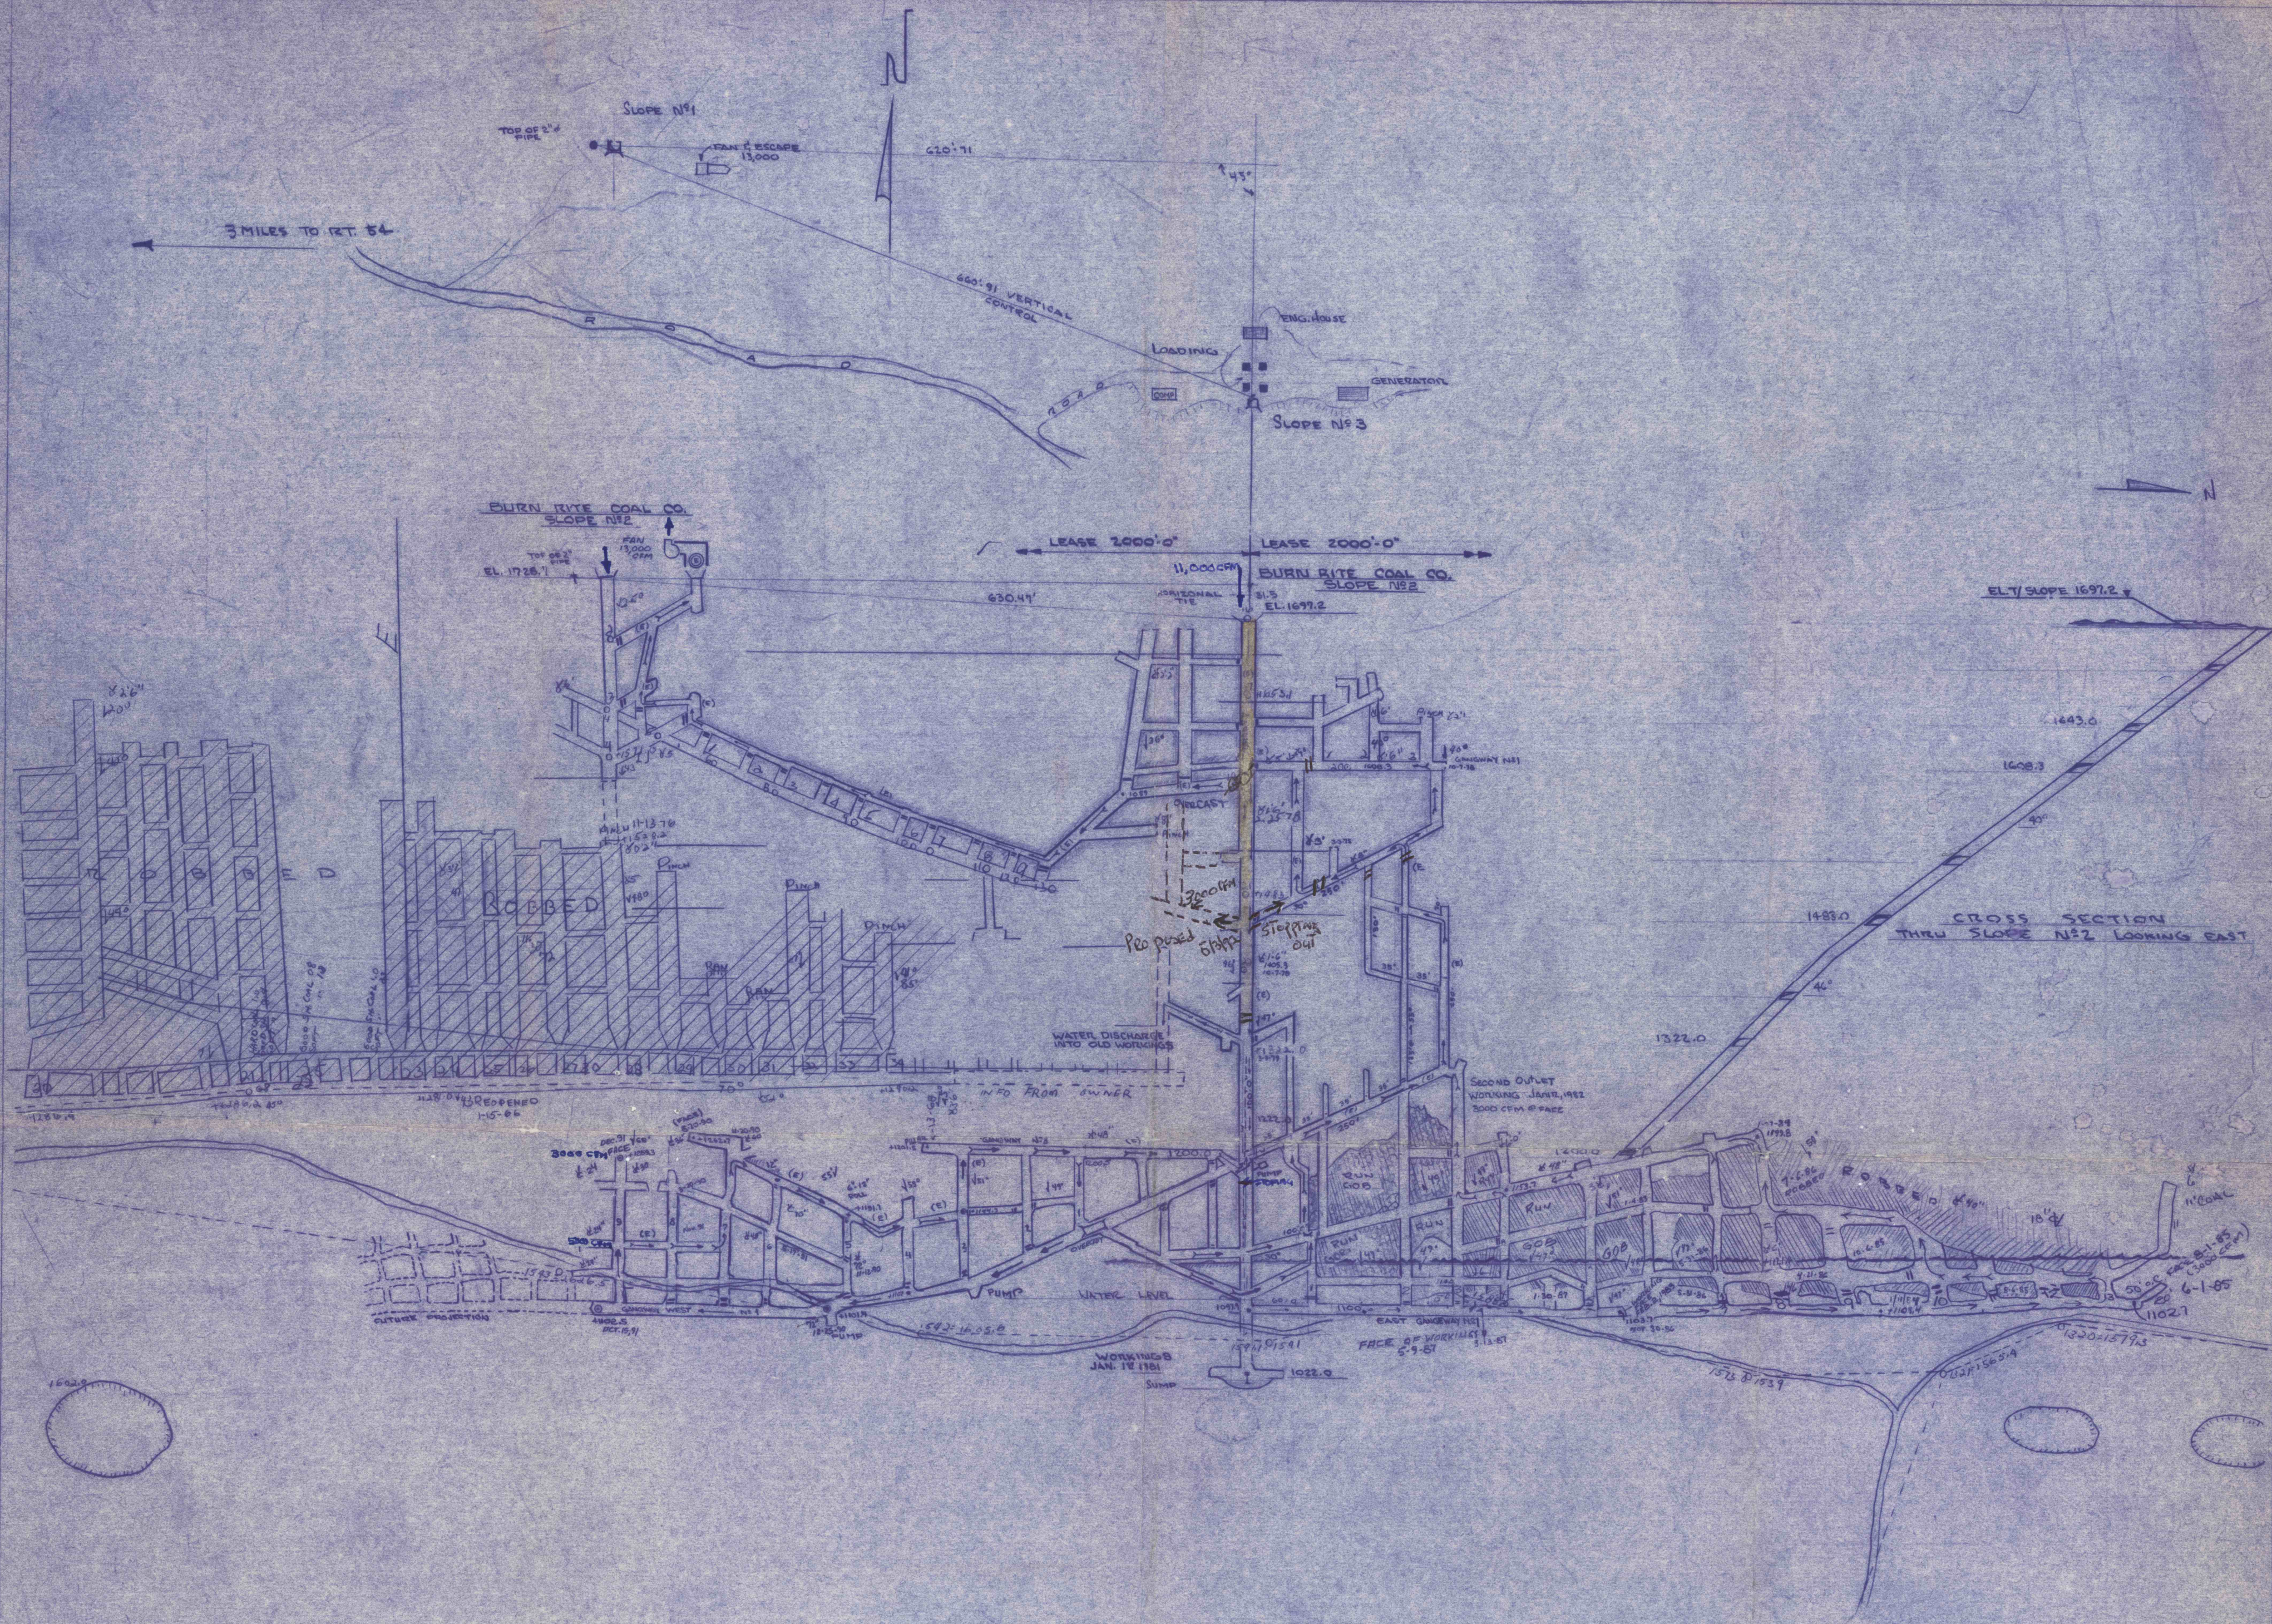

LEGEND	
	SUPPLY AIR
	RETURN AIR
	MAIN FAN
	PERMANENT STOPPING
	TEMPORARY STOPPING
	BITASTIC OR CANVAS
	ESCAPE RETURN AIR
	SWITCH BOX
	WATER
	PUMP
	OVERCAST
	ACTIVE WORKING

15 April 1992
13 December 1991

OPERATION PLAN MAP

BURN RITE COAL CO.

No. 3 SLOPE ID 36-06453

LYKINS VEIN SCALE: 1"=100'-0"

NATHANIEL BROWN TRACT

WILBURTON TWP.

COLUMBIA CO.

OCT. 1988
APR. 1989

DEC. 1990

N° C-100