


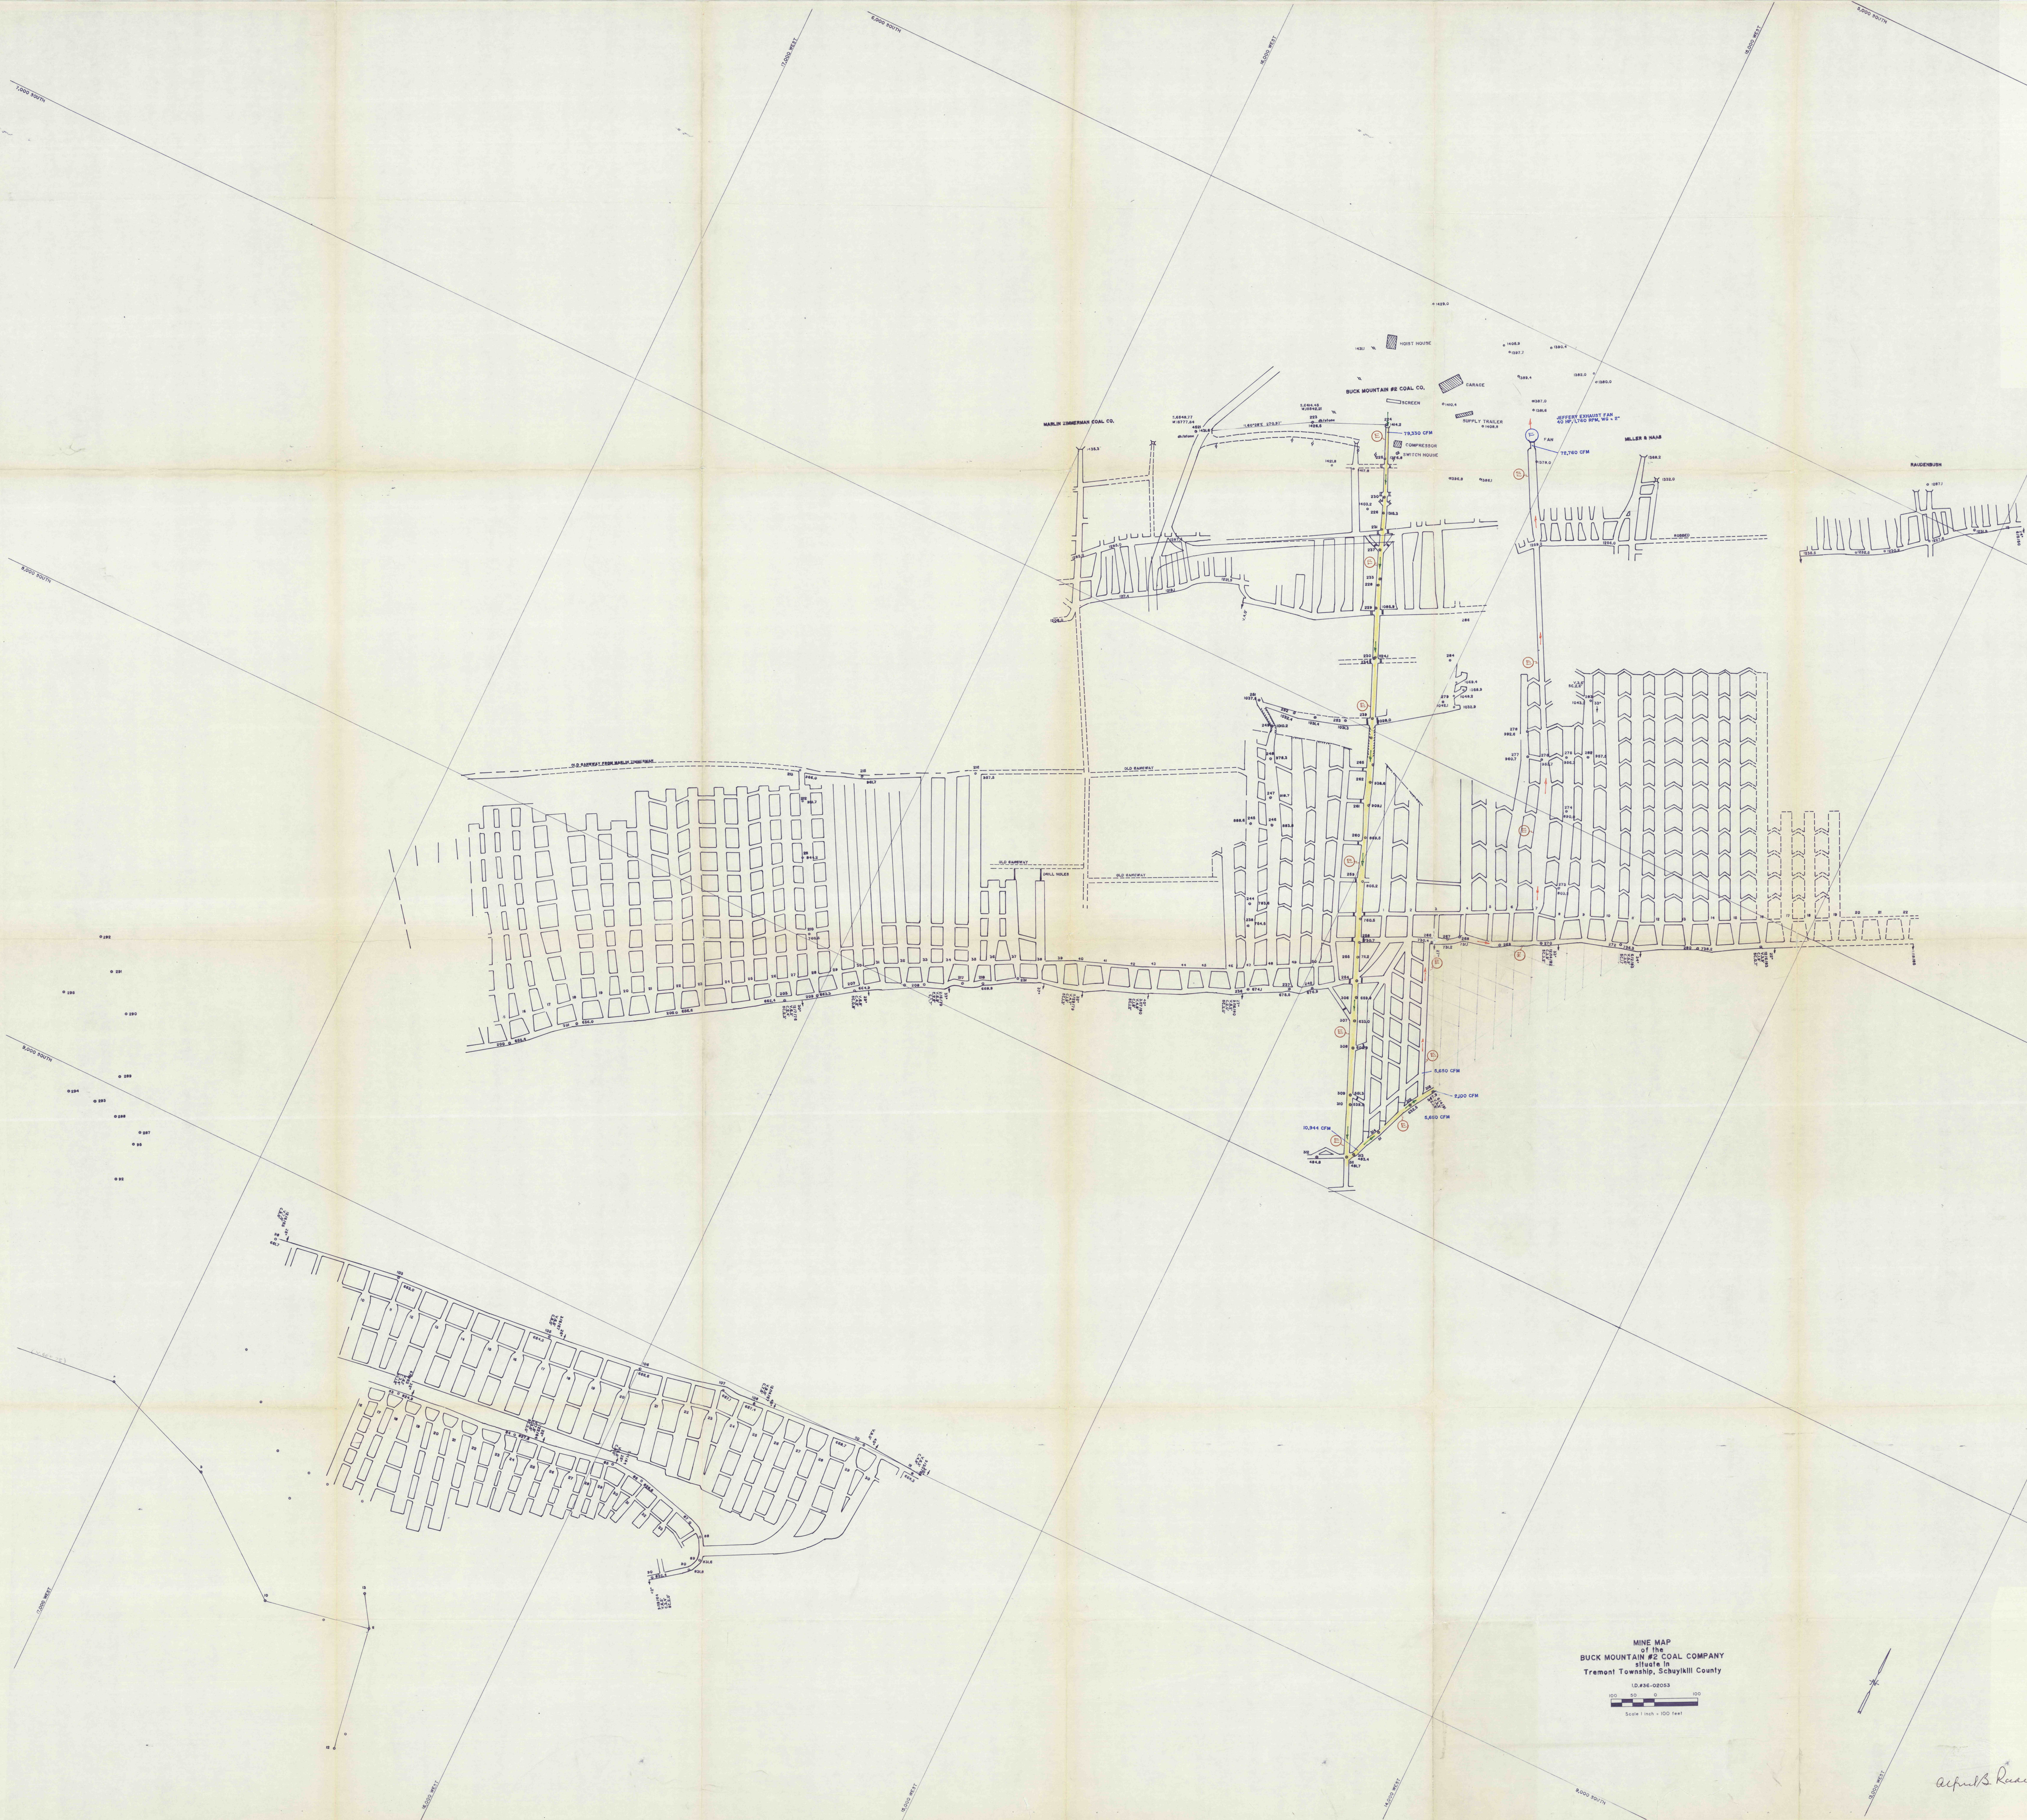

VENTILATION SYMBOLS			
⊕	Main Fan	⊞	Air Bridge
⊙	Auxiliary Fan	⊞	Regulator
⊞	Air Flow - Intake	⊞	Man Door
⊞	Air Flow - Exhaust	V	Velocity, fpm
+	Permanent Stopping	Q	Quantity, cfm
+	Temporary Stopping	WG	Water Gauge

MINE MAP
of the
BUCK MOUNTAIN #2 COAL COMPANY
situated in
Tremont Township, Schuylkill County
10, 238-02053
Scale 1 inch = 100 feet

MINE MAP
Showing the location and extent of
development of the Buck Mountain #2
Coal Company slope mine. Situated on
the south dip Buck Mountain vein,
Tremont Twp., Schuylkill County.
A.B. Riedel, P.E. June 4, 1991
Scale 1"=100'

april 1991