


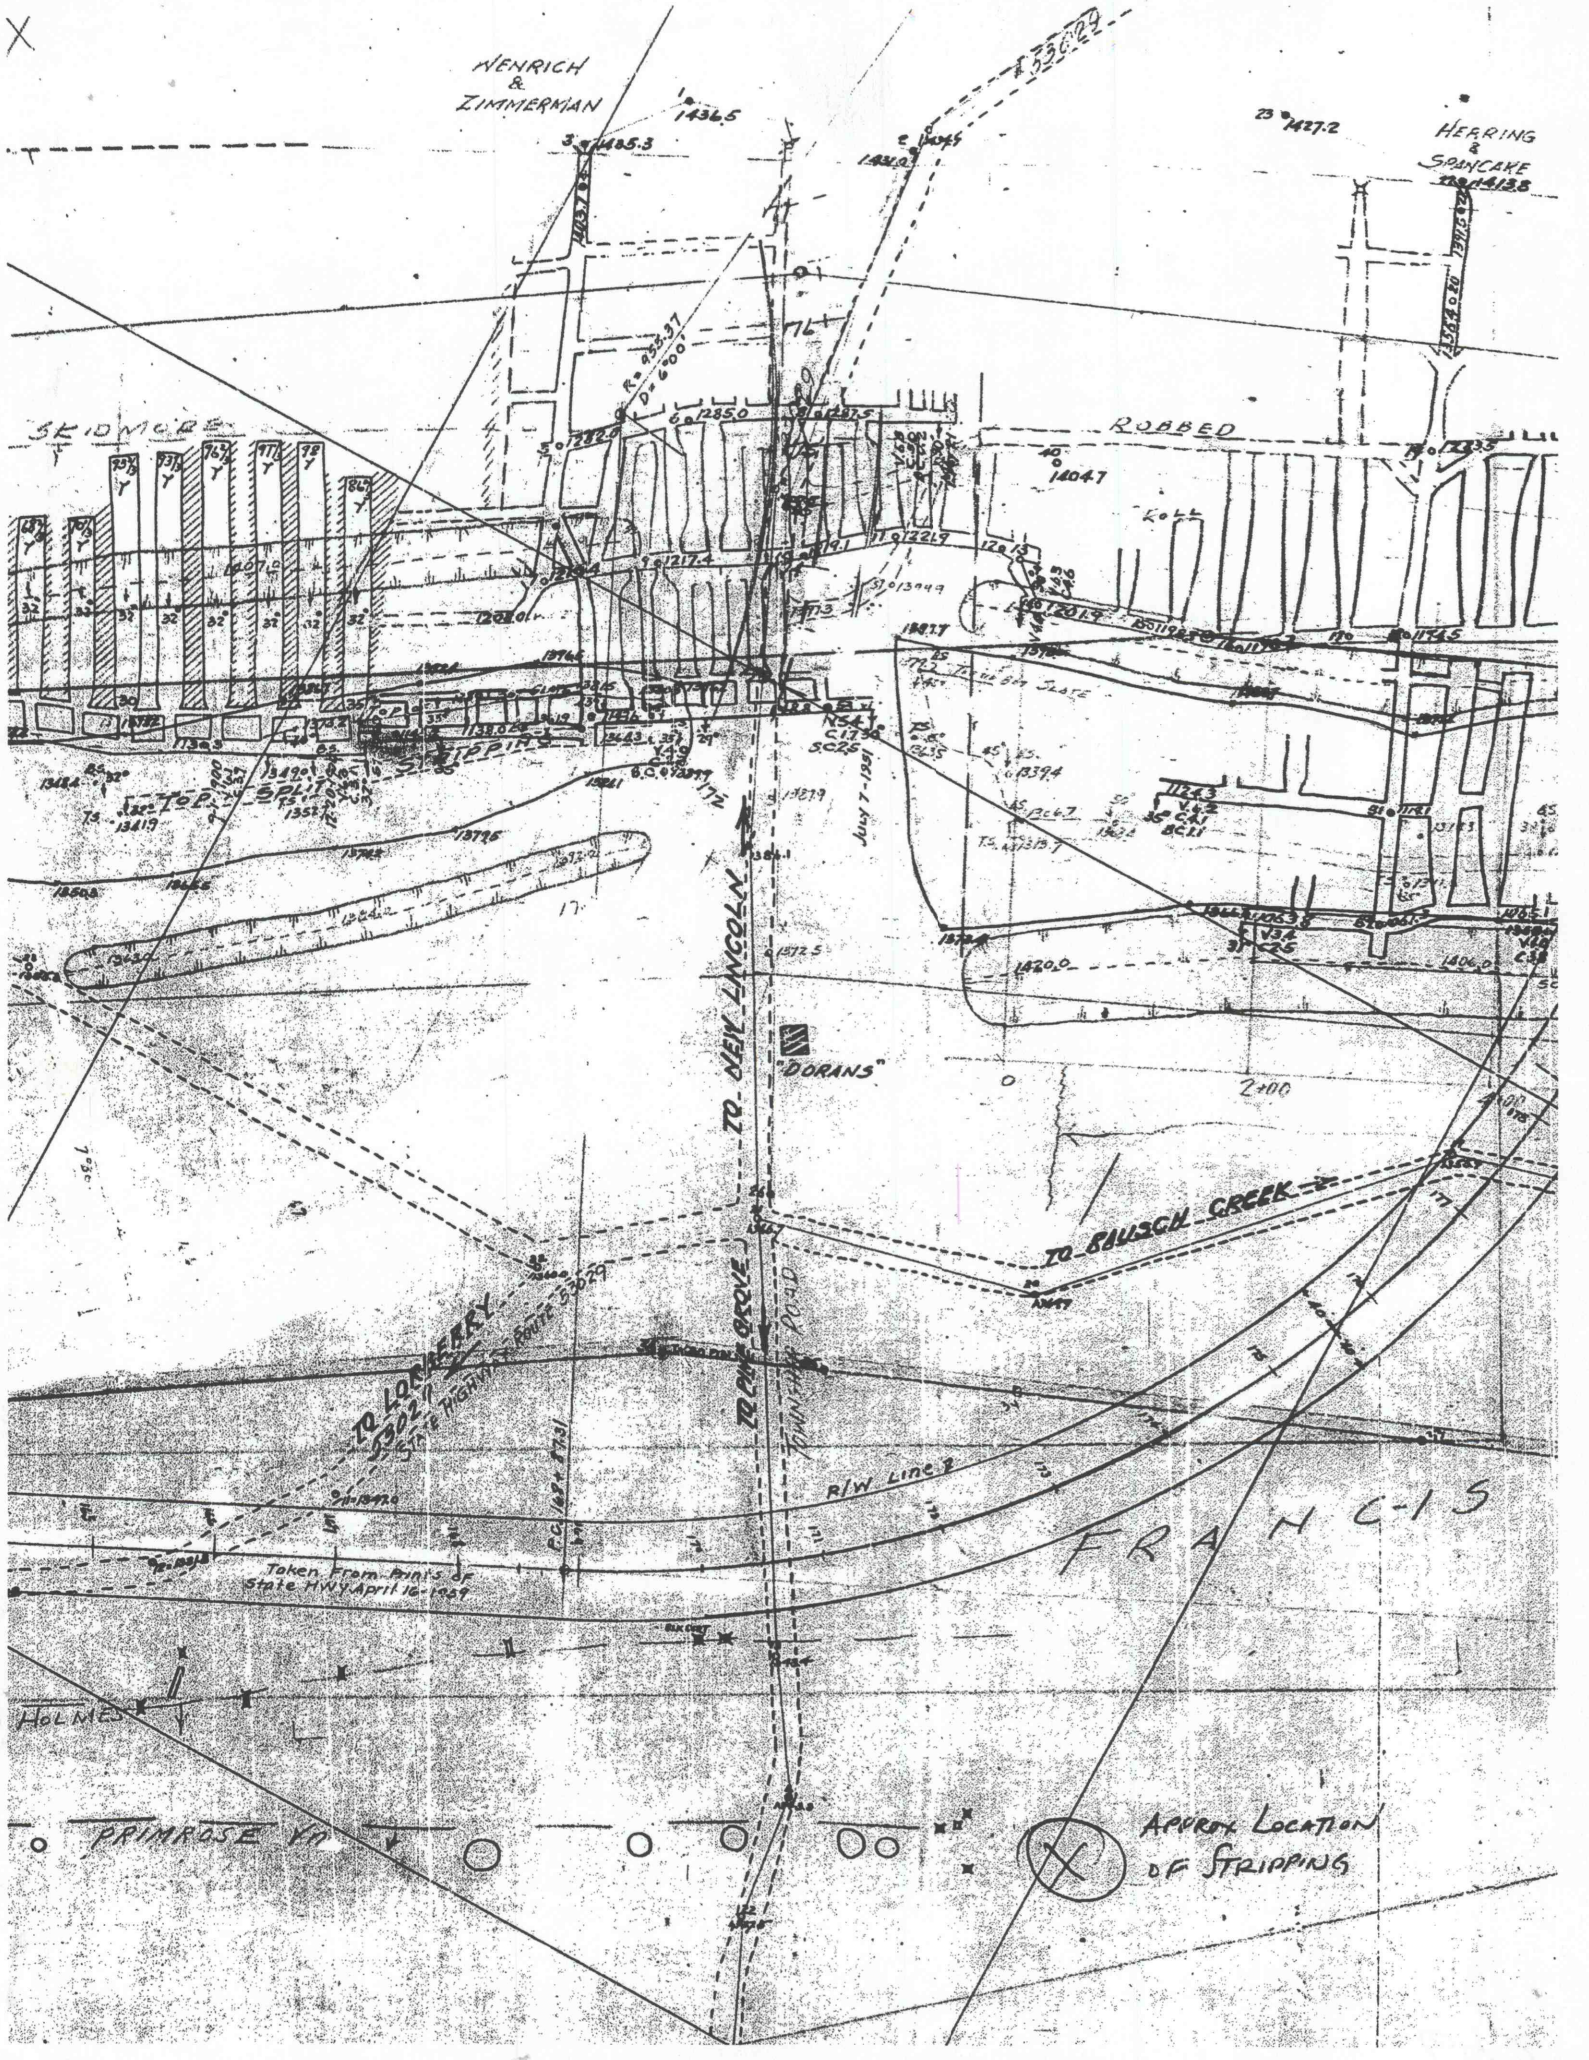

HENRICH
&
ZIMMERMAN

SKIDMORE

ROBBED

HEARING
&

TO NEW LINCOLN

"DORANS"


FRANCIS



R/W Line 2

PRIMROSE LN

APPROX LOCATION
OF STRIPPINGS

Taken from Prints of
State Hwy April 16-1957

HOLMES

BOX CIST