


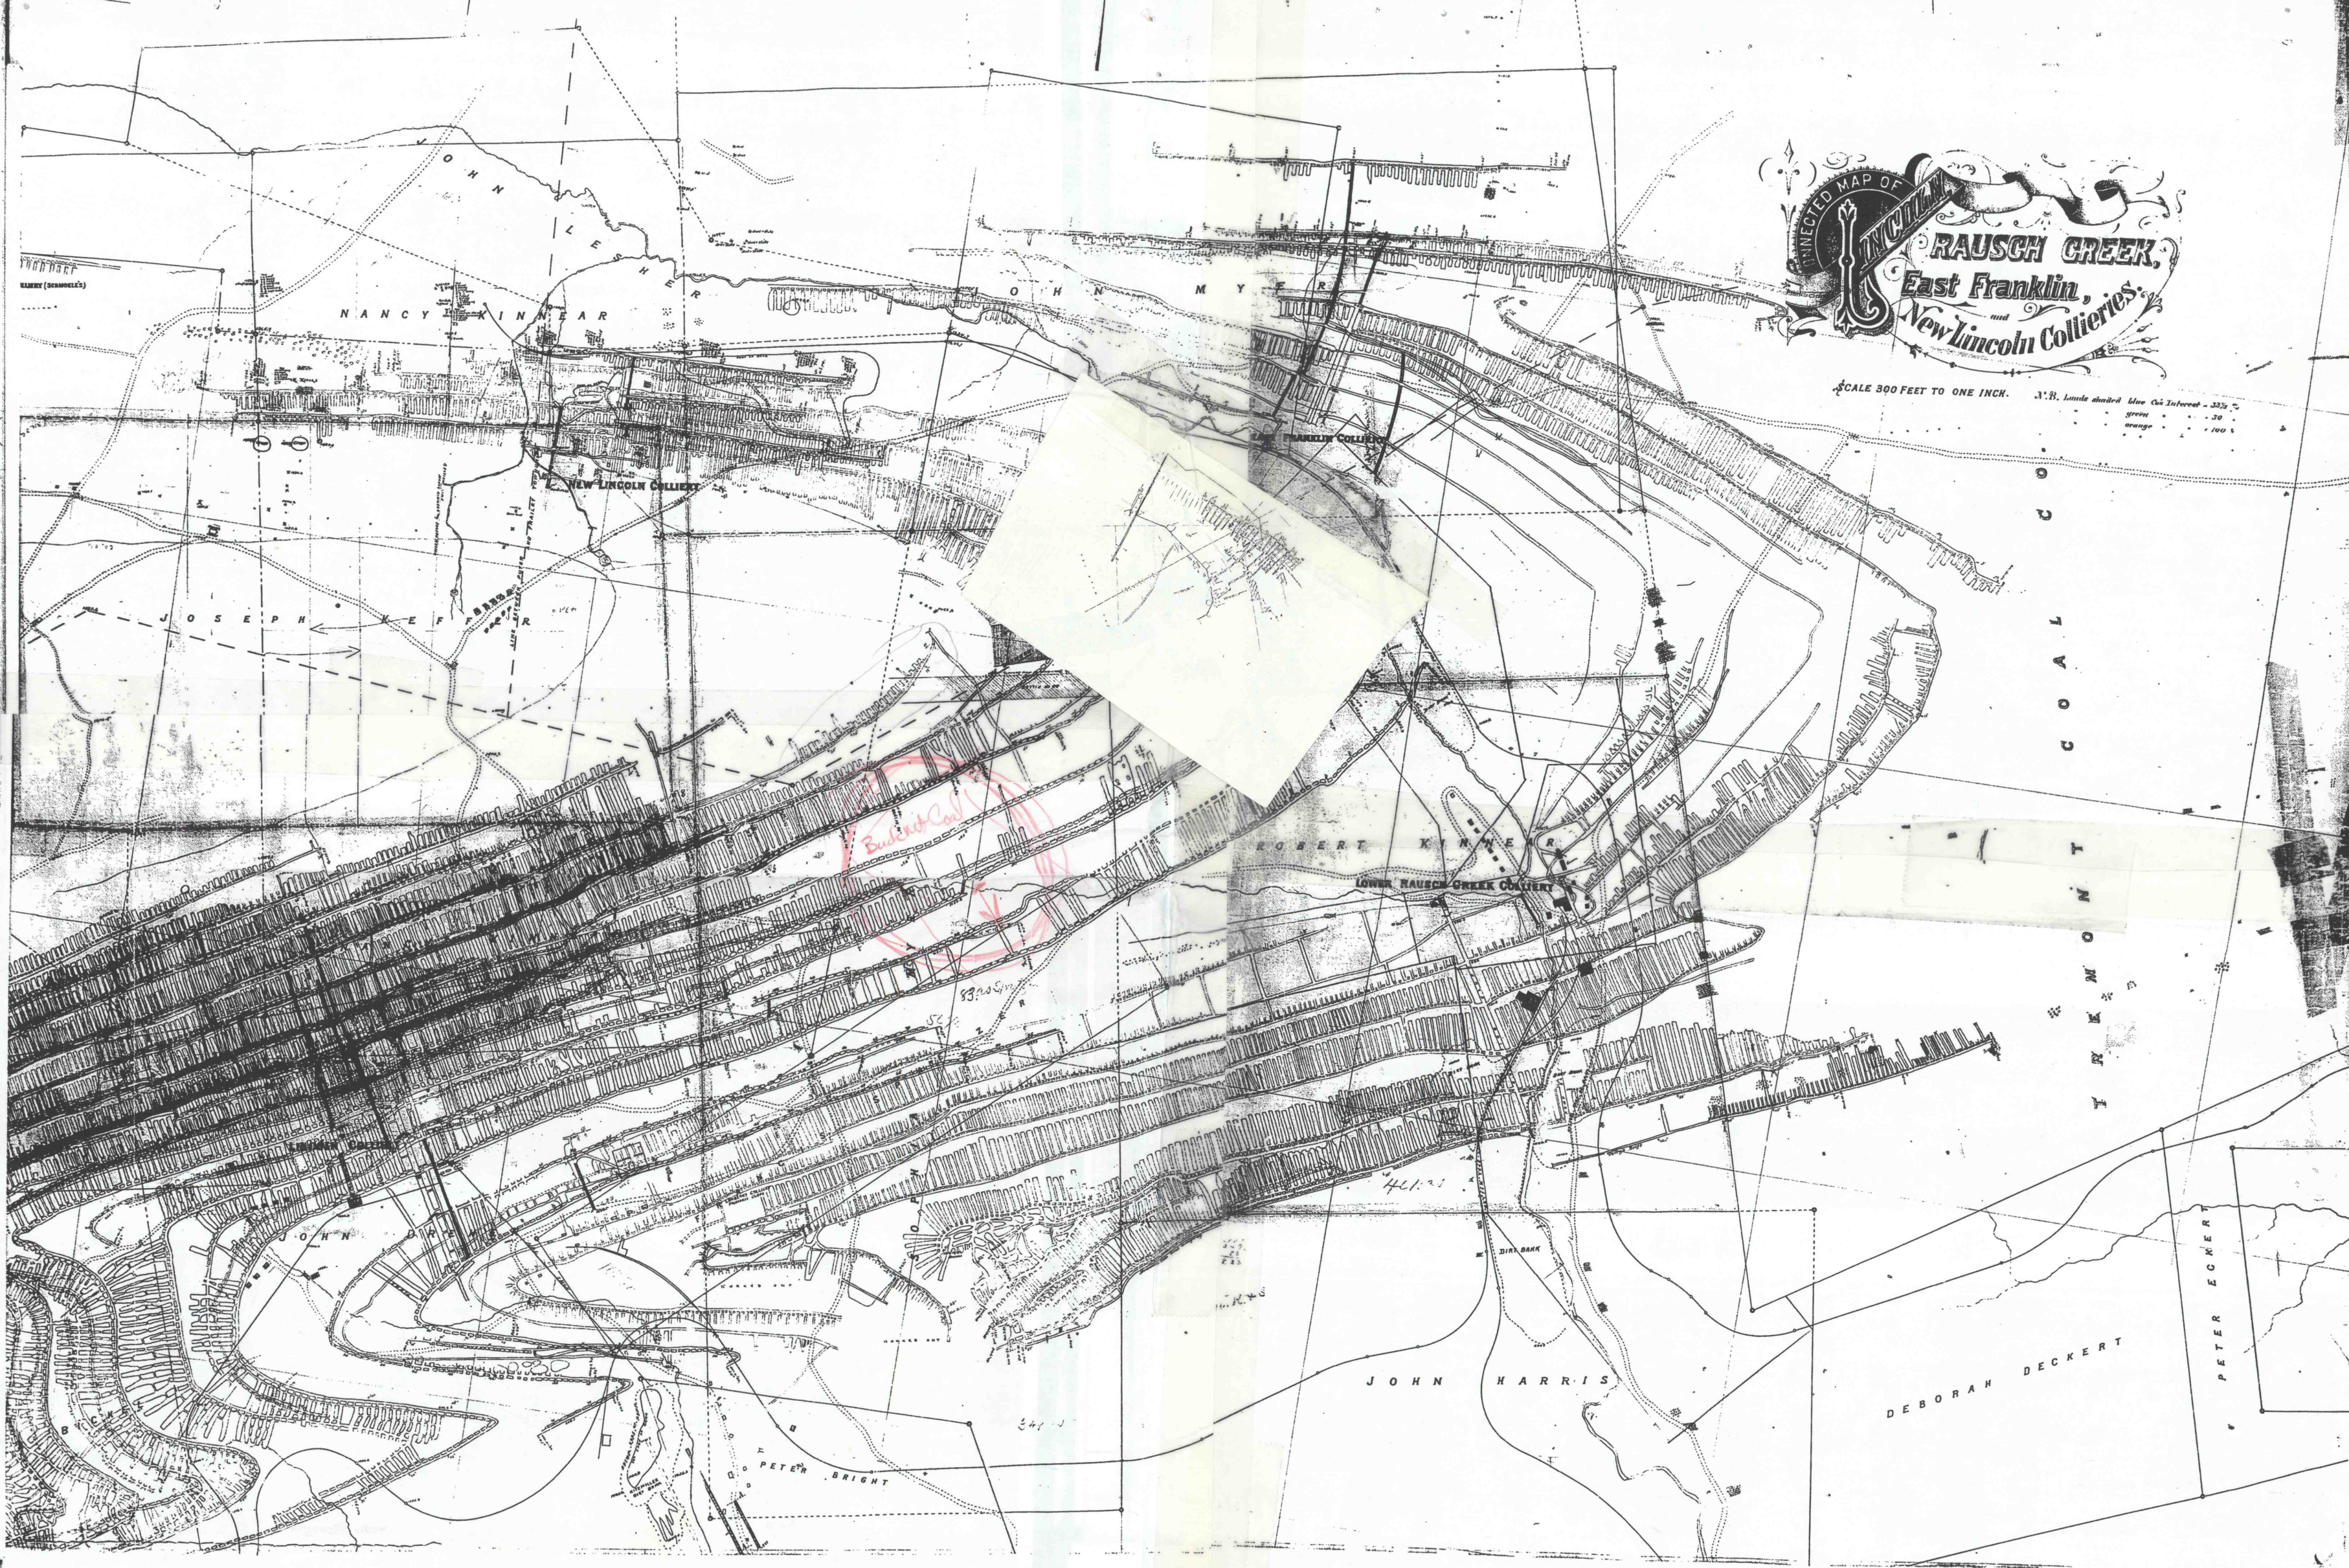

CONNECTED MAP OF
LINCOLN
RAUSCH CREEK,
East Franklin,
and
New Lincoln Collieries

SCALE 500 FEET TO ONE INCH. J.B. Land shaded blue Col Interest - 33 1/3 %
green - 30 %
orange - 100 %

Budent Coal

JOHN HARRIS

DEBORAH DECKERT

PETER ECKERT

PETER BRIGHT

COAL
Y
N
K
M
O
N
T