


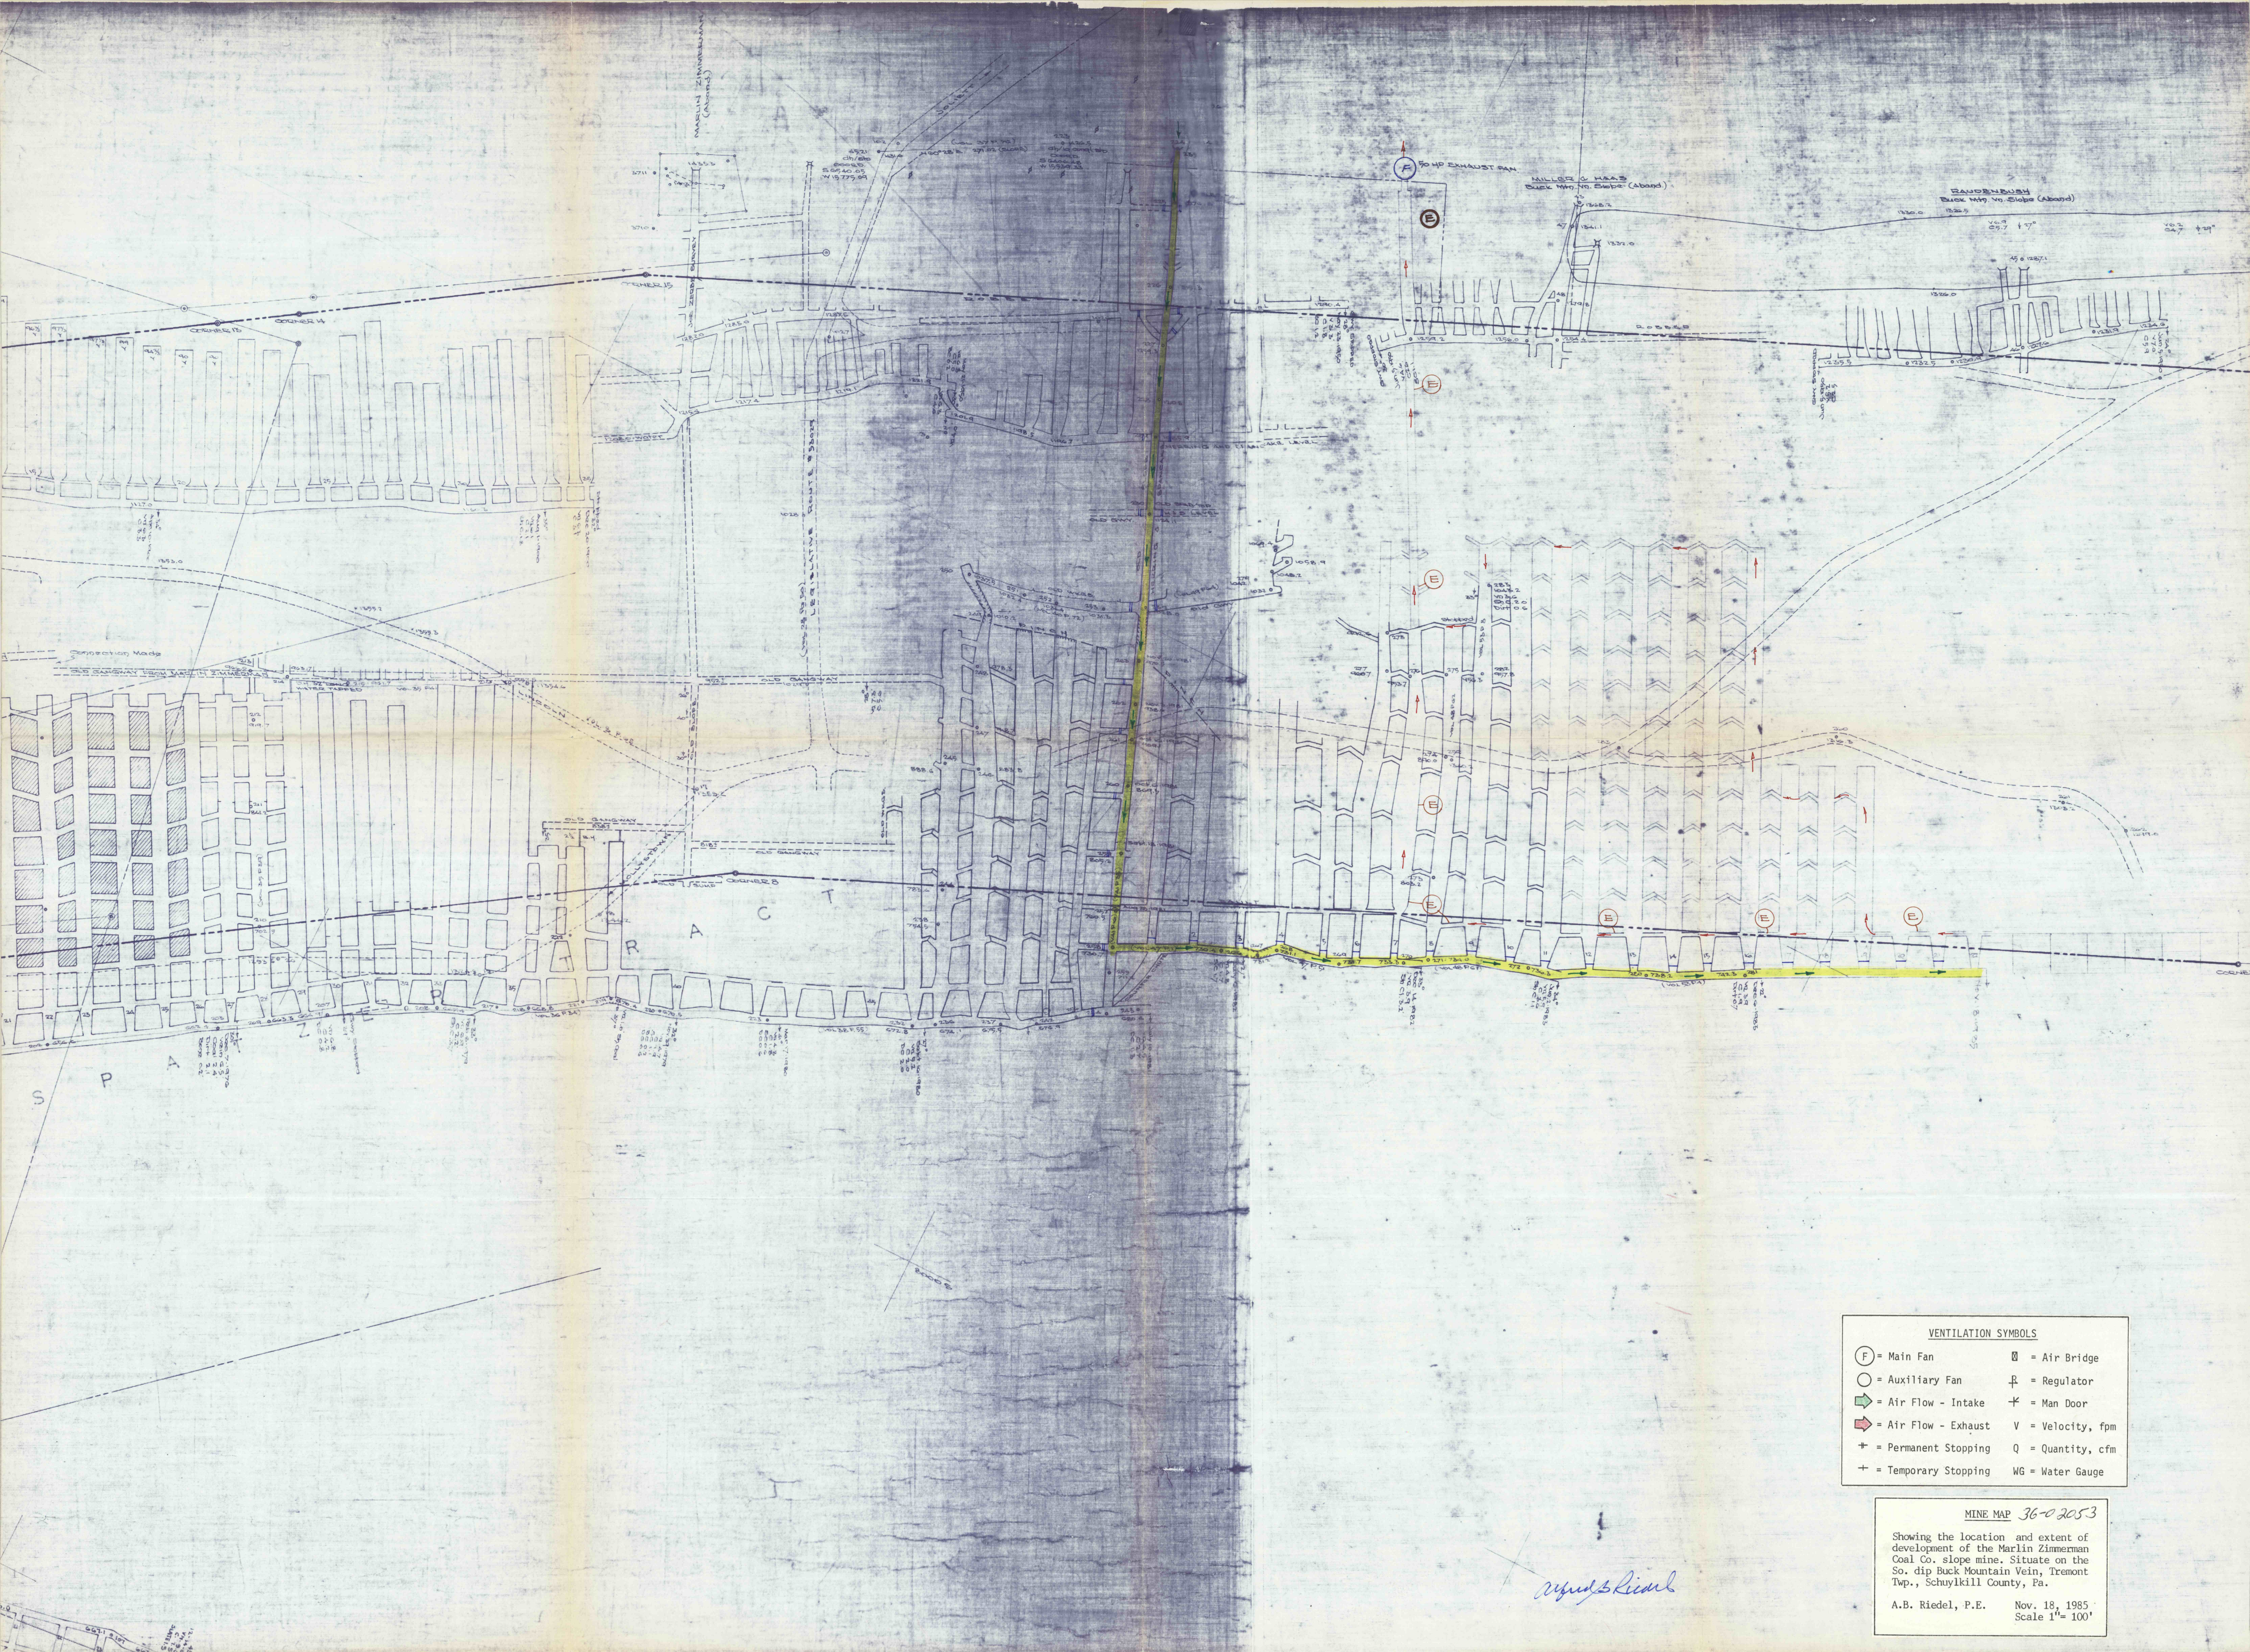

VENTILATION SYMBOLS			
(F) = Main Fan	⊠ = Air Bridge		
(R) = Auxiliary Fan	⊞ = Regulator		
→ = Air Flow - Intake	⊥ = Man Door		
↘ = Air Flow - Exhaust	V = Velocity, fpm		
+ = Permanent Stopping	Q = Quantity, cfm		
⊕ = Temporary Stopping	WG = Water Gauge		

MINE MAP 36-02053
Showing the location and extent of development of the Marlin Zimmerman Coal Co. slope mine. Situate on the So. dip Buck Mountain Vein, Tremont Twp., Schuylkill County, Pa.
A.B. Riedel, P.E. Nov. 18, 1985
Scale 1"= 100'