


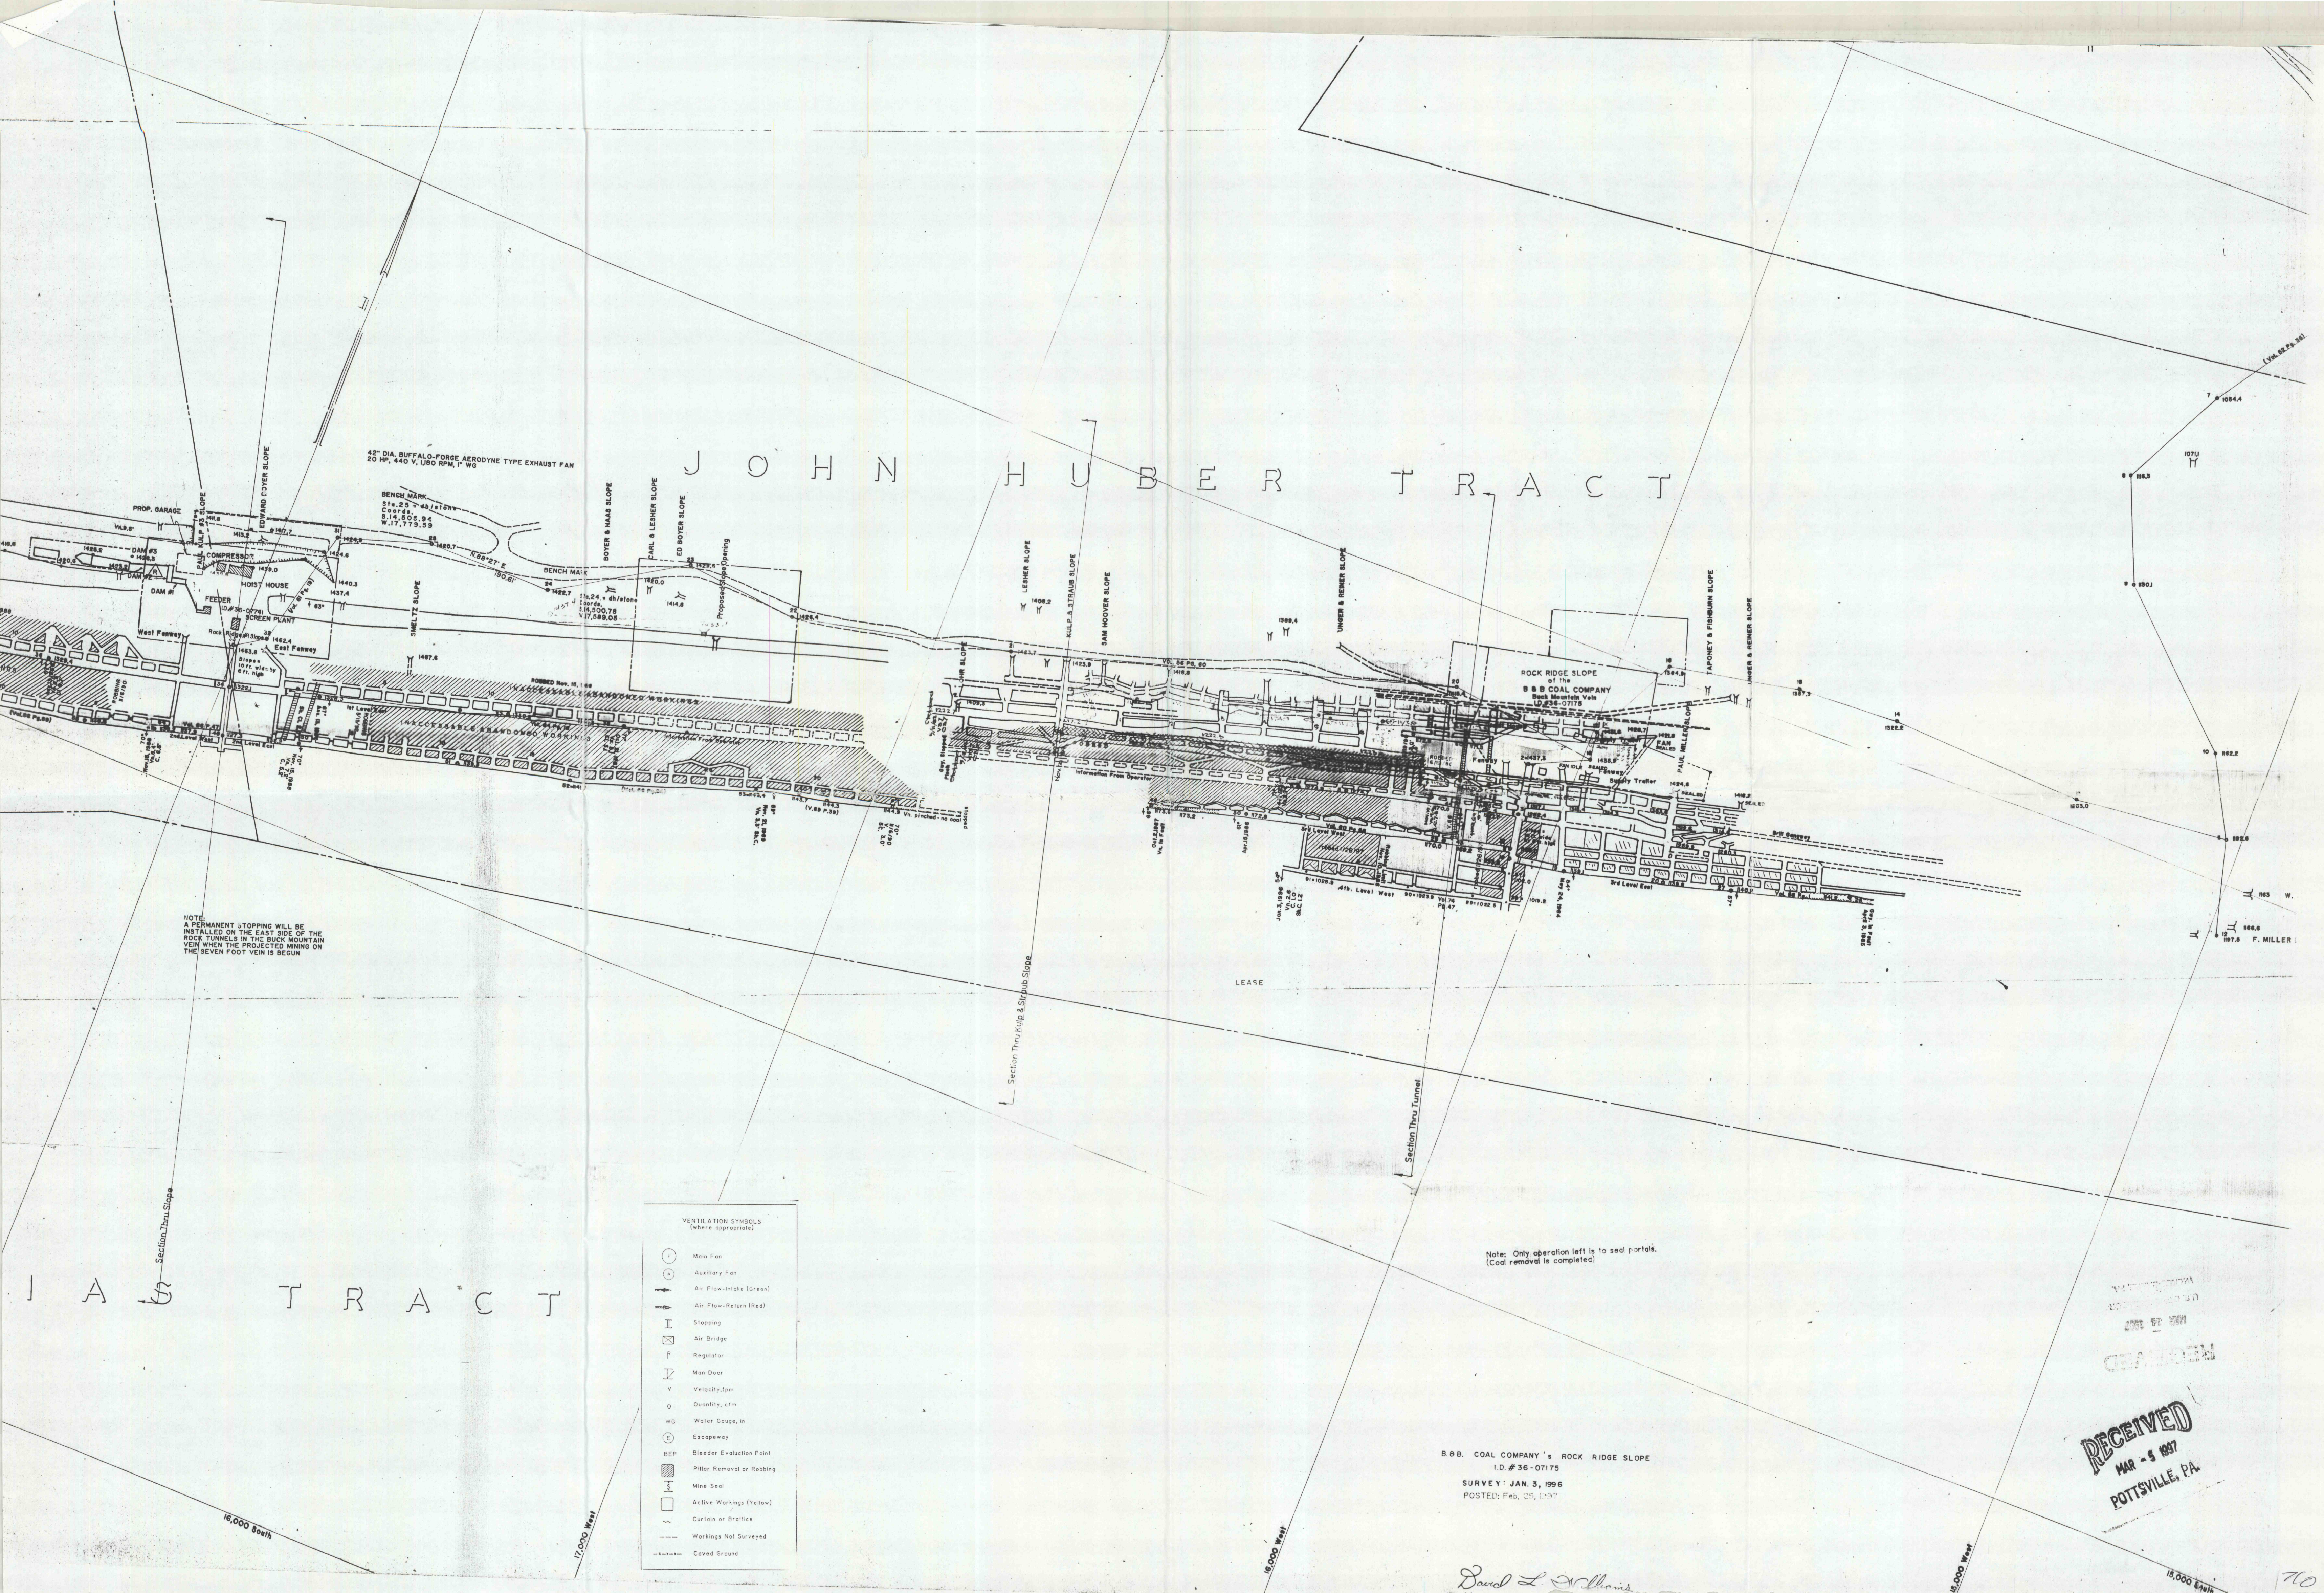

- VENTILATION SYMBOLS
(where appropriate)
- Main Fan
 - Auxiliary Fan
 - Air Flow-Intake (Green)
 - Air Flow-Return (Red)
 - Stopping
 - Air Bridge
 - Regulator
 - Man Door
 - Velocity, fpm
 - Quantity, cfm
 - WG Water Gauge, in
 - Escapeway
 - BEP Bleeder Evaluation Point
 - Pillar Removal or Robbing
 - Mine Seal
 - Active Workings (Yellow)
 - Curtain or Brattice
 - Workings Not Surveyed
 - Caved Ground

Note: Only operation left is to seal portals.
(Coal removal is completed)

B.B.B. COAL COMPANY'S ROCK RIDGE SLOPE
I.D. # 36-07175
SURVEY: JAN. 3, 1996
POSTED: Feb. 25, 1997

RECEIVED
MAR - 8 1997
POTTSVILLE, PA.

David L. Williams