


NORTH FRANKLIN COLLIERY
Cross Section 3050ft West of Renny Tunnel
Scale 100' = 1" S.E. Shamokin Aug. 17th 1904

11 mi. S. of Shamokin, Pa.
Cross Section 3050ft West of Renny Tunnel
Scale 1" = 100'
S.E.

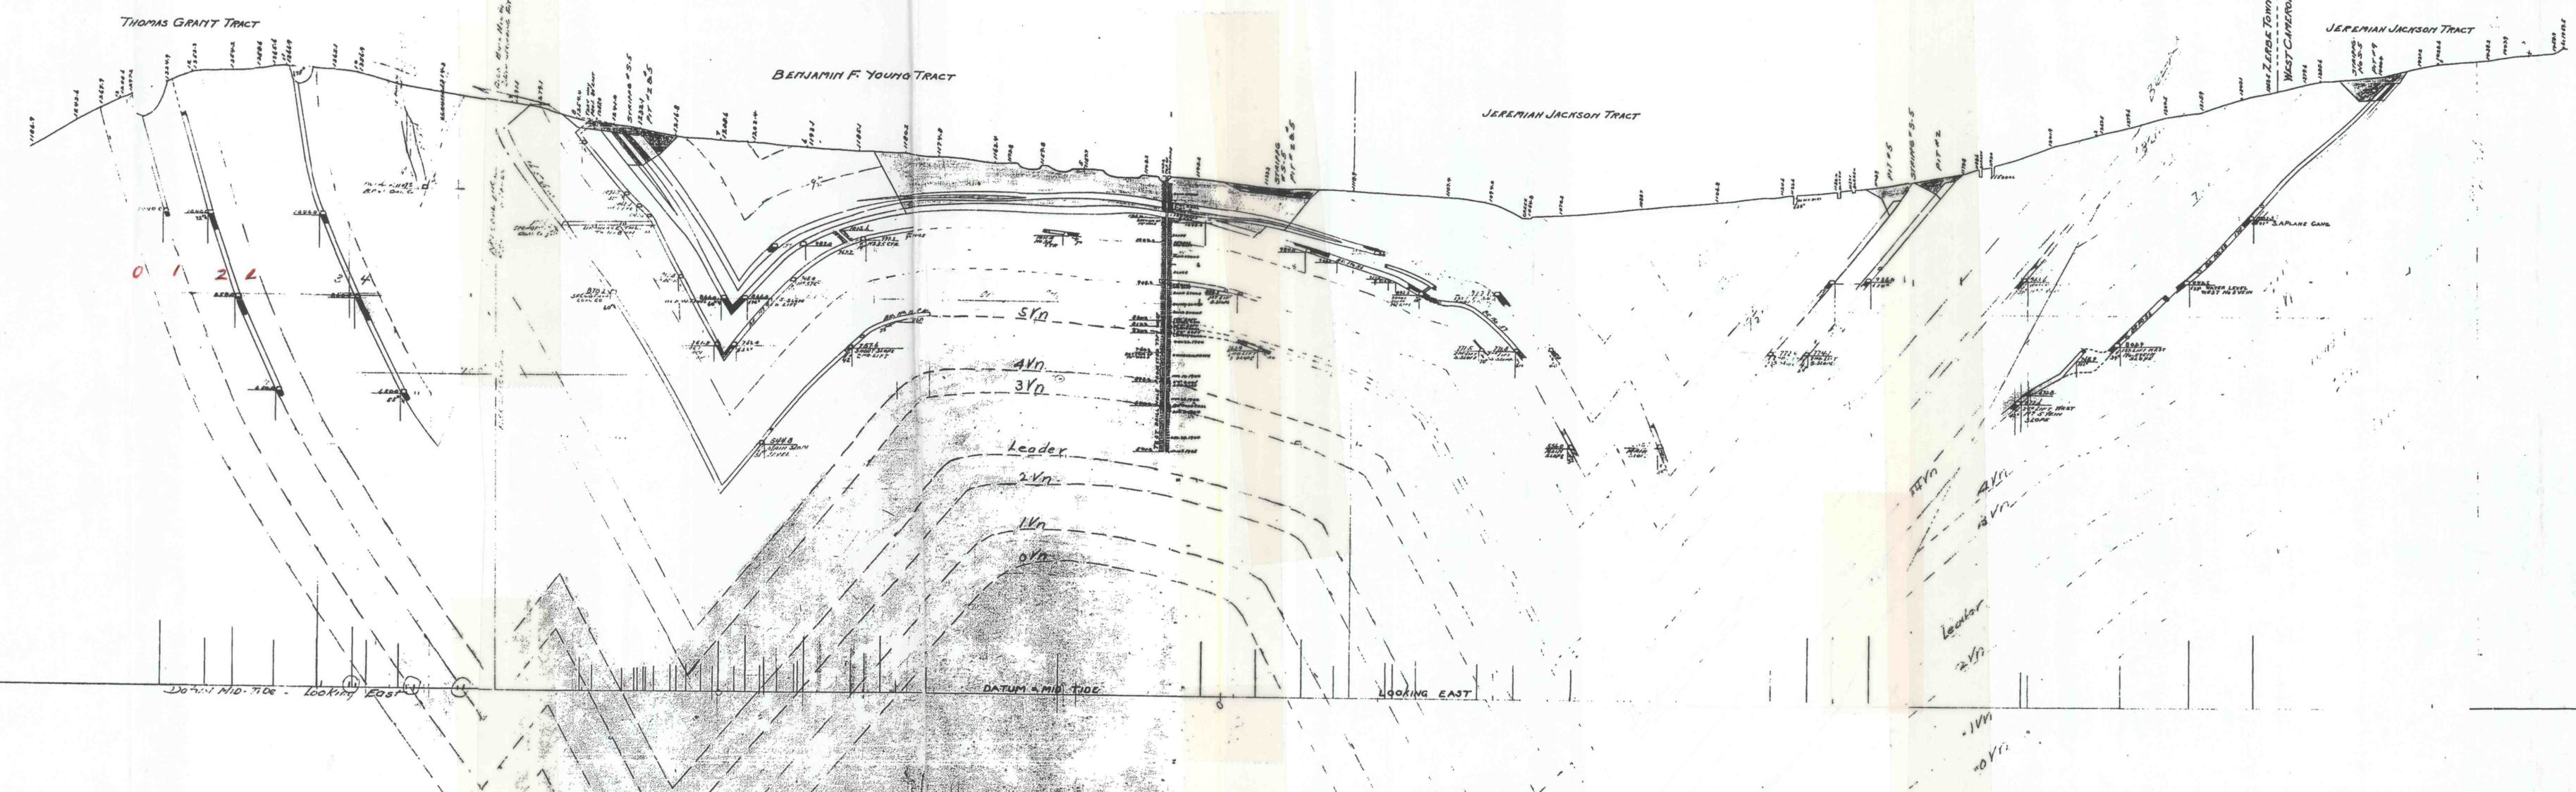

W 00 1 - 0 1 9 1/2 - 1/100 30

1/100 30