


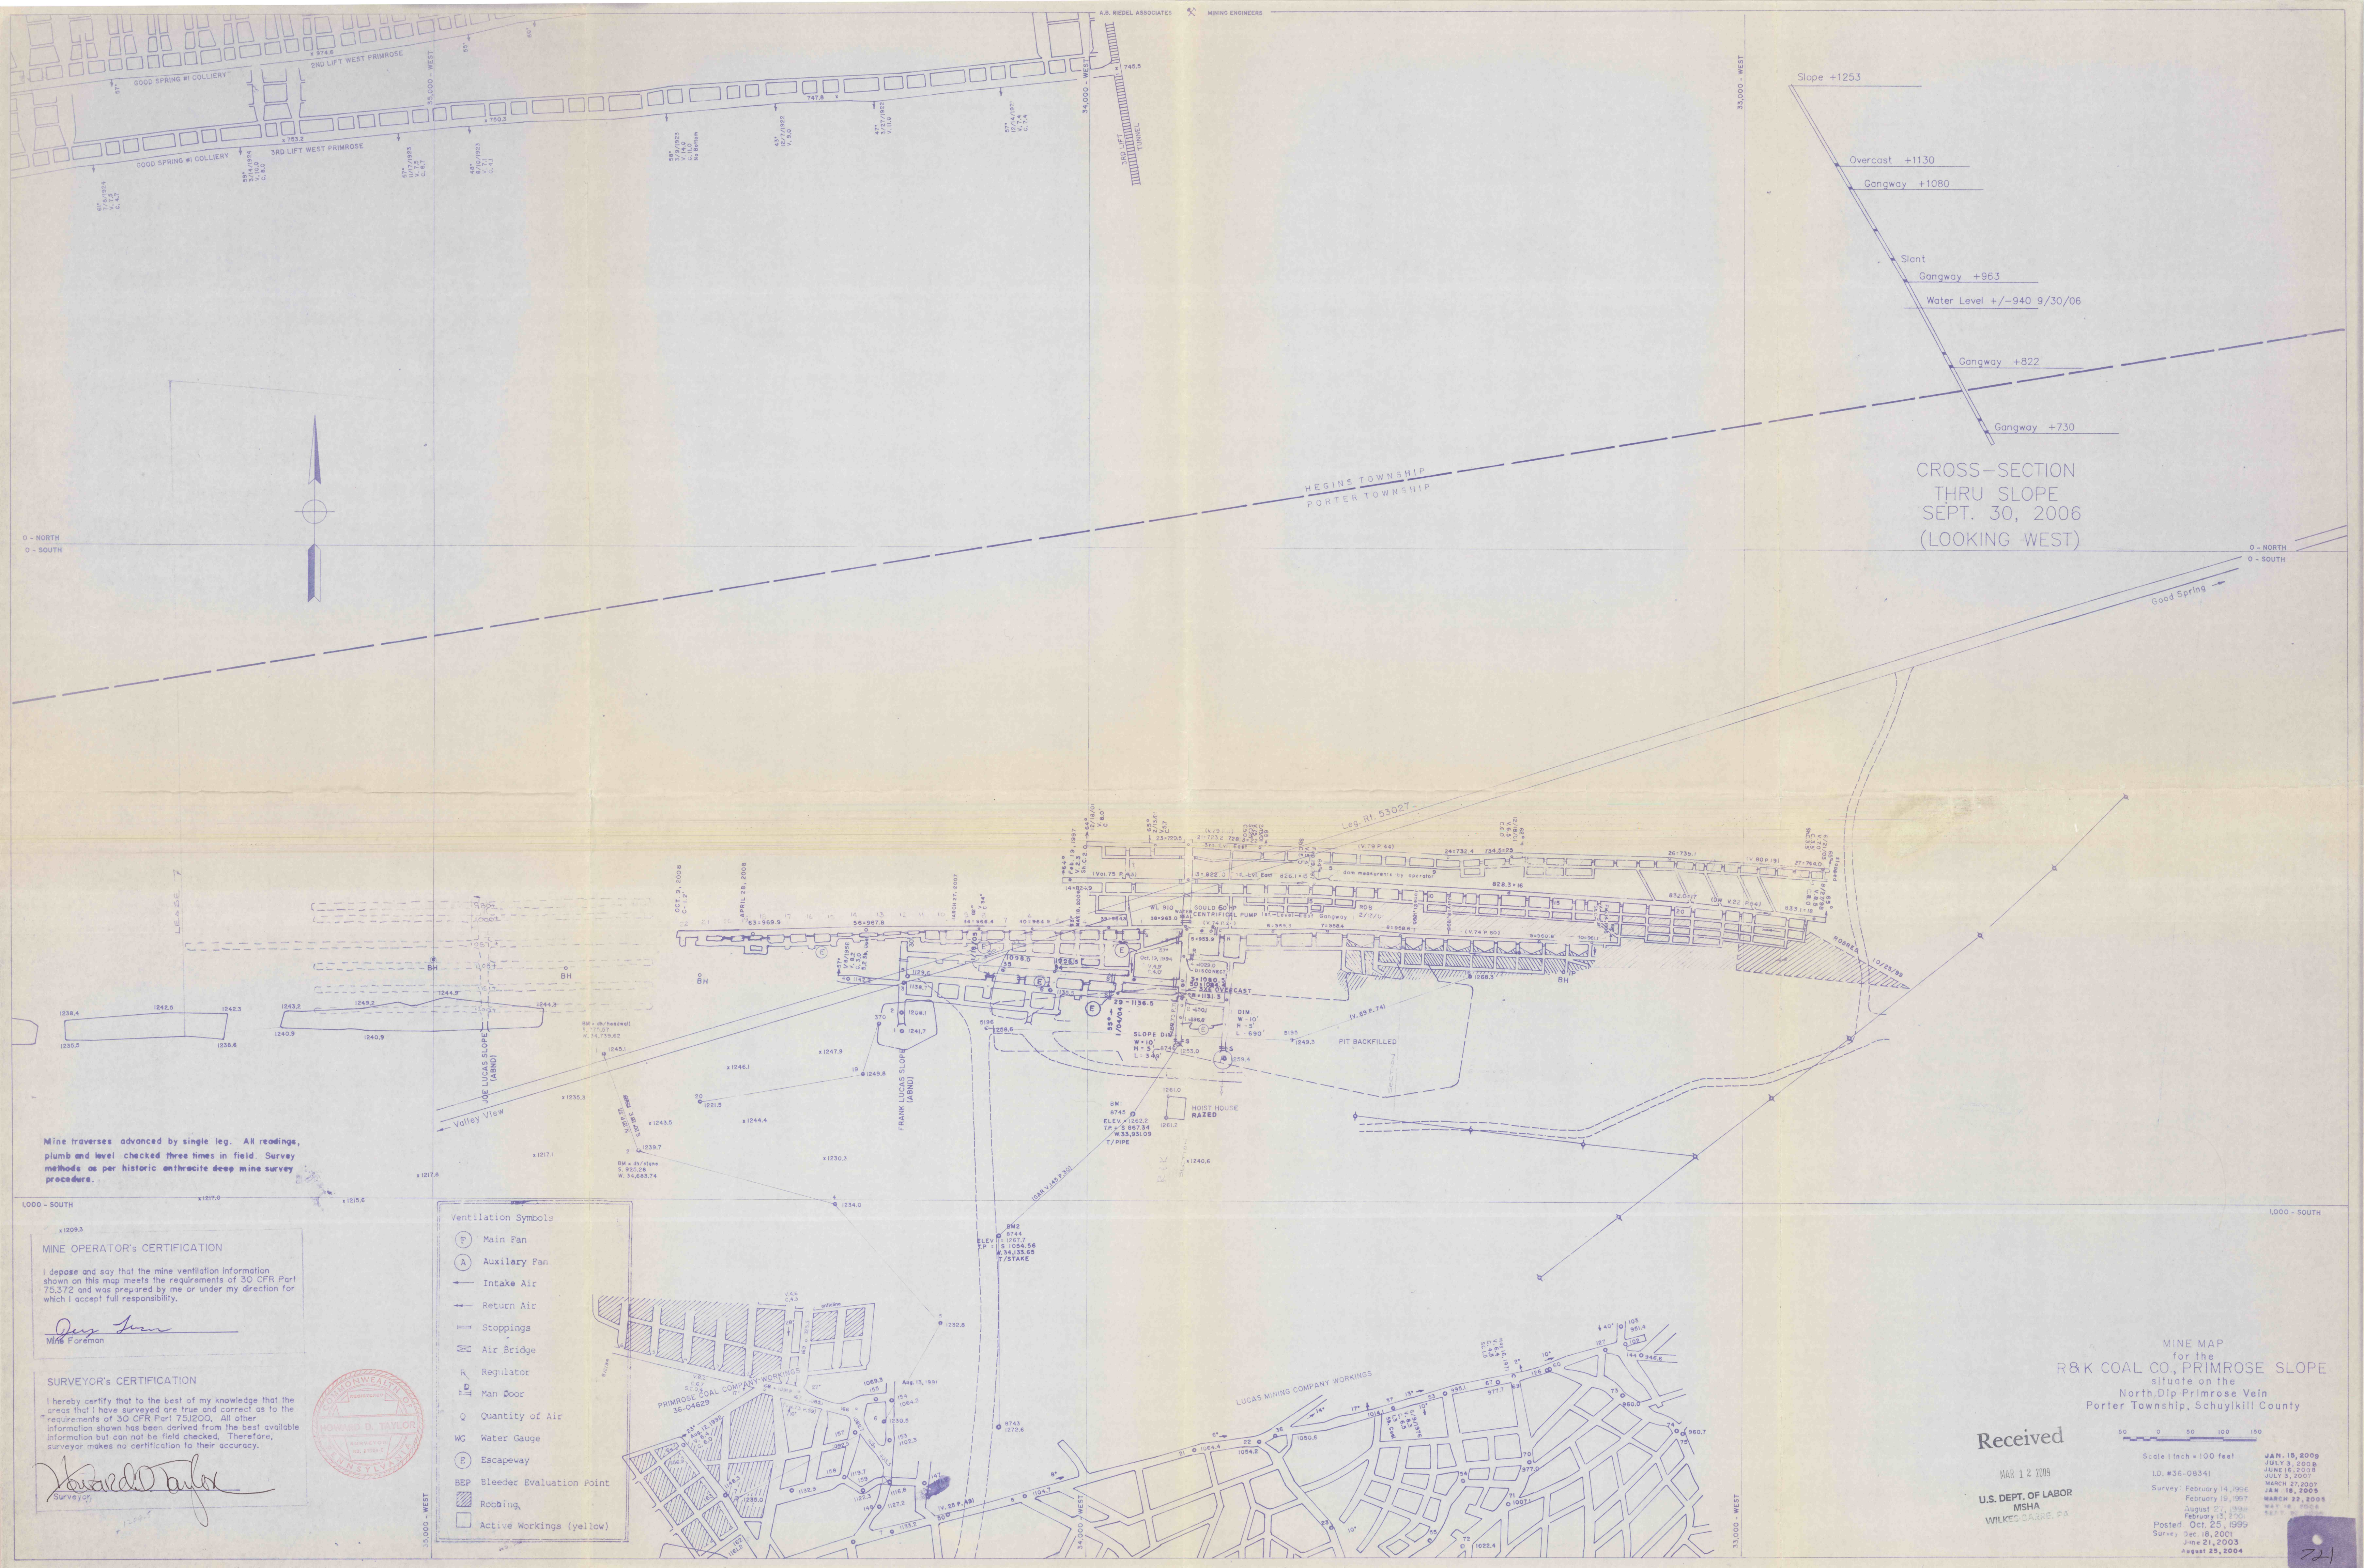

O - NORTH
O - SOUTH

CROSS-SECTION
THRU SLOPE
SEPT. 30, 2006
(LOOKING WEST)

Mine traverses advanced by single leg. All readings, plumb and level checked three times in field. Survey methods as per historic anthracite deep mine survey procedure.

MINE OPERATOR'S CERTIFICATION


I depose and say that the mine ventilation information shown on this map meets the requirements of 30 CFR Part 75.372 and was prepared by me or under my direction for which I accept full responsibility.

Ray L. Linn
Mine Foreman

SURVEYOR'S CERTIFICATION

I hereby certify that to the best of my knowledge that the areas that I have surveyed are true and correct as to the requirements of 30 CFR Part 75.372. All other information shown has been derived from the best available information but can not be field checked. Therefore, surveyor makes no certification to their accuracy.

Howard D. Taylor
Surveyor

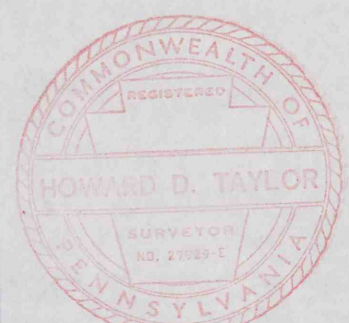

Ventilation Symbols

- Main Fan
- Auxiliary Fan
- Intake Air
- Return Air
- Stoppings
- Air Bridge
- Regulator
- Man Door
- Quantity of Air
- WG Water Gauge
- Escapeway
- BEP Bleeder Evaluation Point
- Robbing
- Active Workings (yellow)

MINE MAP
for the
R&K COAL CO., PRIMROSE SLOPE
situate on the
North Dip Primrose Vein
Porter Township, Schuylkill County

Received

MAR 12 2009
U.S. DEPT. OF LABOR
MSHA
WILKES BARRE, PA

Scale 1 inch = 100 feet

JAN. 15, 2009
JULY 3, 2008
JUNE 12, 2008
JULY 3, 2007
MARCH 27, 2007
JAN. 18, 2005
MARCH 22, 2005
AUG. 14, 2004
AUGUST 25, 2004