




MINE MAP
for the
M & S Coal Company
situate
L.V.#3 Vain, Porter Twp., Schuylkill County

Statement for Final Mine Map
Date: 11/11/05
This map represents a complete and accurate representation of all underground mine excavations by our company and that the map is the "Final" mine map for this operation.
Signature of Company or Corporate Officer

Statement for Final Mine Map
Date: 11/11/05
This map represents a complete and accurate representation of all underground mine excavations by M & S Coal Company and that the map is the "Final" mine map for this operation.
Signature of Company or Corporate Officer

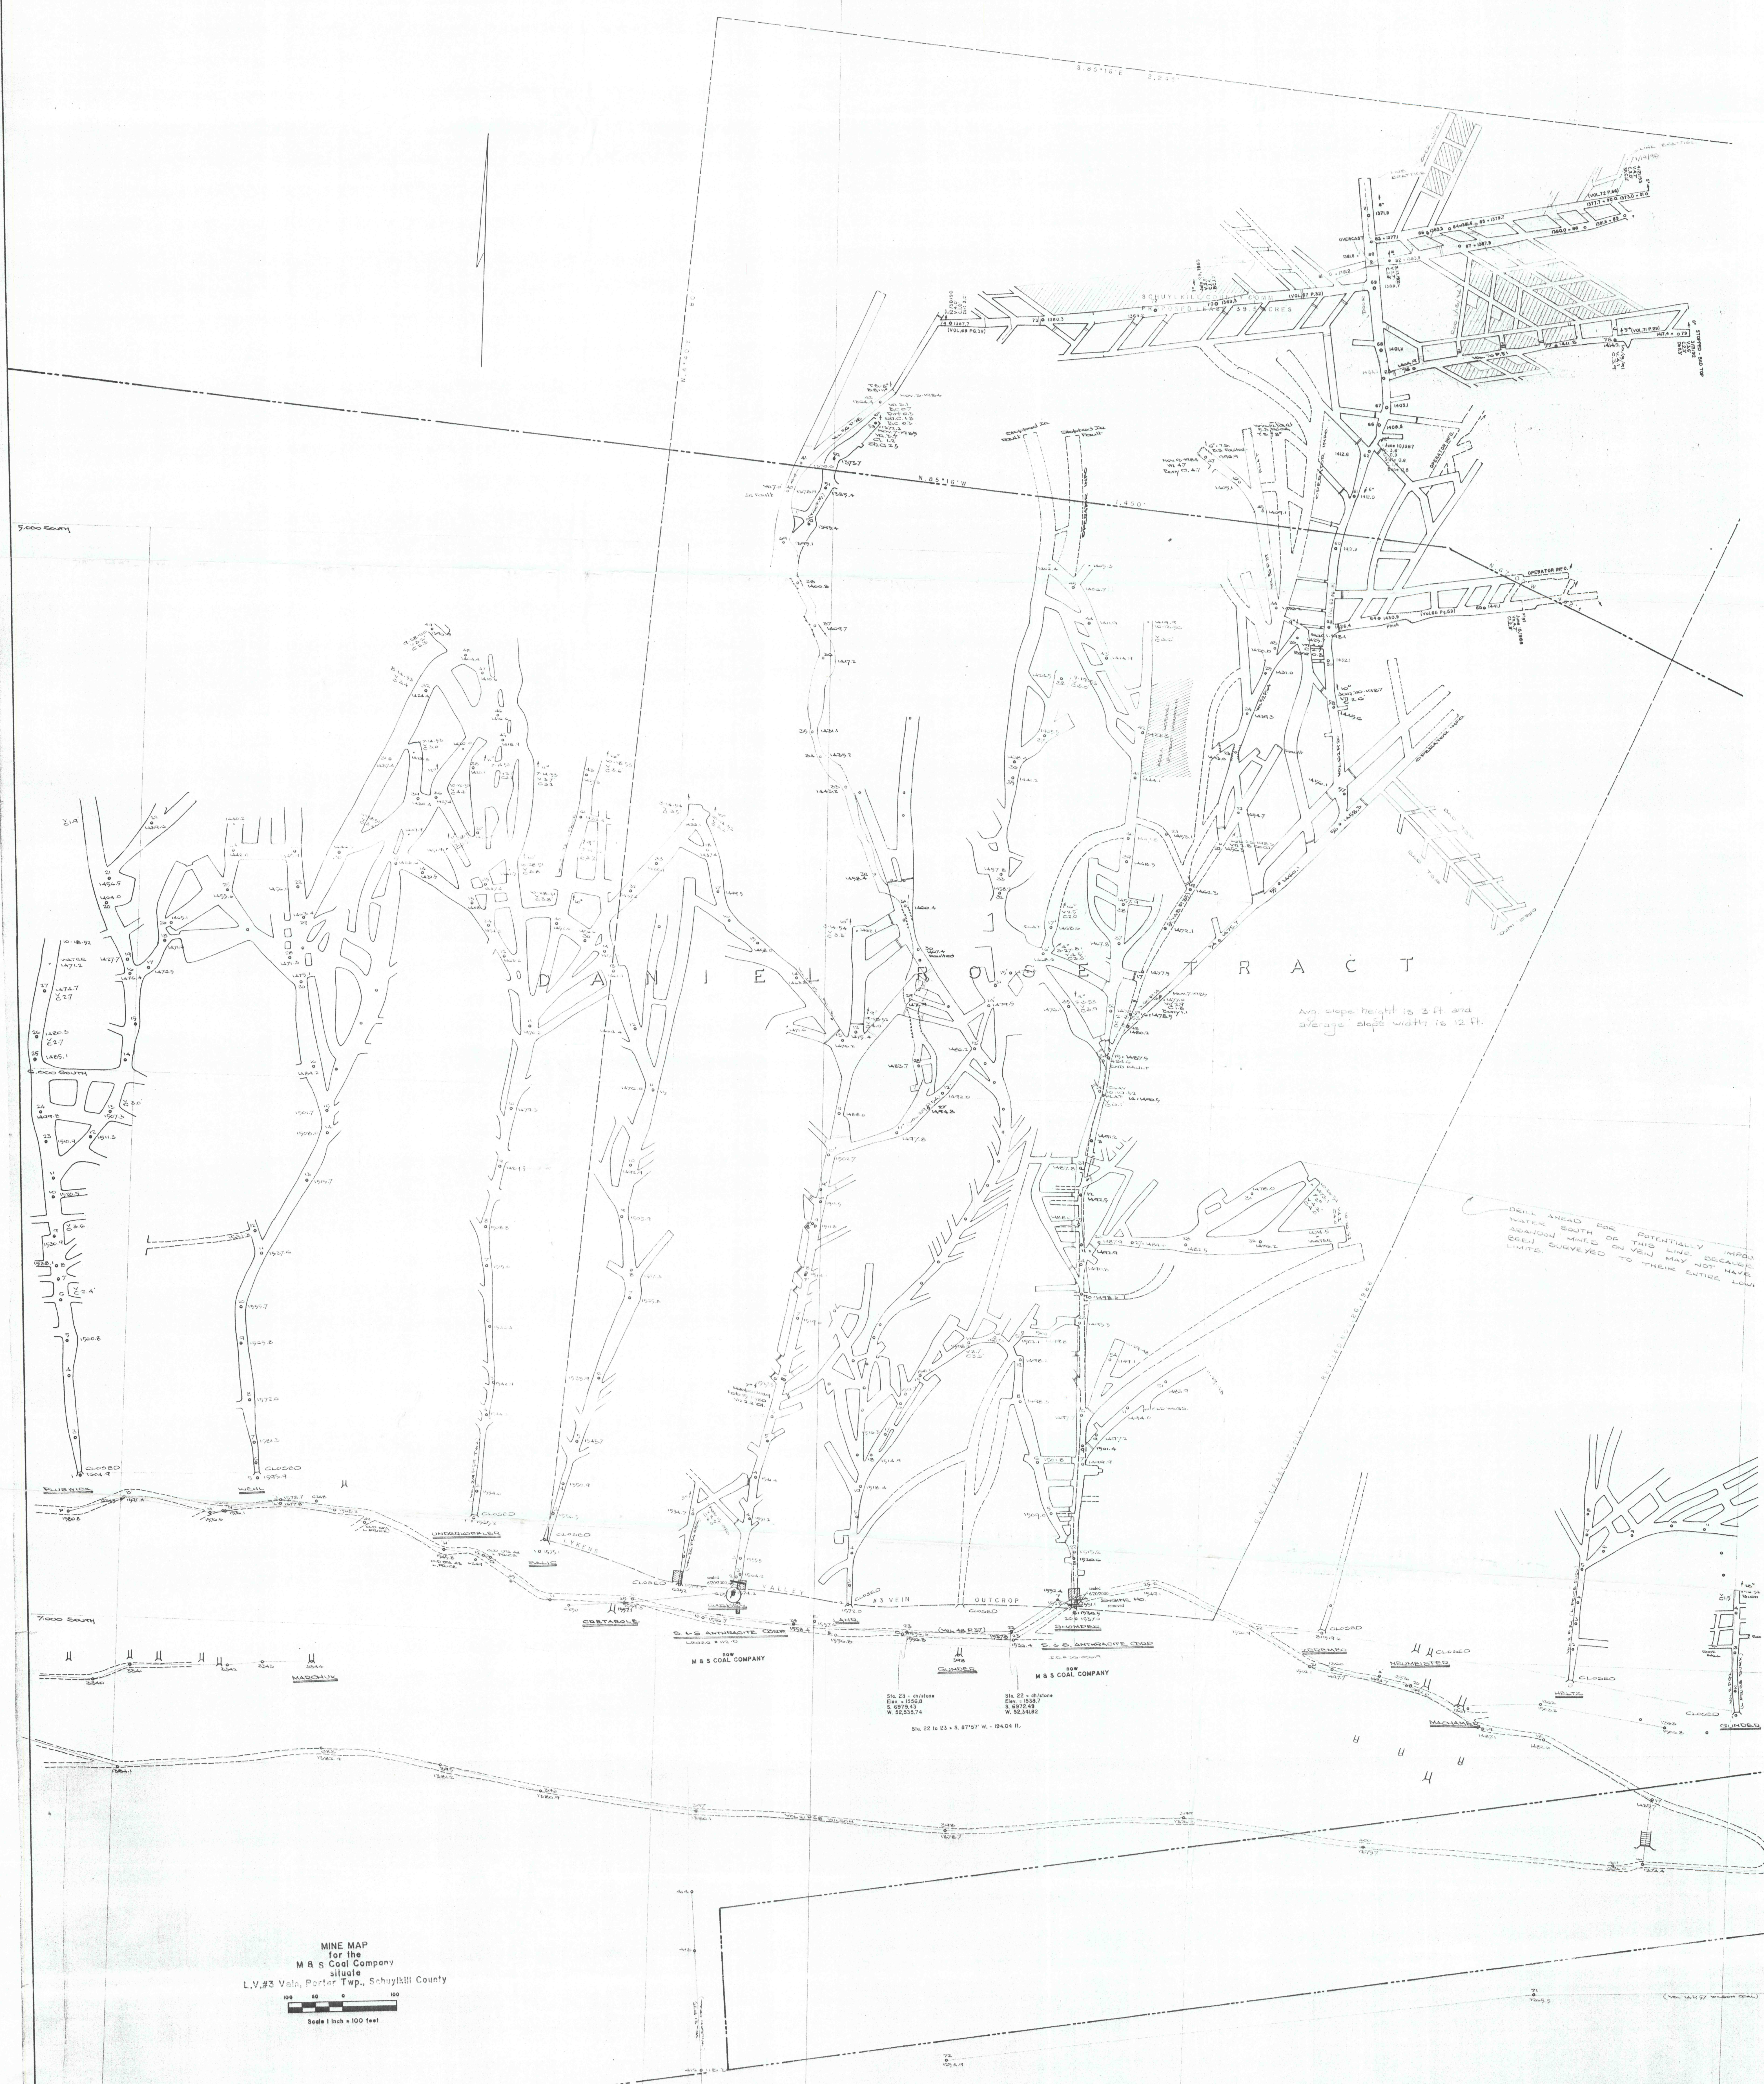