


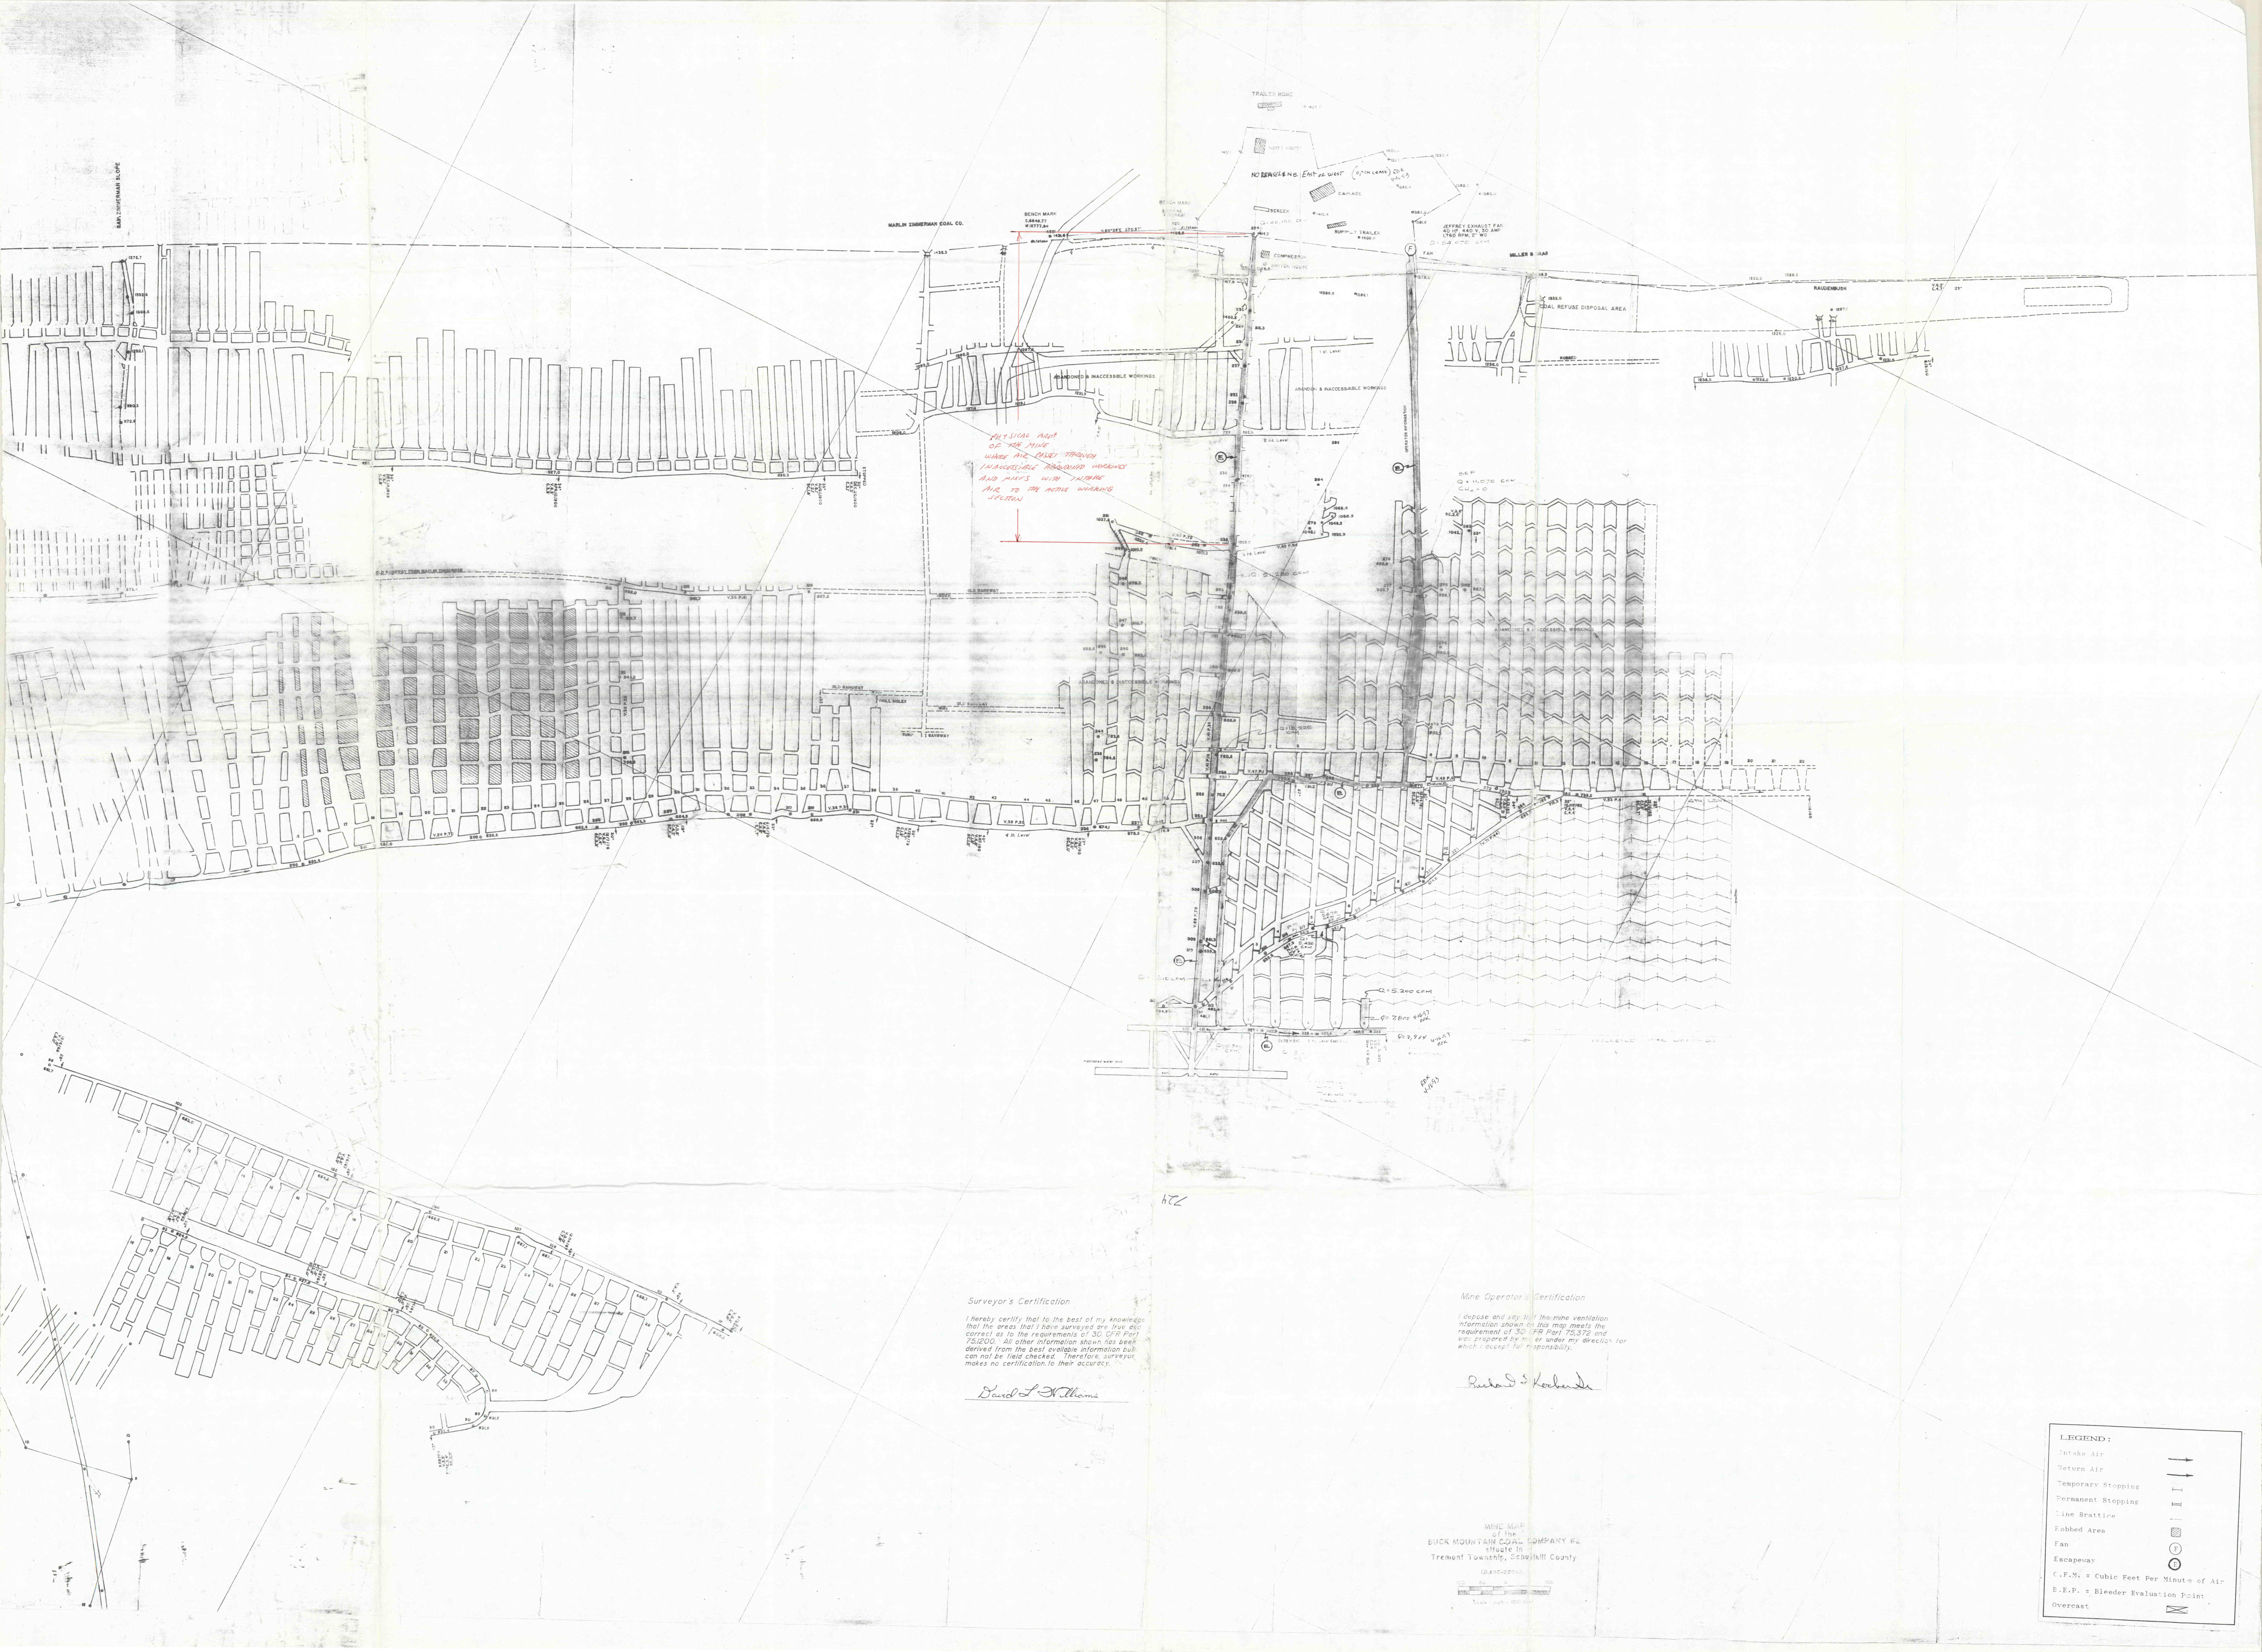

Surveyor's Certification

I hereby certify that to the best of my knowledge and belief the areas shown on this map were surveyed and are true and correct, as to the requirements of 30 CFR Part 75.200. All other information shown has been derived from the best available information and can not be field checked. Therefore, surveyor makes no certification to their accuracy.

David L. Williams

Mine Operator's Certification

I depose and say that the mine ventilation information shown on this map meets the requirement of 30 CFR Part 75.372 and was prepared by me or under my direction for which I accept full responsibility.

Richard S. Korb

BUCK MOUNTAIN COAL COMPANY

Scale 1" = 100'

LEGEND:

- Intake Air
- Return Air
- Temporary Stopping
- Permanent Stopping
- Line Brattice
- Fobbed Area
- Fan
- Escapeway
- C.F.M. = Cubic Feet Per Minute of Air
- E.E.P. = Bleeder Evaluation Point
- Overcast