


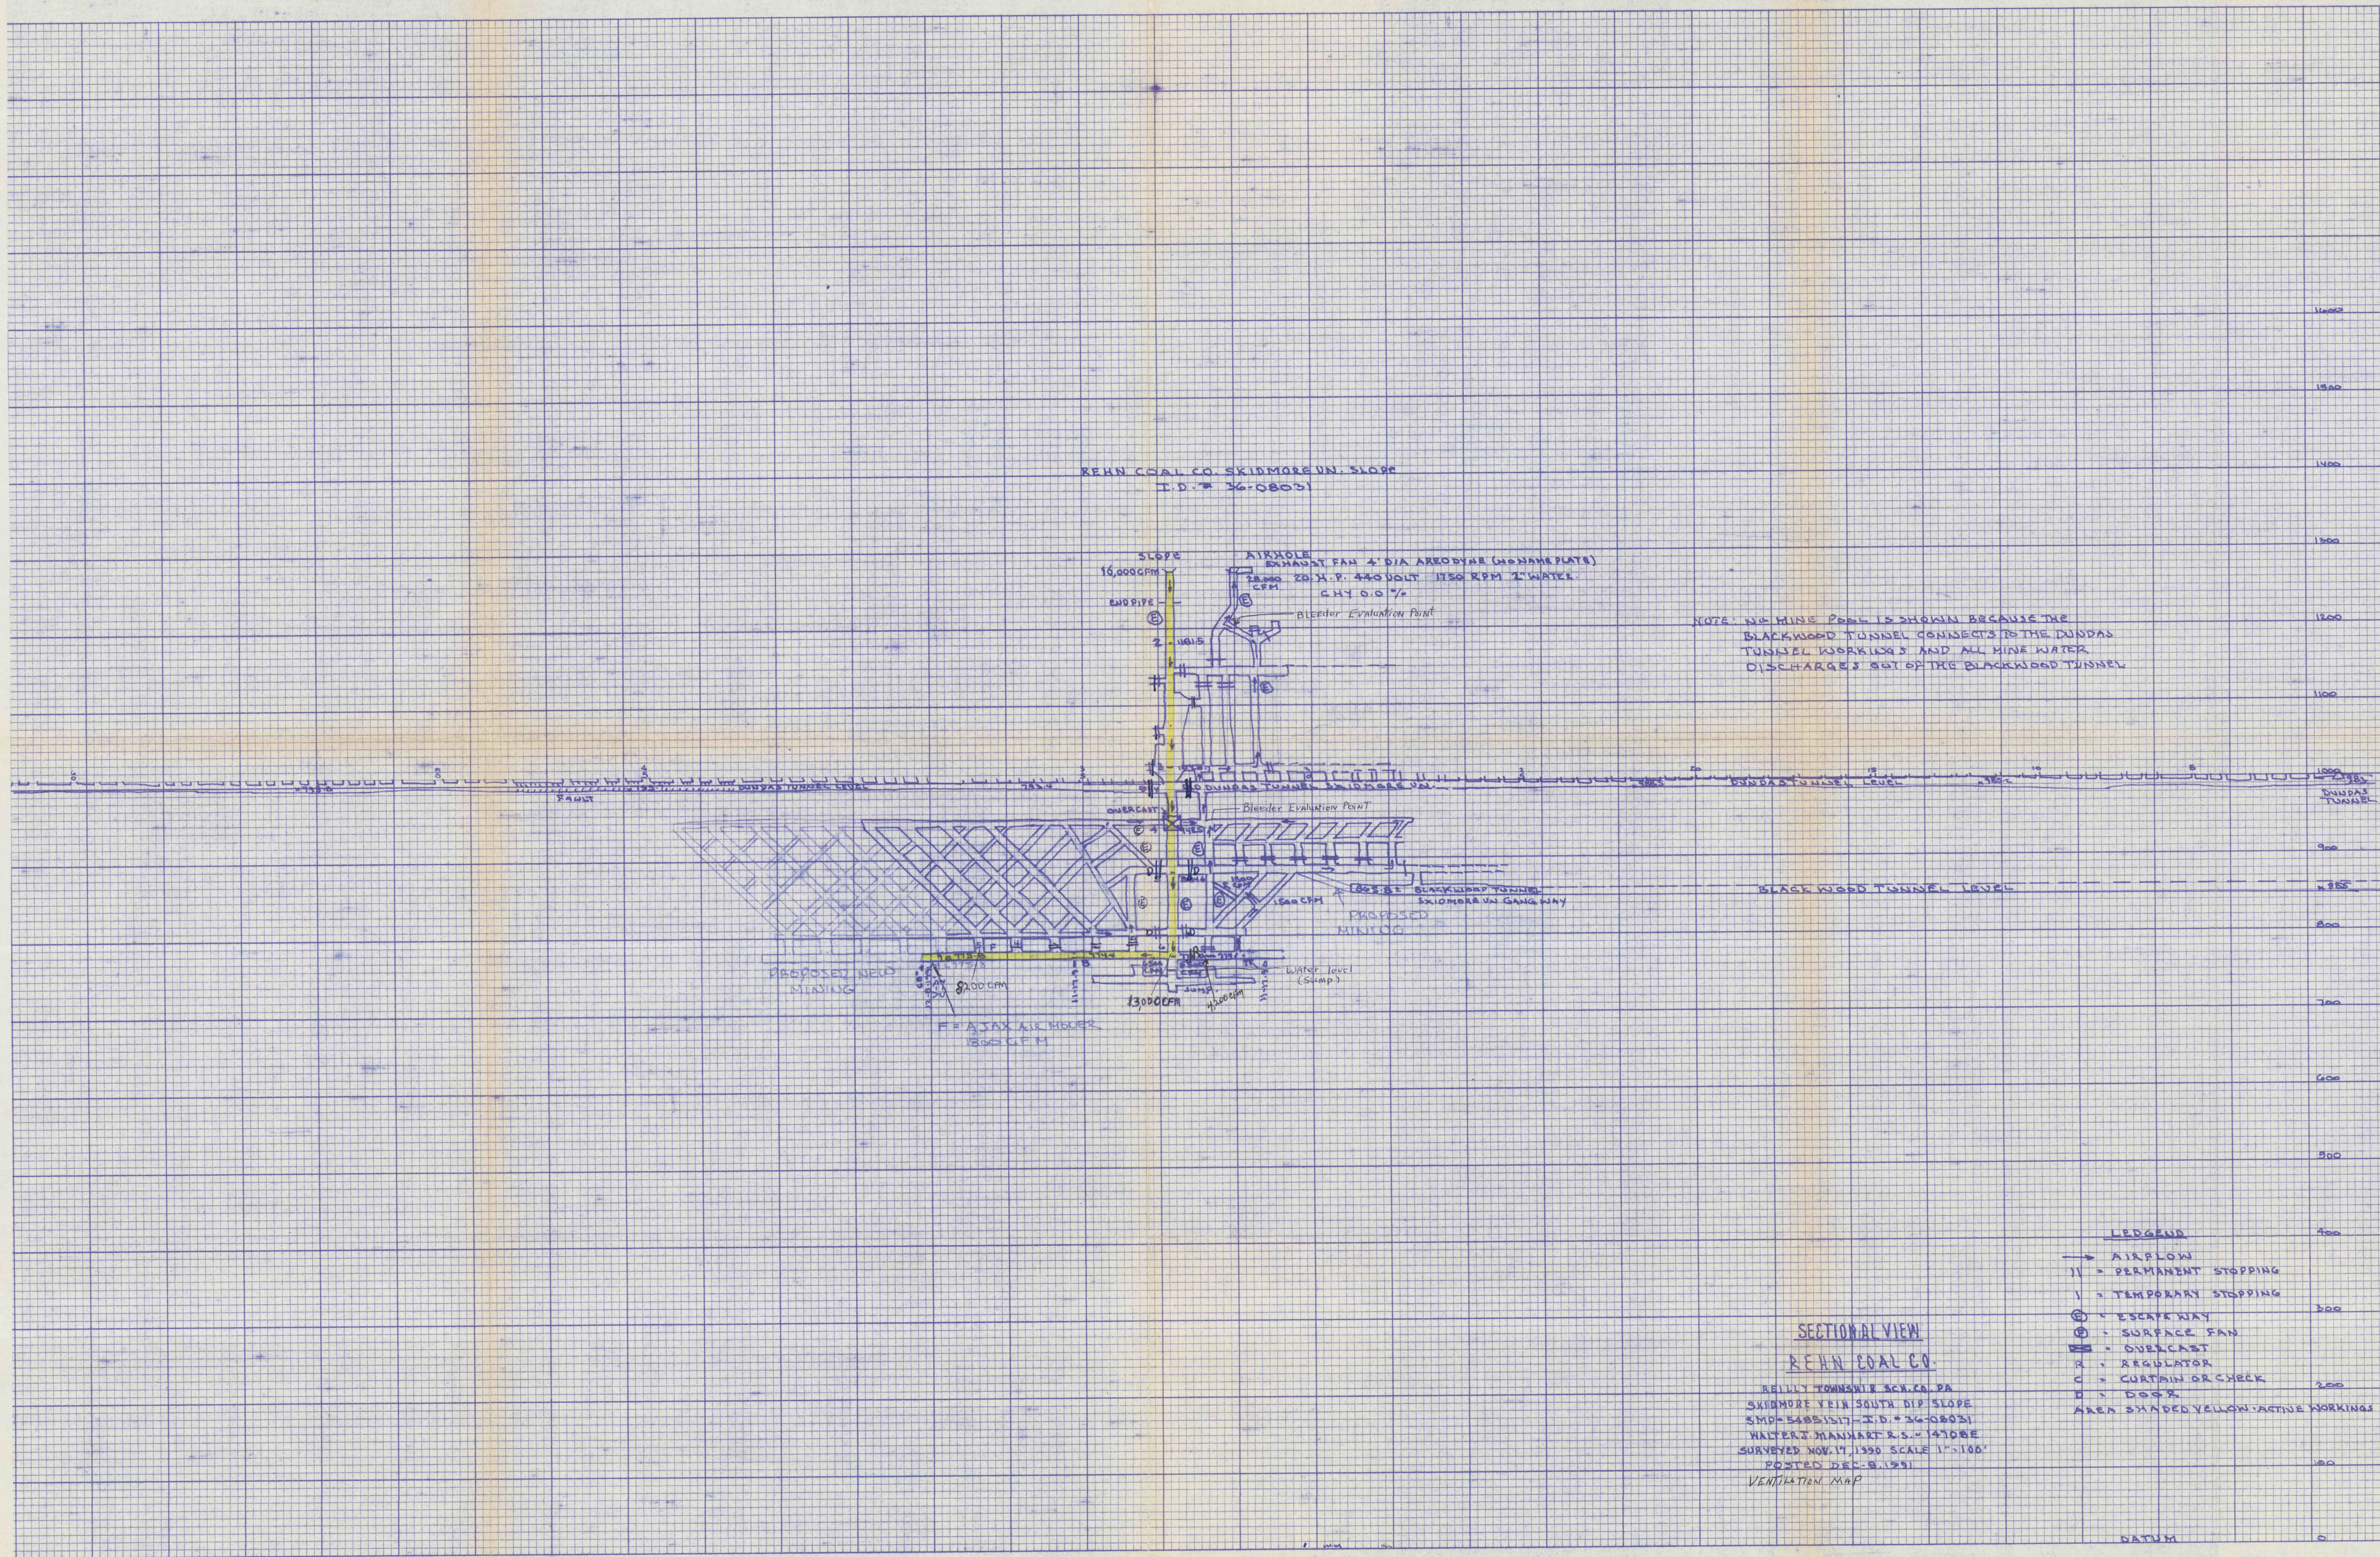


NOTE: NO MINE POOL IS SHOWN BECAUSE THE BLACKWOOD TUNNEL CONNECTS TO THE DUNDAS TUNNEL WORKINGS AND ALL MINE WATER DISCHARGES OUT OF THE BLACKWOOD TUNNEL

SECTIONAL VIEW
REHN COAL CO.

REHLY TOWNSHIP BEN. CO. PA.
SKIDMORE VEIN SOUTH DIP SLOPE
SMP-5485117-I.D. # 36-08031
WALTER J. MANNHART R.S. # 14708E
SURVEYED NOV. 17, 1930 SCALE 1"=100'
POSTED DEC. 8, 1931
VENTILATION MAP

- LEGEND**
- AIR FLOW
 - || = PERMANENT STOPPING
 - | = TEMPORARY STOPPING
 - ⊙ = ESCAPE WAY
 - ⊙ = SURFACE FAN
 - ⊞ = OVERCAST
 - R = REGULATOR
 - C = CURTAIN OR CHECK
 - D = DOOR
 - AREA SHADED YELLOW = ACTIVE WORKINGS

DATUM

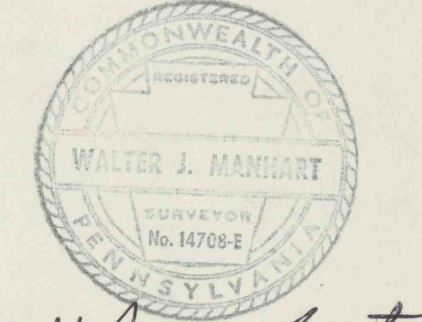

Walter J. Mannhart

EUGENE DIETZEN CO.
ON CLOTH MADE IN U.S.A.
PRINTED IN U.S.A.

EUGENE DIETZEN CO.
ON CLOTH MADE IN U.S.A.
PRINTED IN U.S.A.

EUGENE DIETZEN CO.
ON CLOTH MADE IN U.S.A.
PRINTED IN U.S.A.