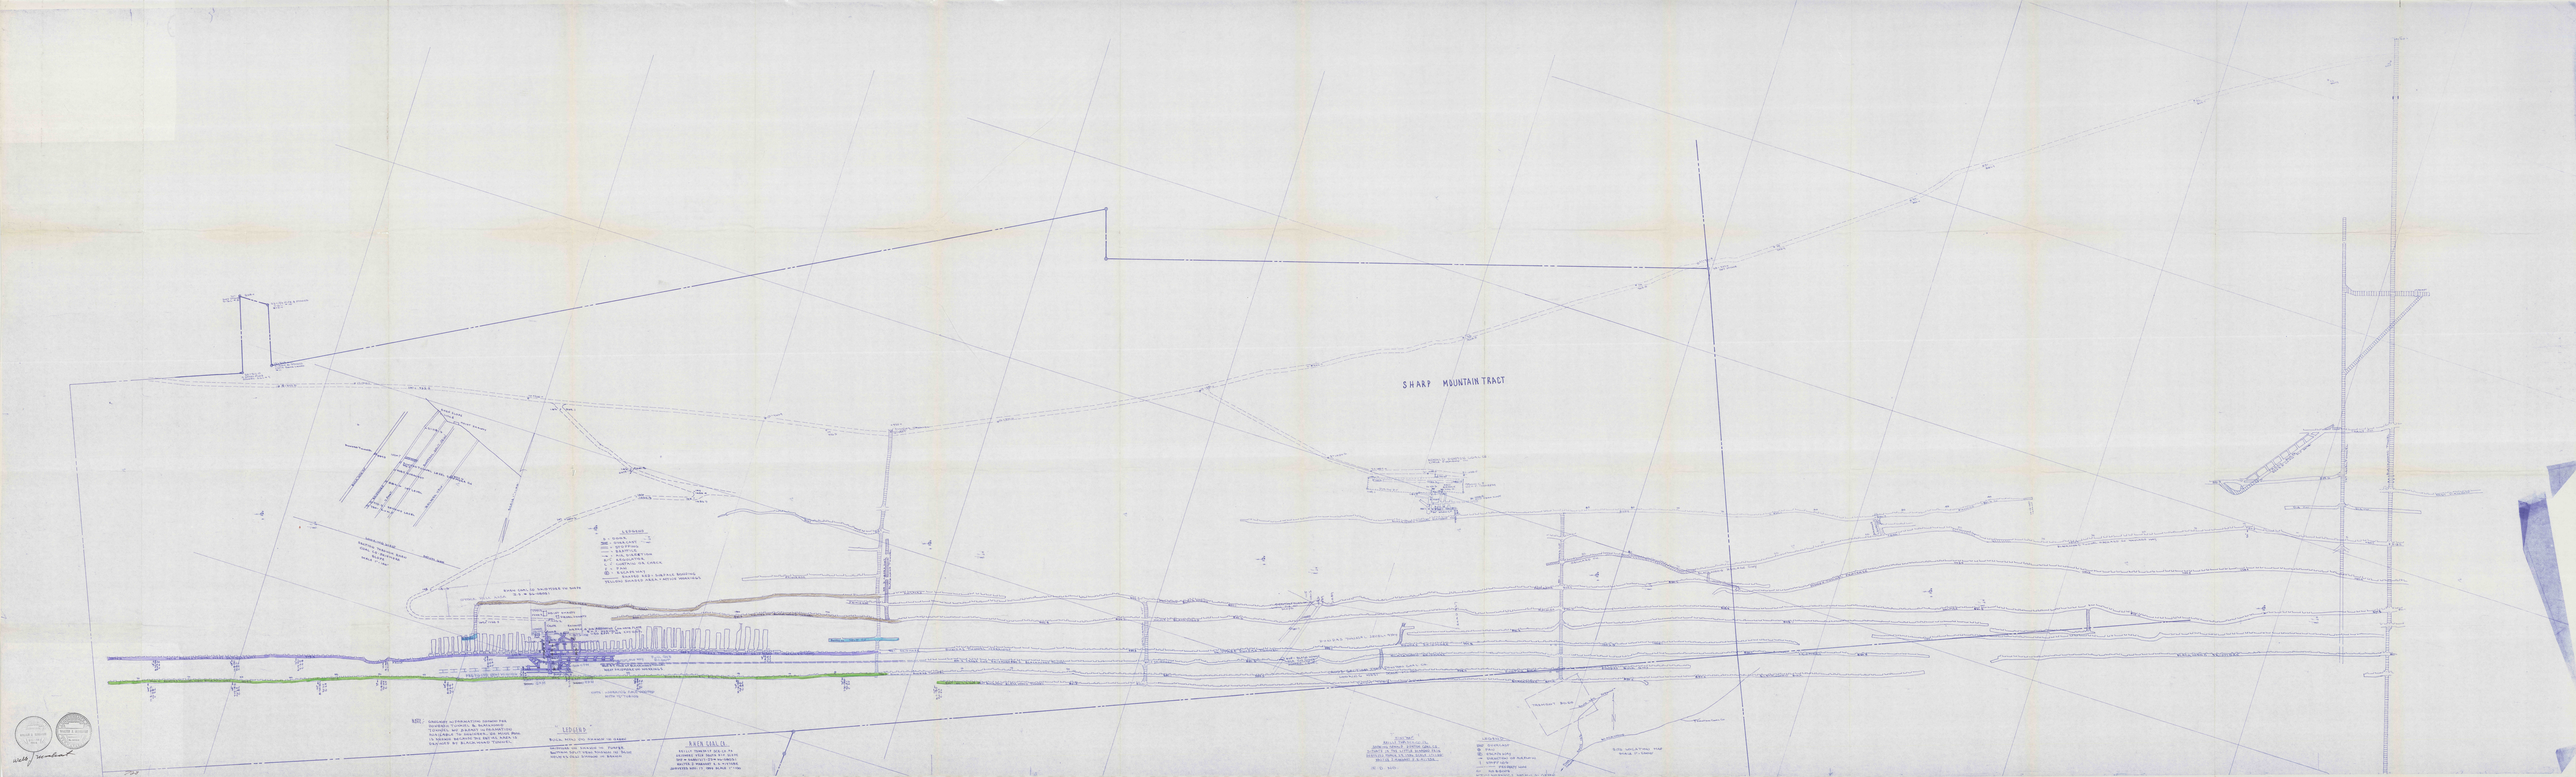

SHARP MOUNTAIN TRACT