


BLYTHE TWP WATER CO
PUBLIC ROAD

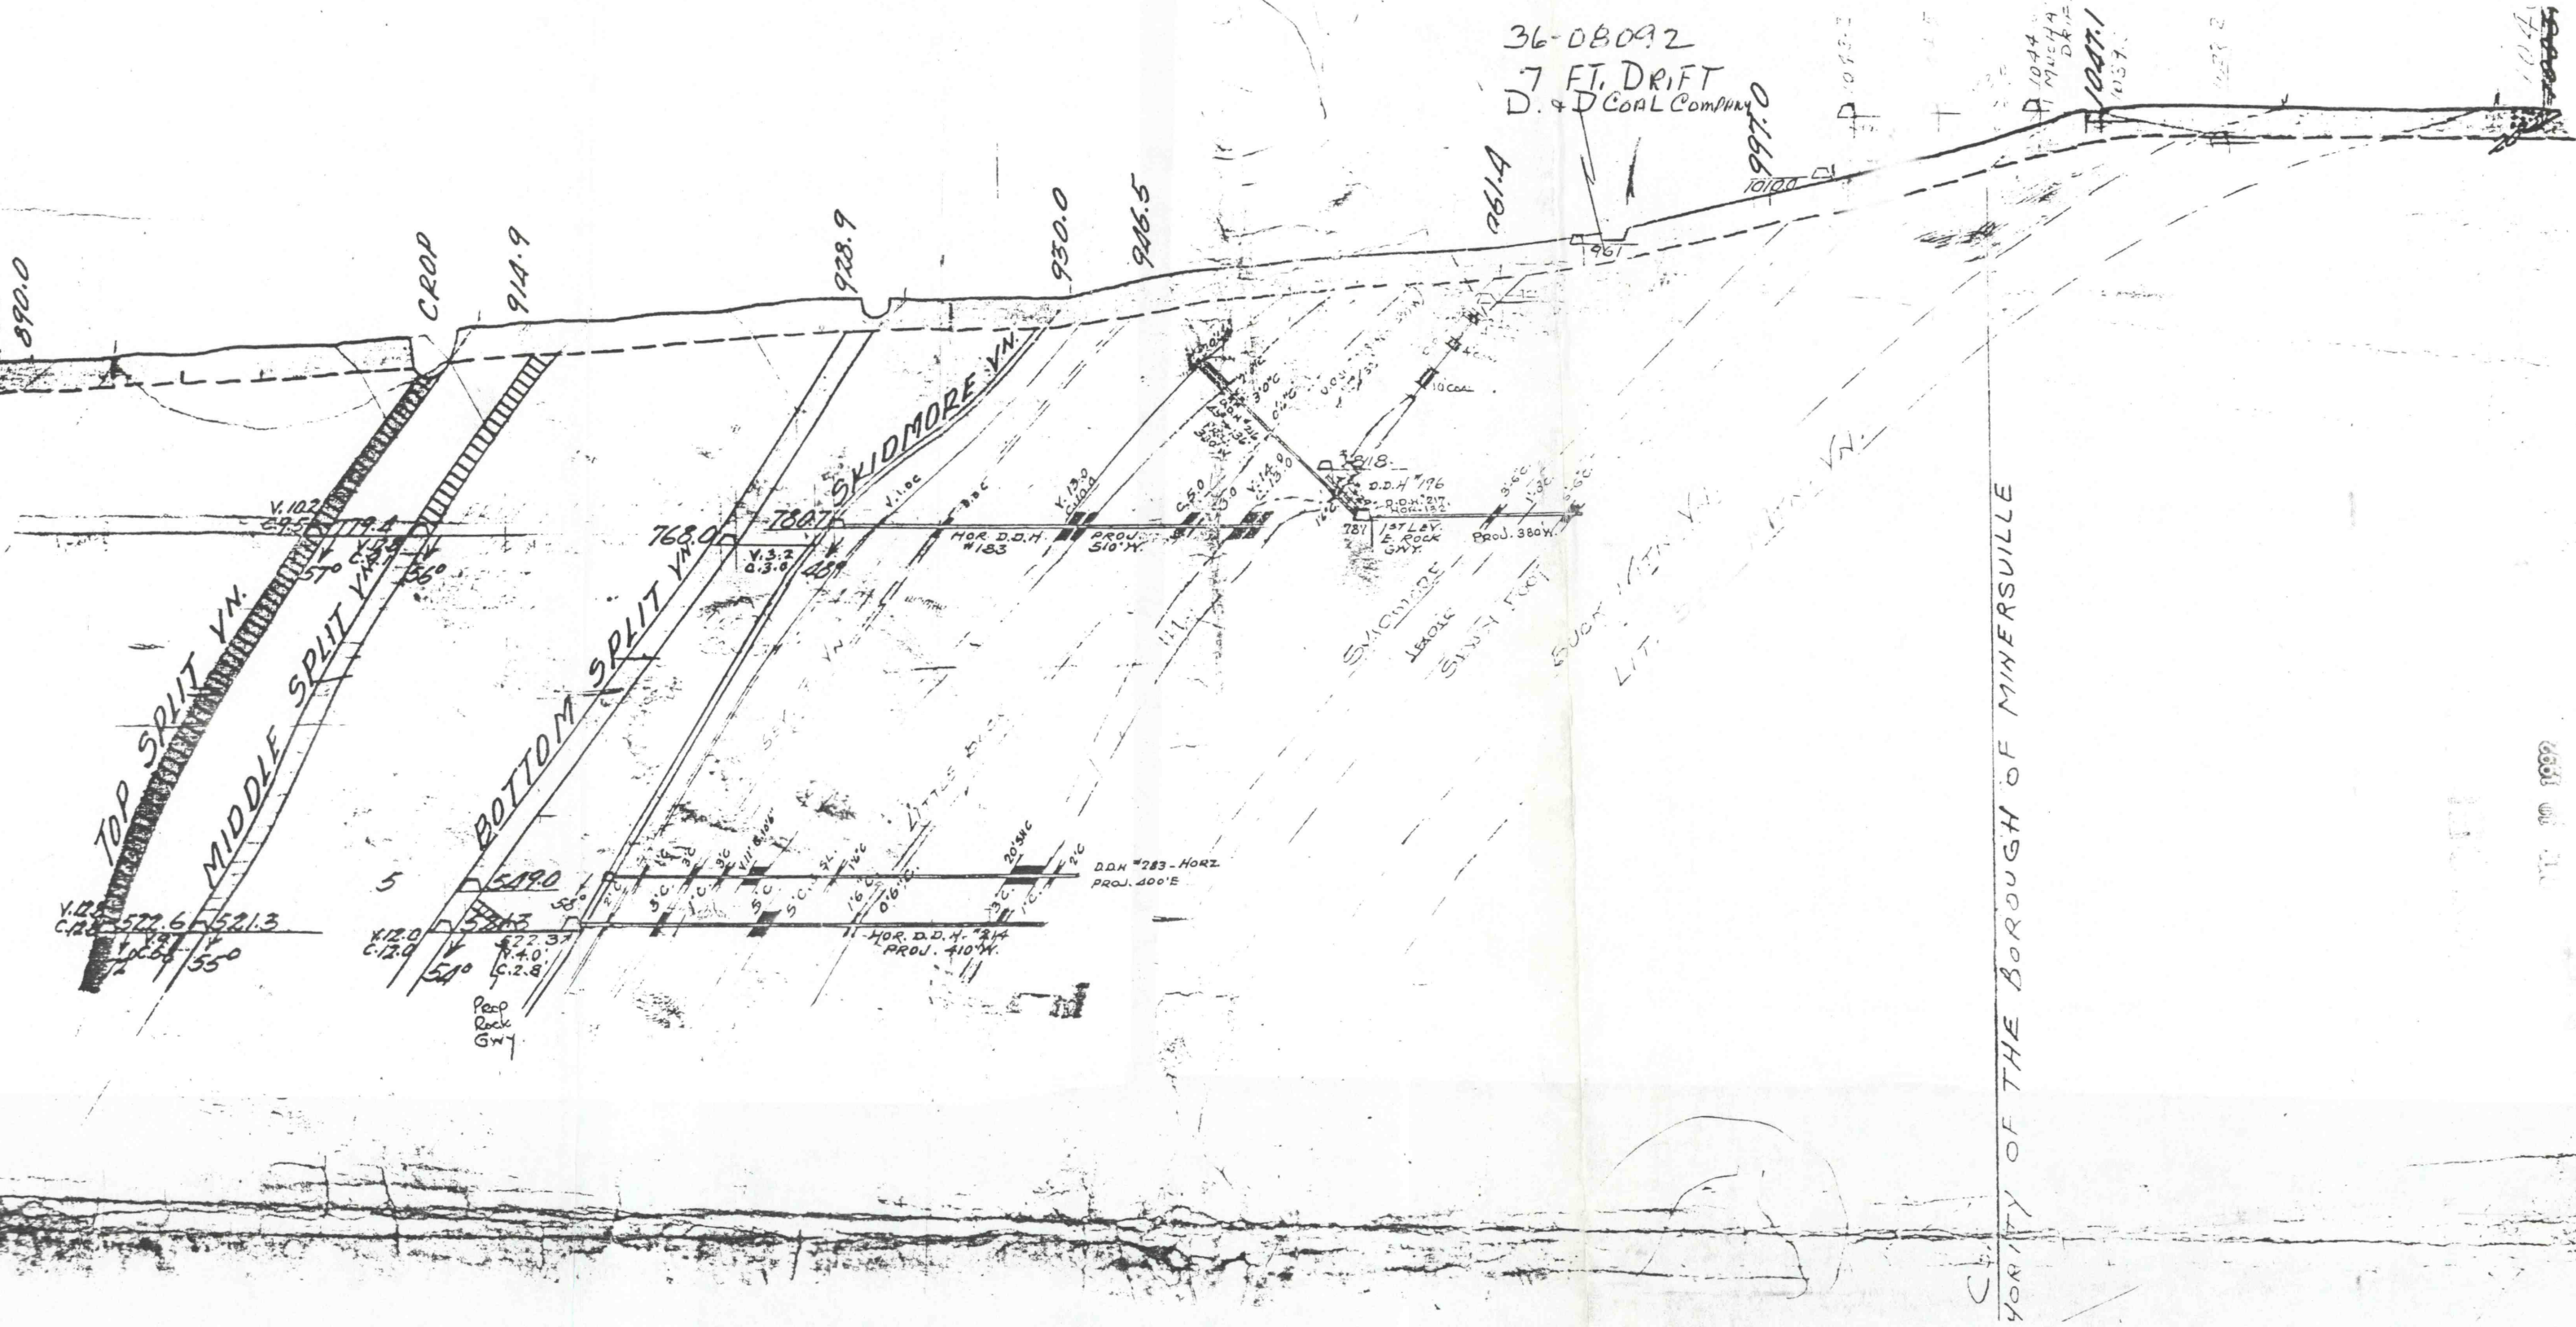

CITY OF THE BOROUGH OF MINERSVILLE