


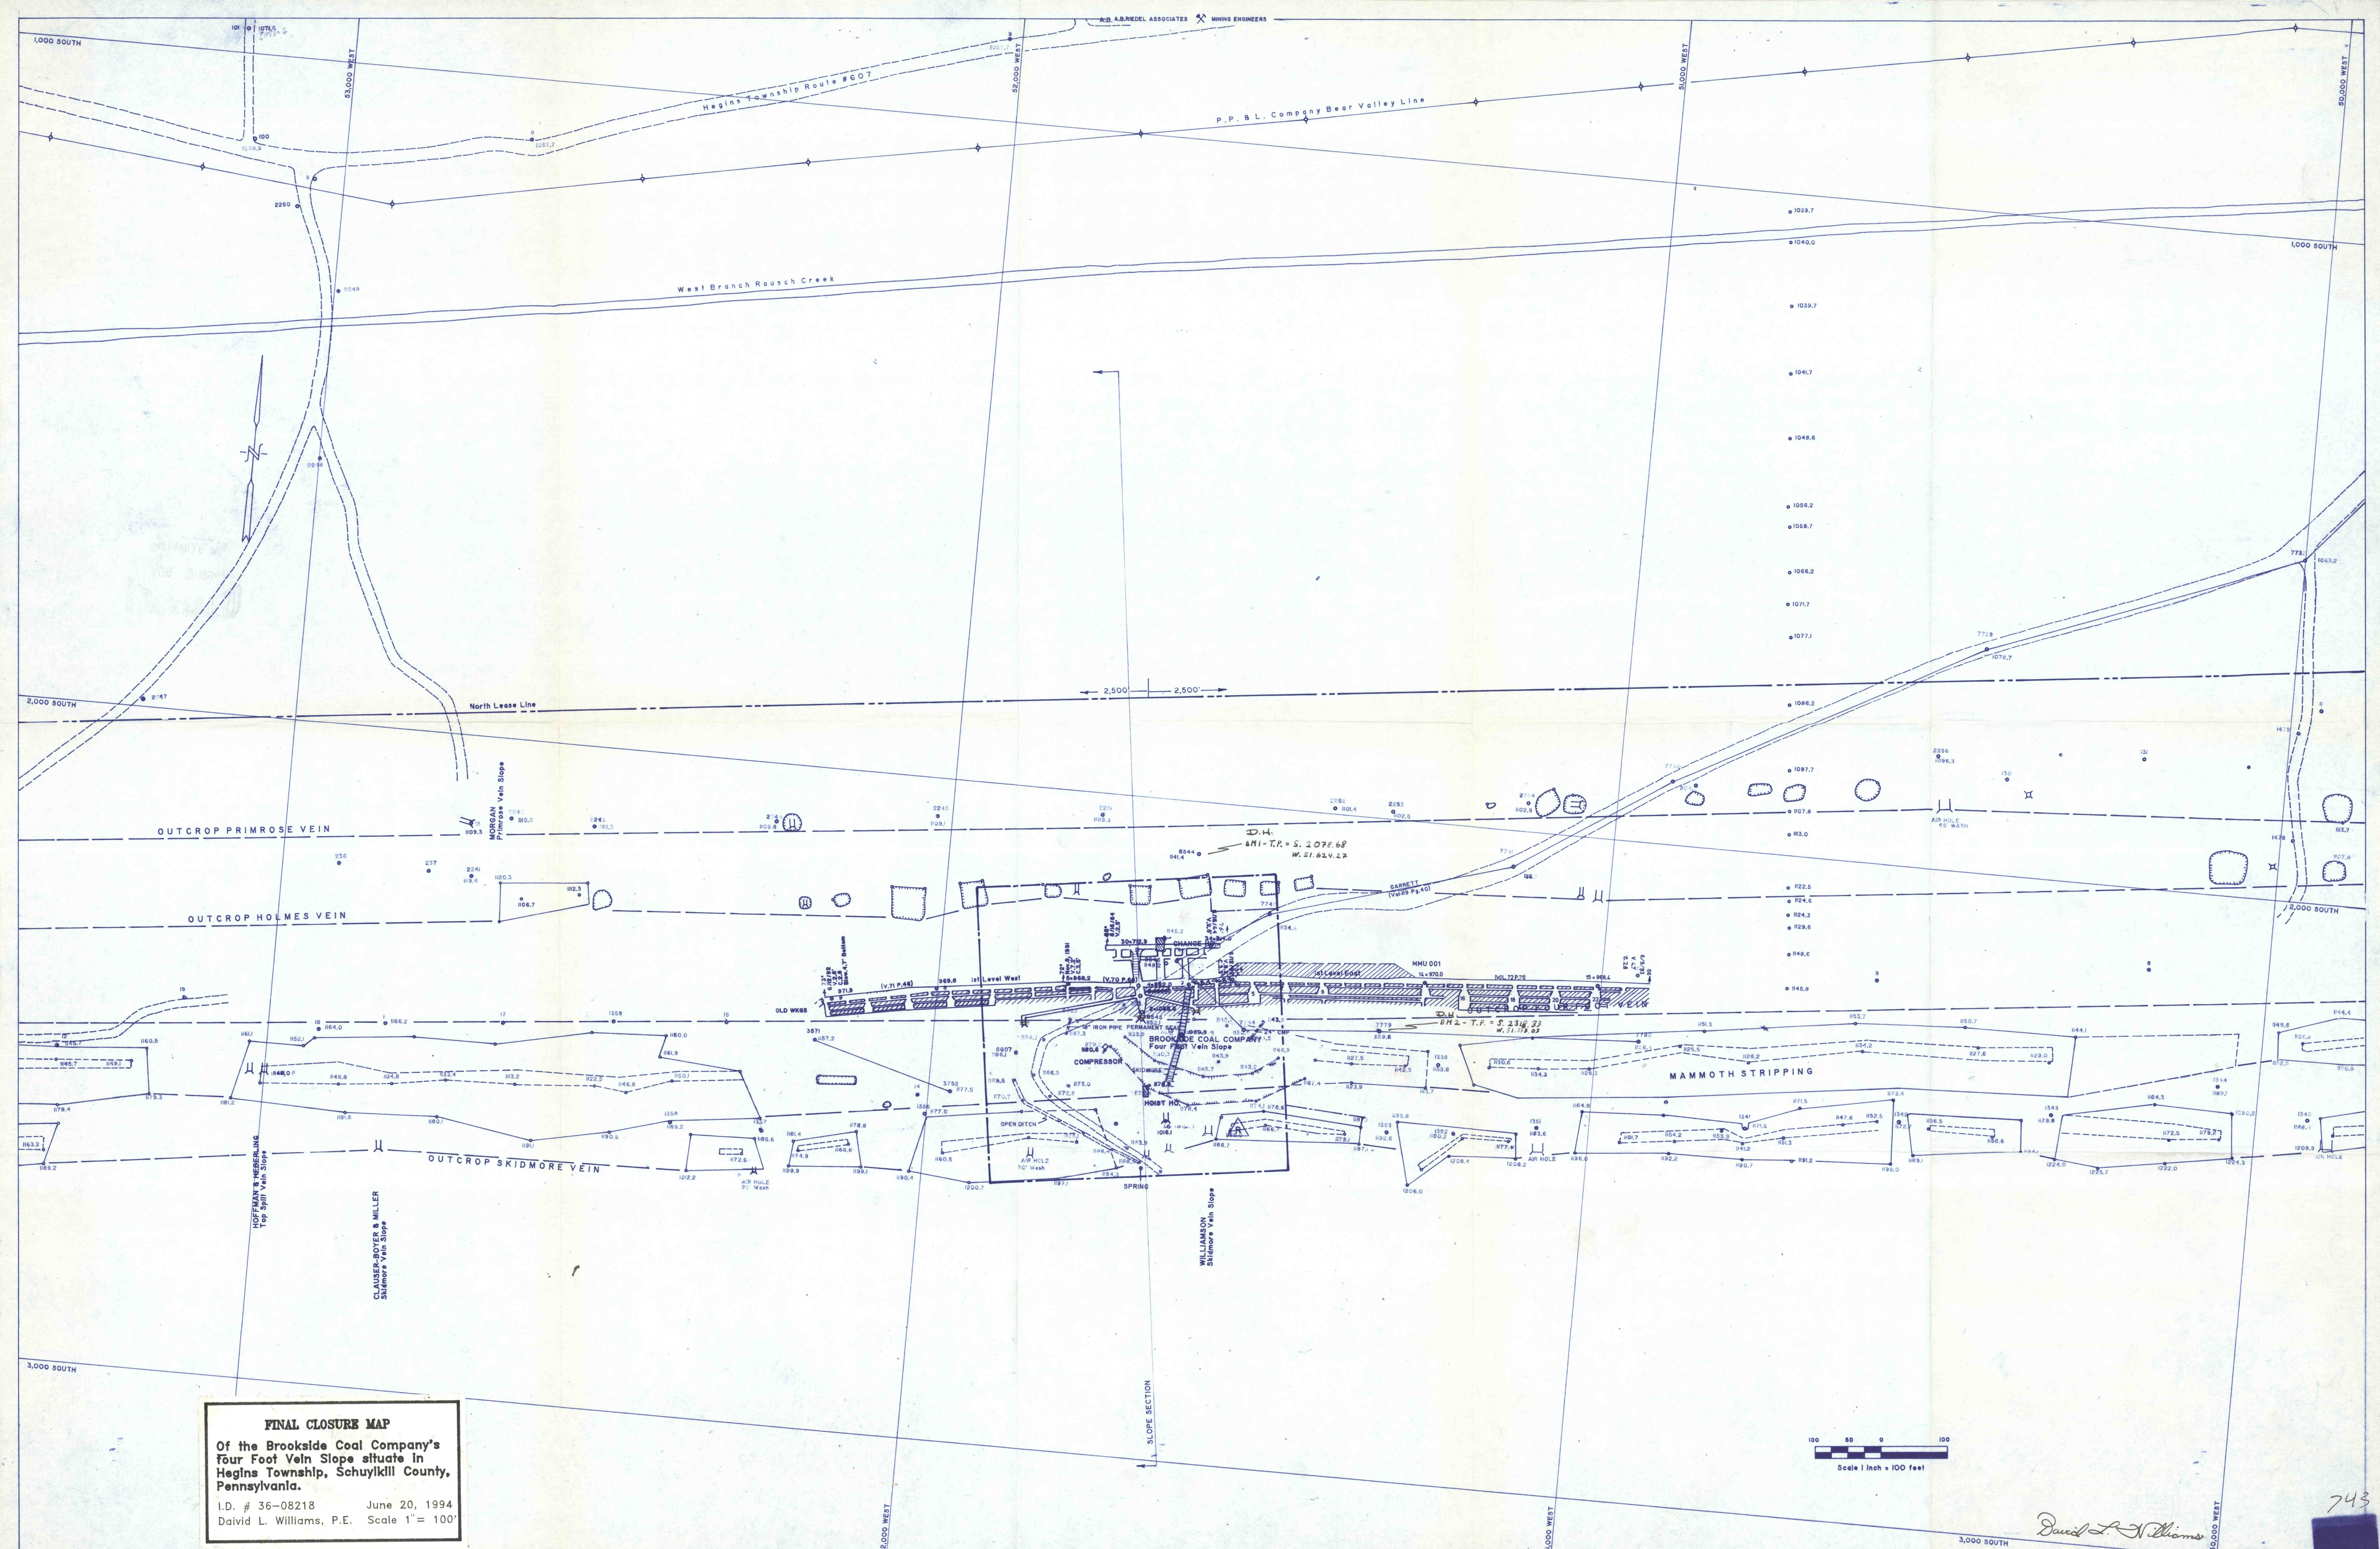

FINAL CLOSURE MAP
Of the Brookside Coal Company's
Four Foot Vein Slope situate in
Hegins Township, Schuylkill County,
Pennsylvania.
I.D. # 36-08218 June 20, 1994
Daivid L. Williams, P.E. Scale 1" = 100'

100 50 0 100
Scale 1 inch = 100 feet

David L. Williams