


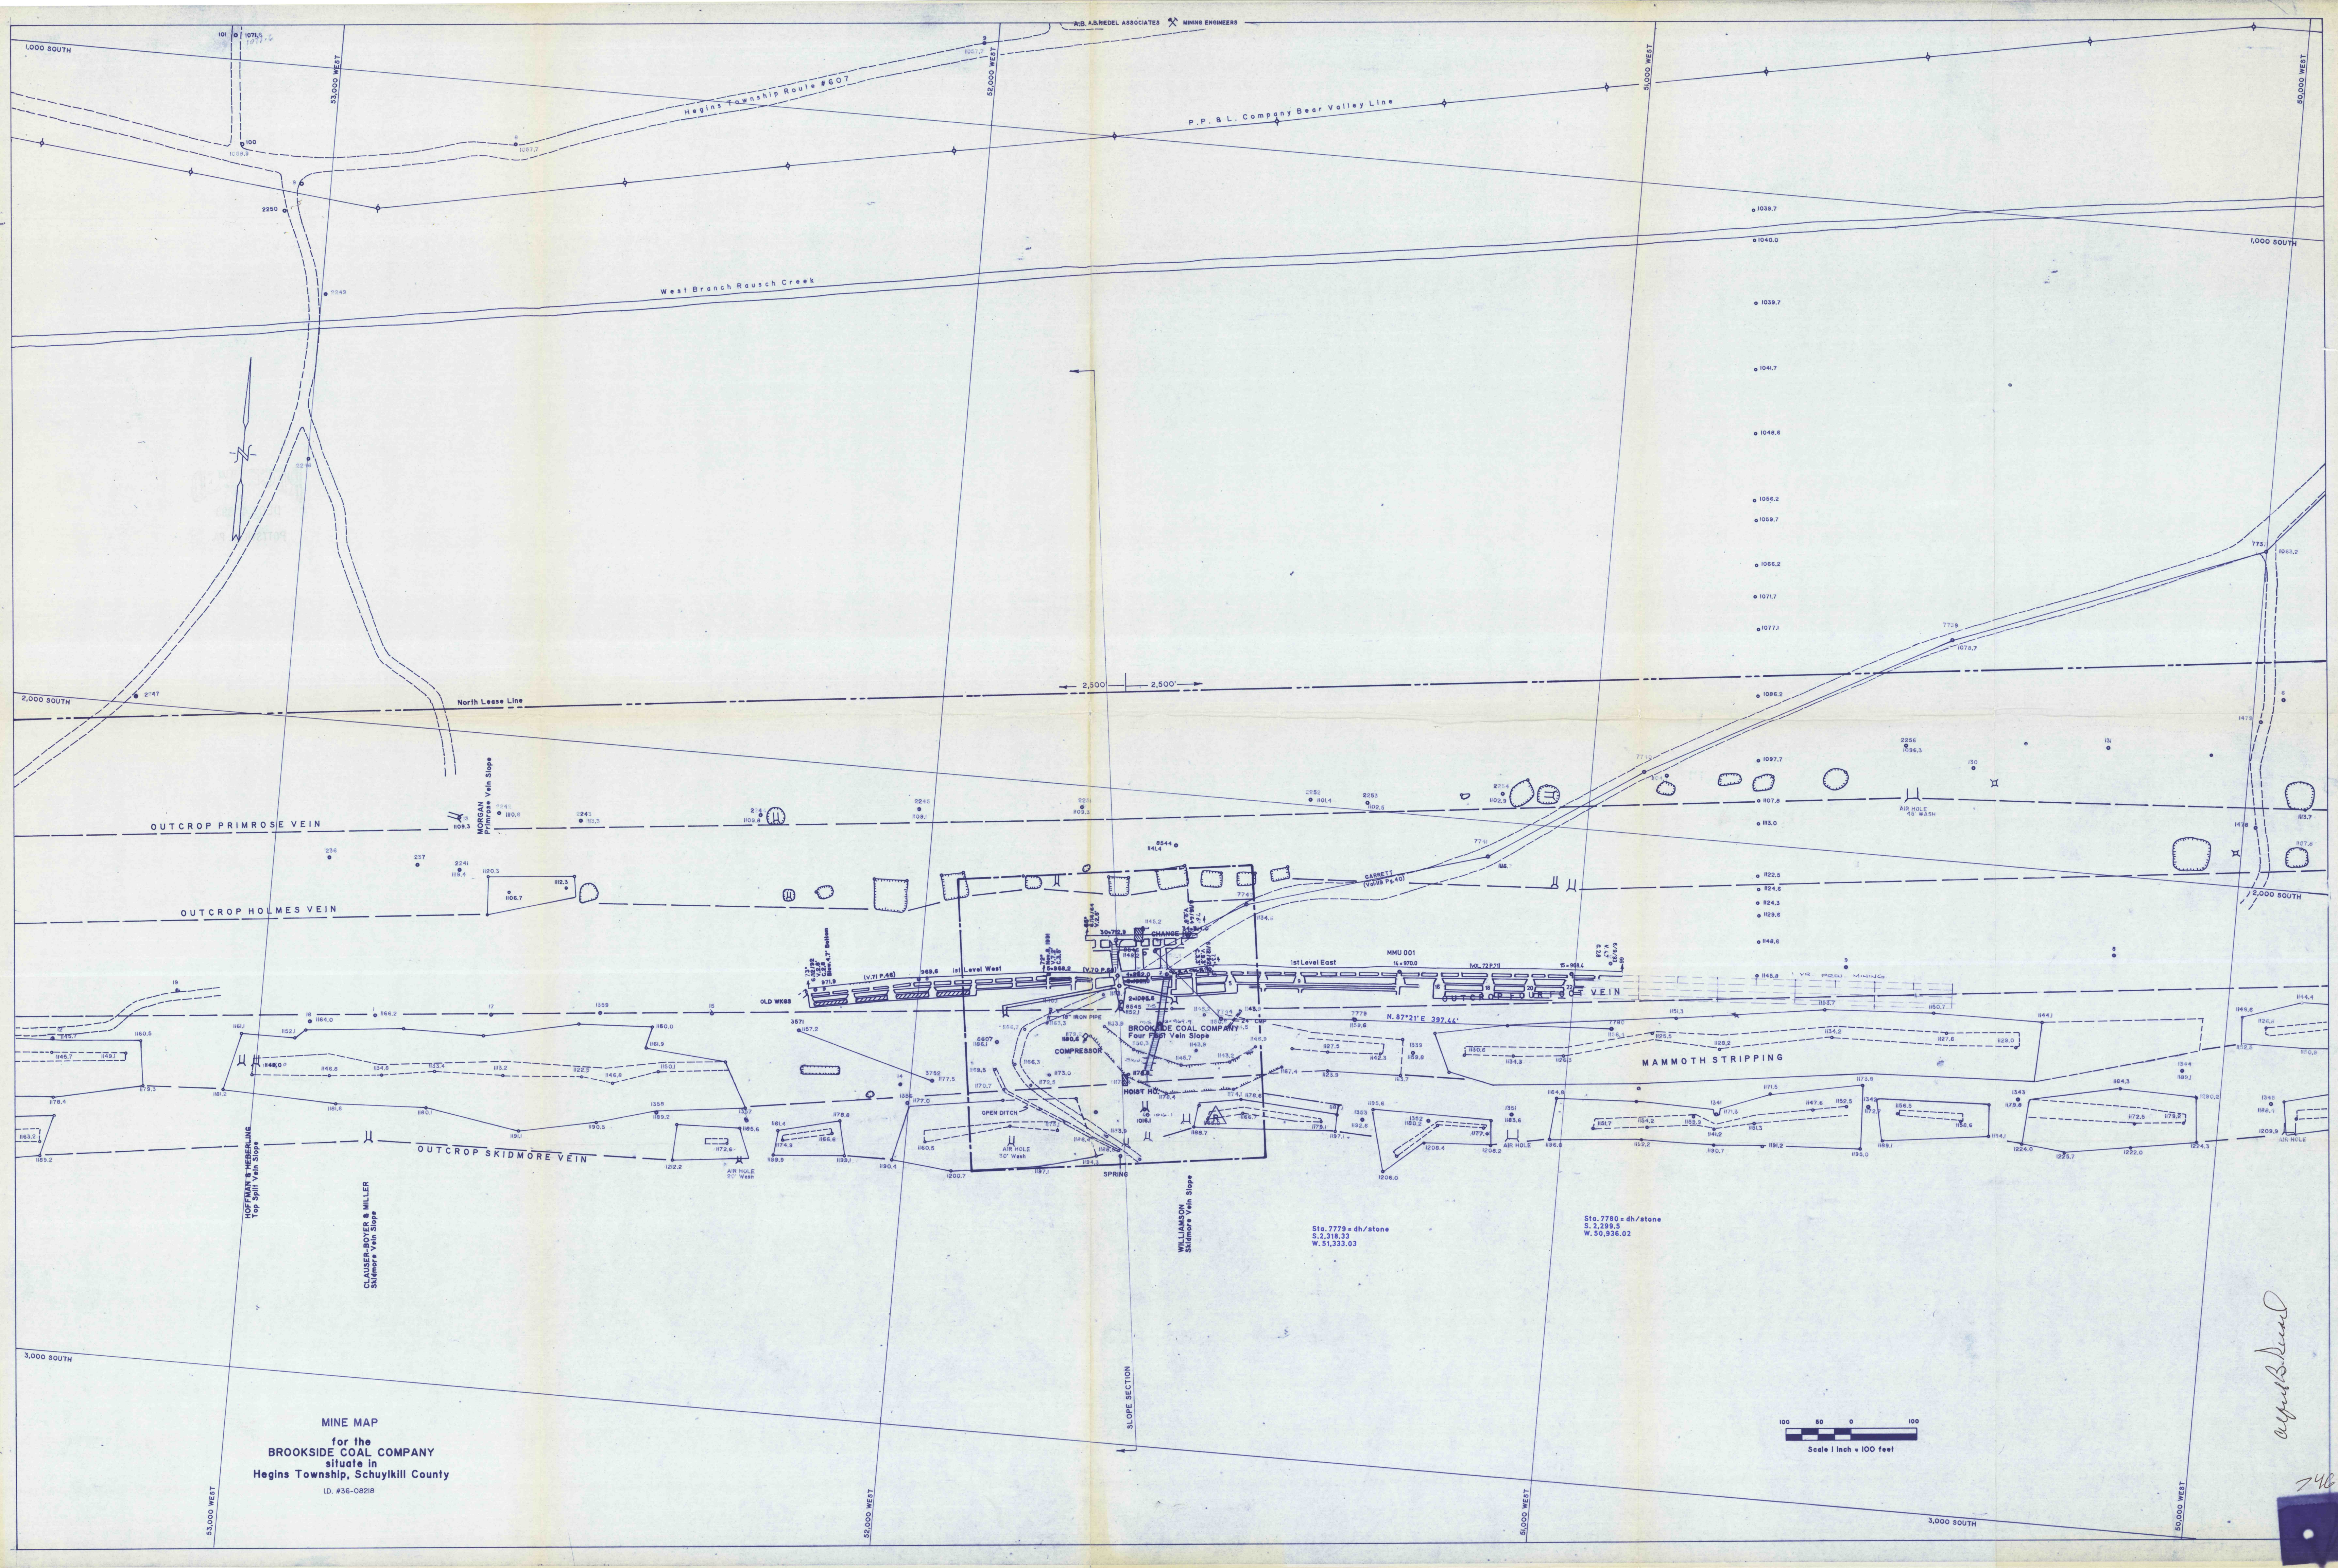

MINE MAP
for the
BROOKSIDE COAL COMPANY
situate in
Hegins Township, Schuylkill County
ID. #36-0218

Scale 1 inch = 100 feet

agued