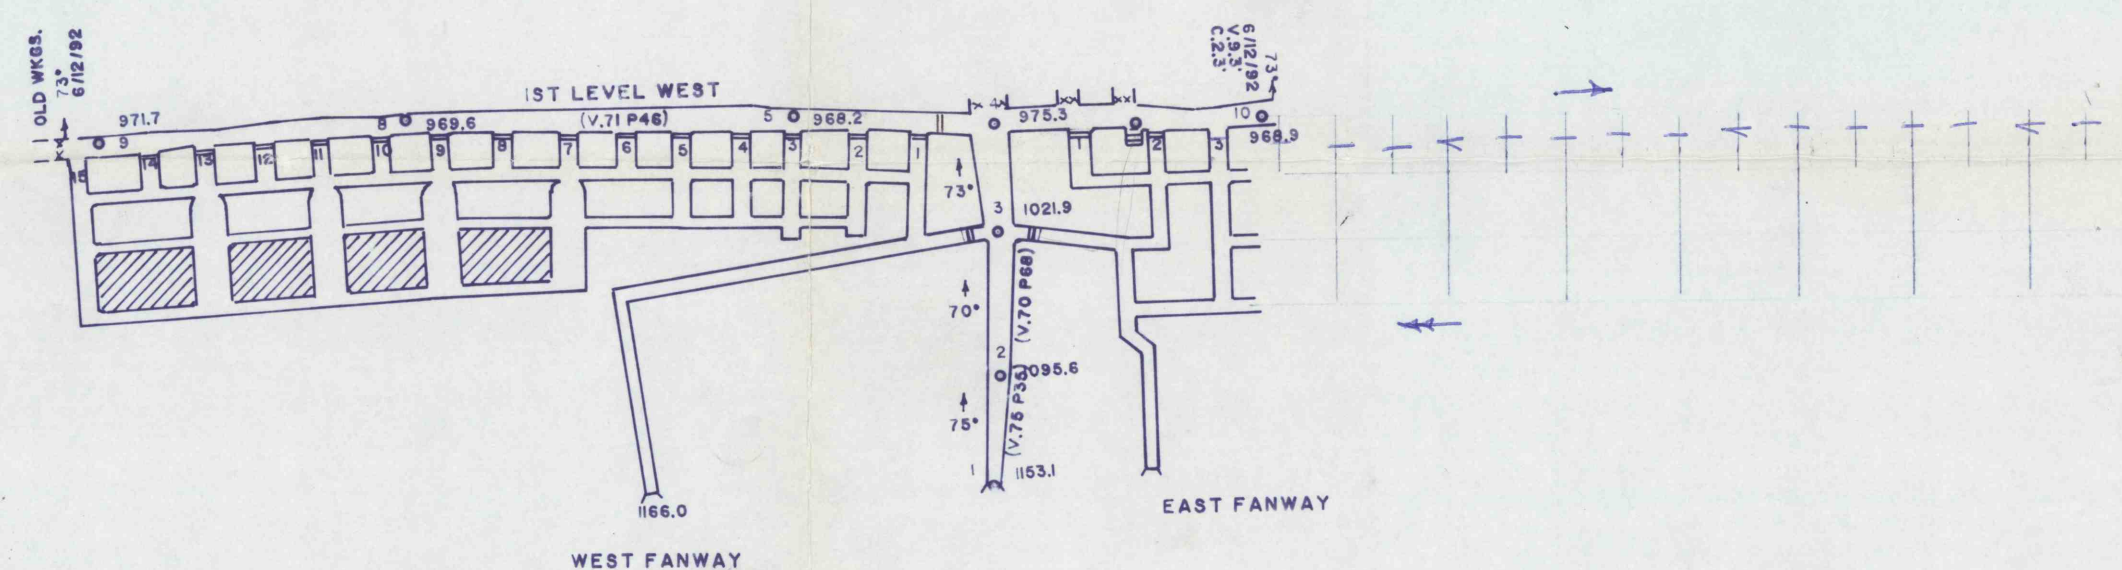


DATE RECEIVED
Pottsville 7/3/72
Shamokin
Wilkes-Barre

LONGITUDINAL SECTION
Through Mine Workings of the
Brookside Coal Company
situate in
Hegins Township, Schuylkill County

Arthur B. Riedel