
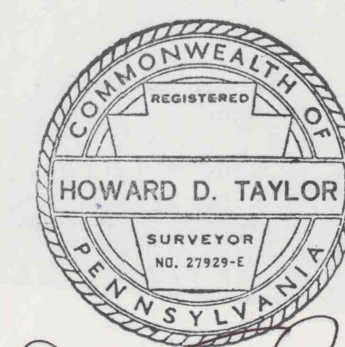


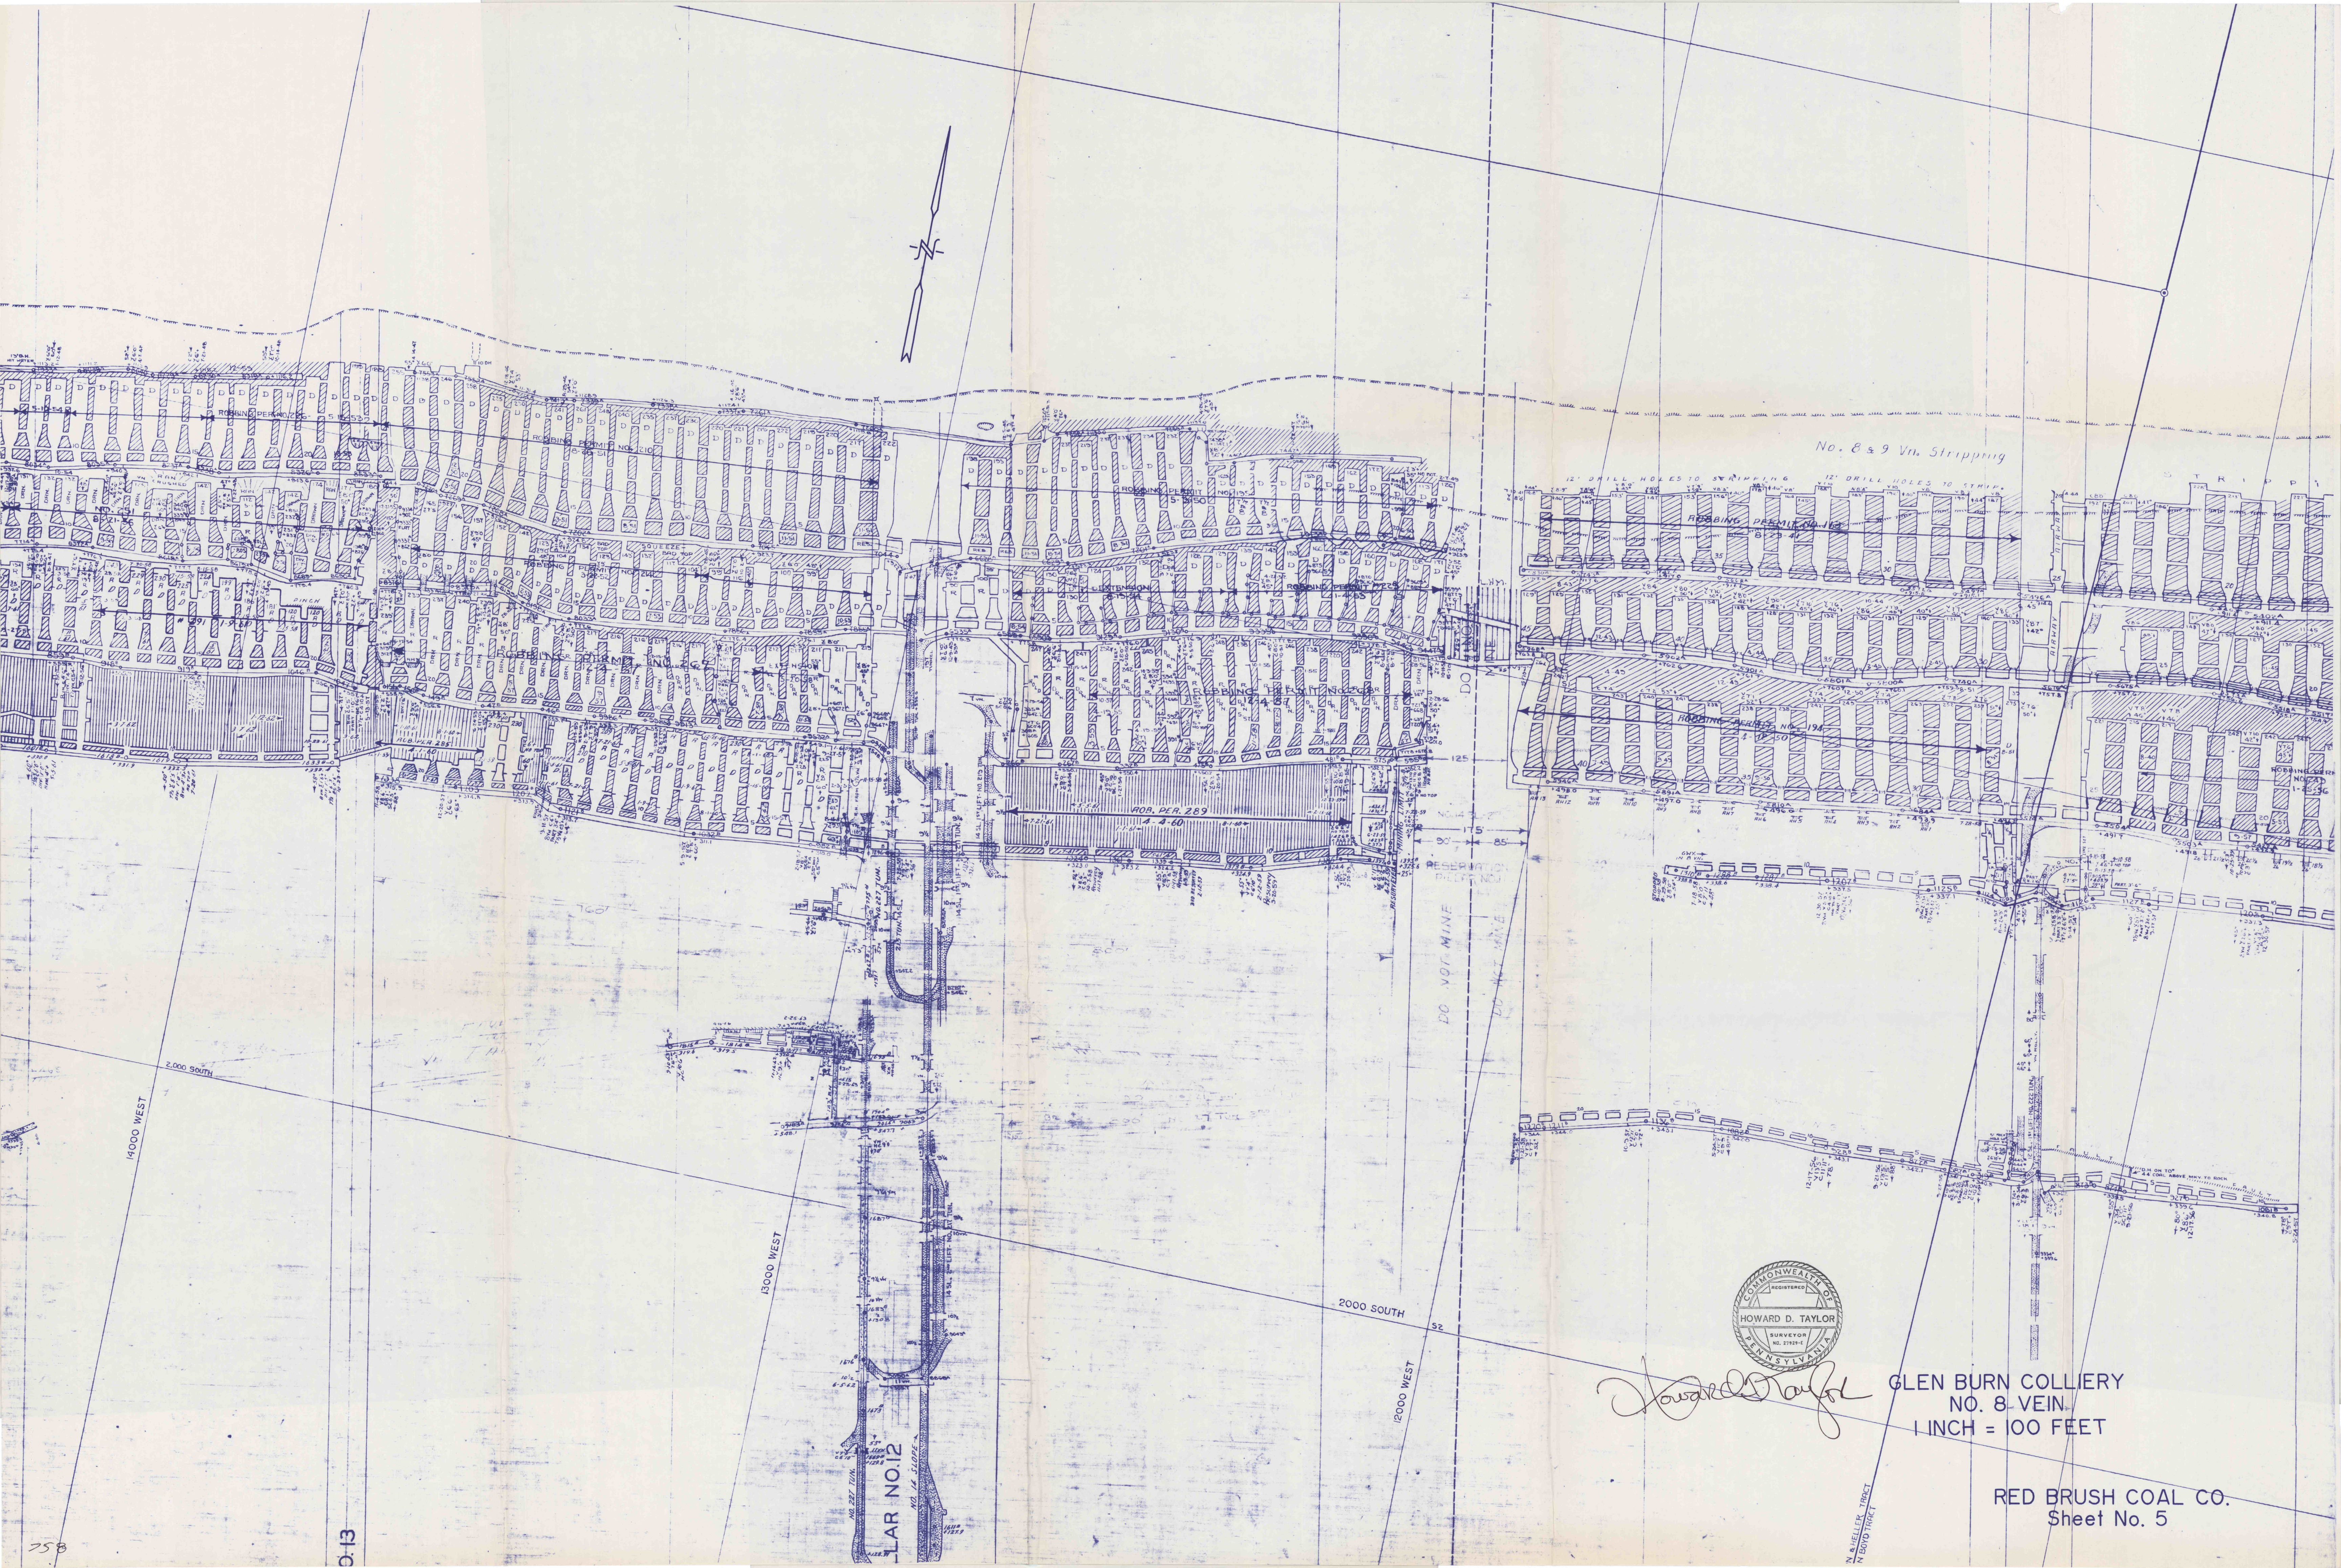

Howard D. Taylor

GLEN BURN COLLIERY
NO. 8-VEIN.
1 INCH = 100 FEET

RED BRUSH COAL CO.
Sheet No. 5