


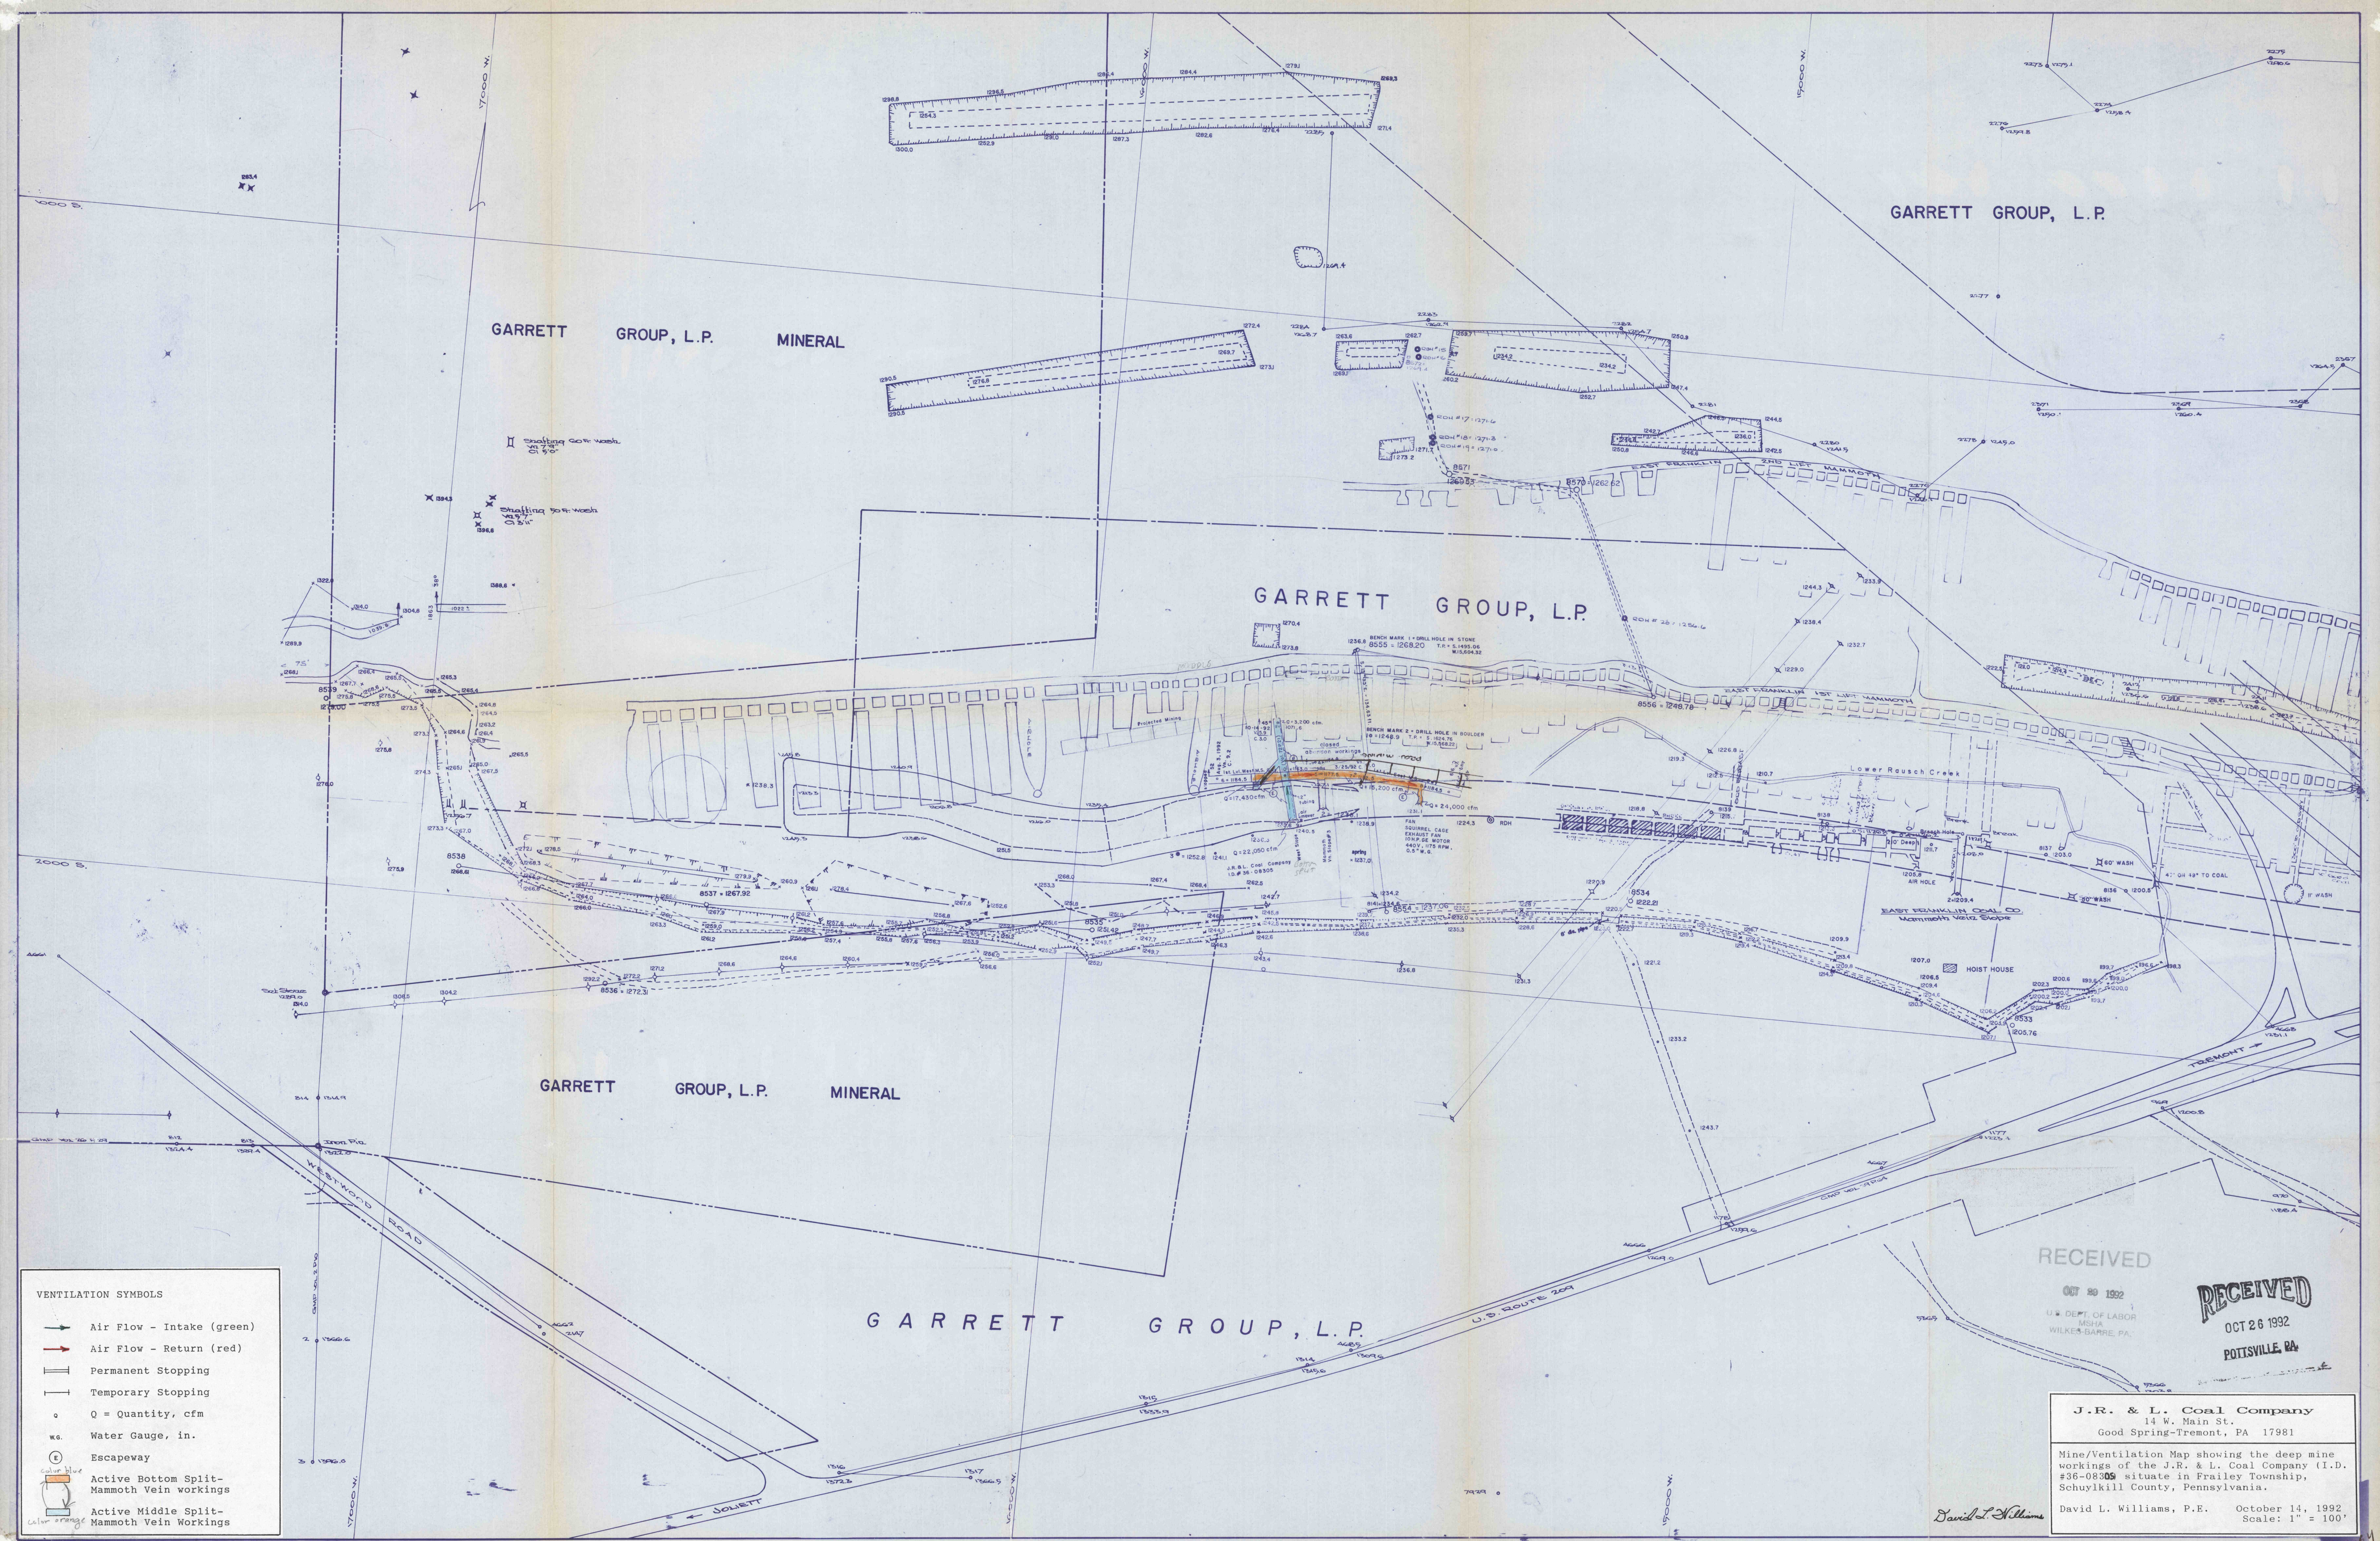

VENTILATION SYMBOLS

- Air Flow - Intake (green)
- Air Flow - Return (red)
- Permanent Stopping
- Temporary Stopping
- Q = Quantity, cfm
- W.G. = Water Gauge, in.
- Escapeway
- Active Bottom Split-Mammoth Vein workings
- Active Middle Split-Mammoth Vein Workings

RECEIVED
OCT 26 1992
POTTSVILLE, PA

David L. Williams

J.R. & L. Coal Company
14 W. Main St.
Good Spring-Tremont, PA 17981

Mine/Ventilation Map showing the deep mine workings of the J.R. & L. Coal Company (I.D. #36-08309) situated in Frailey Township, Schuylkill County, Pennsylvania.

David L. Williams, P.E. October 14, 1992
Scale: 1" = 100'