
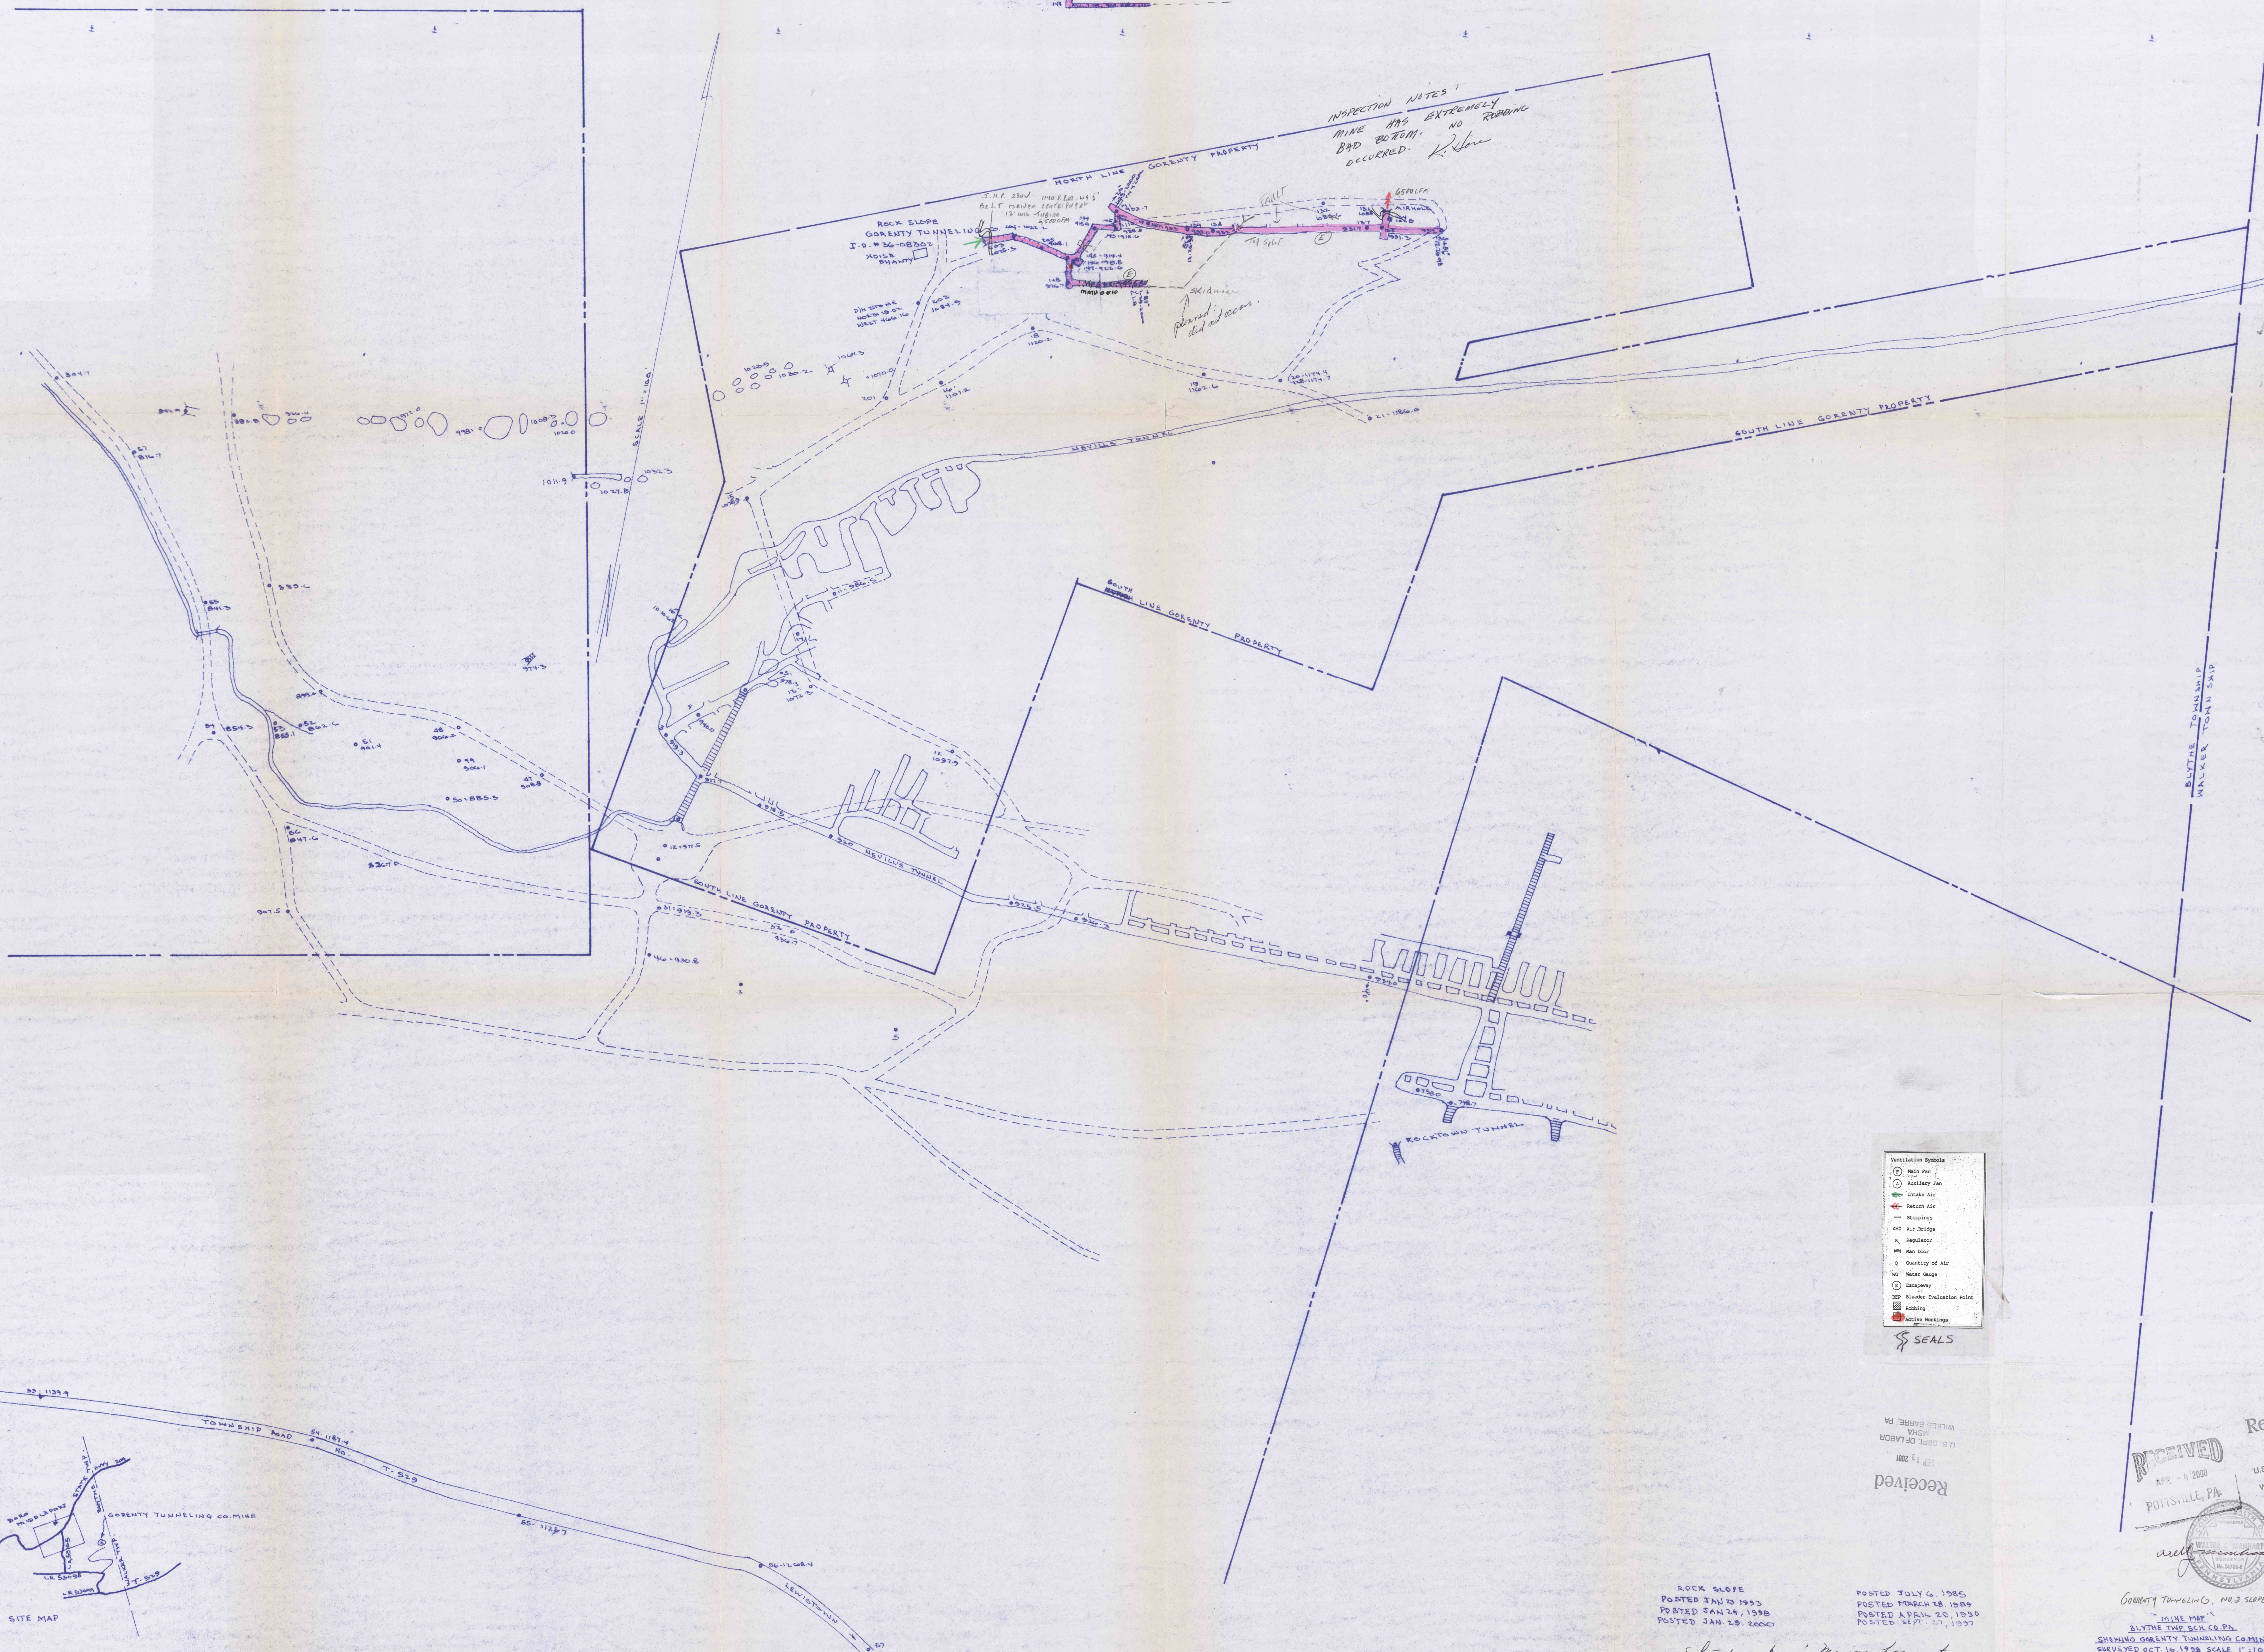


28208

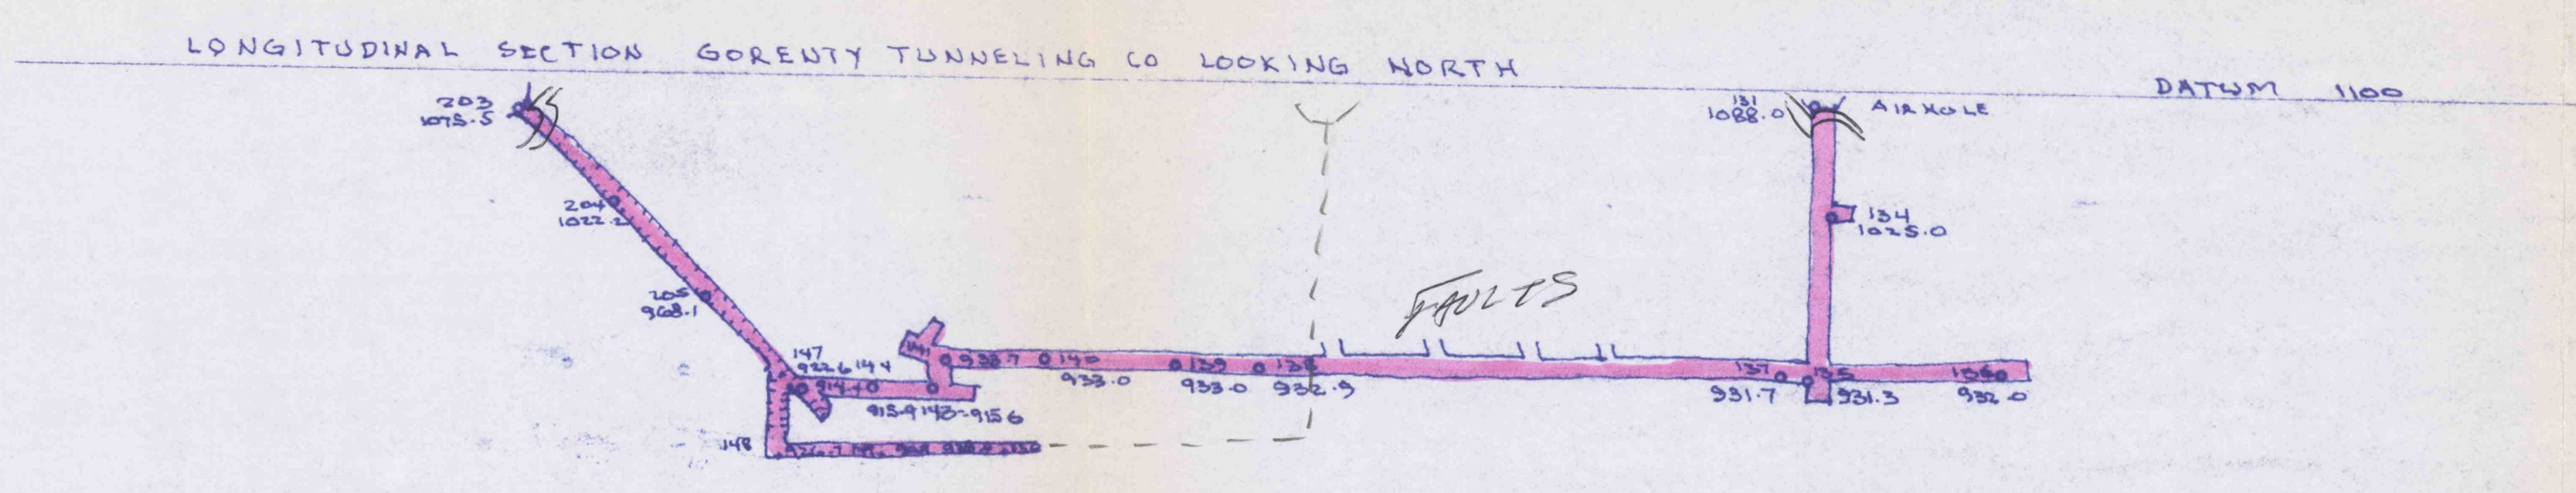

INSPECTION NOTES:
MINE HAS EXTREMELY
BAD BOTTOM. NO ROBBING
OCCURRED. R. L. R.

- VENTILATION SYMBOLS**
- ① Main Fan
 - ② Auxiliary Fan
 - ③ Intake Air
 - ④ Return Air
 - ⑤ Occupancy
 - ⑥ Air Scribe
 - ⑦ Regulator
 - ⑧ Man Door
 - ⑨ Quantity of Air
 - ⑩ Water Gauge
 - ⑪ Emergency
 - ⑫ Blower Evaluation Point
 - ⑬ Rooking
 - ⑭ Air Meters

Received
APR 1 1985
U.S. DEPT. OF LABOR
POTTSVILLE, PA.

Received
MAY 23 2000
U.S. DEPT. OF LABOR
MIDVA
WILKES-BARRE, PA.

ROCK SLOPE
POSTED JAN 13 1985
POSTED JAN 24 1985
POSTED JAN 28 2000

POSTED JULY 6 1985
POSTED MARCH 18 1985
POSTED APRIL 20 1985
POSTED APR 27 1987

final map: Mining has not
started since the
very early part of 2000.
R. L. R.

GORENTY TUNNELING CO. NO. 2 SHAFT
MINE NO. 1
BLITHES TOWNSHIP, CO. PA.
SHEWING GORENTY TUNNELING CO. MINE
SHEWING OCT 16 1922 SCALE 1"=100'
MASTER J. W. WILKES-BARRE, PA. 110524

