


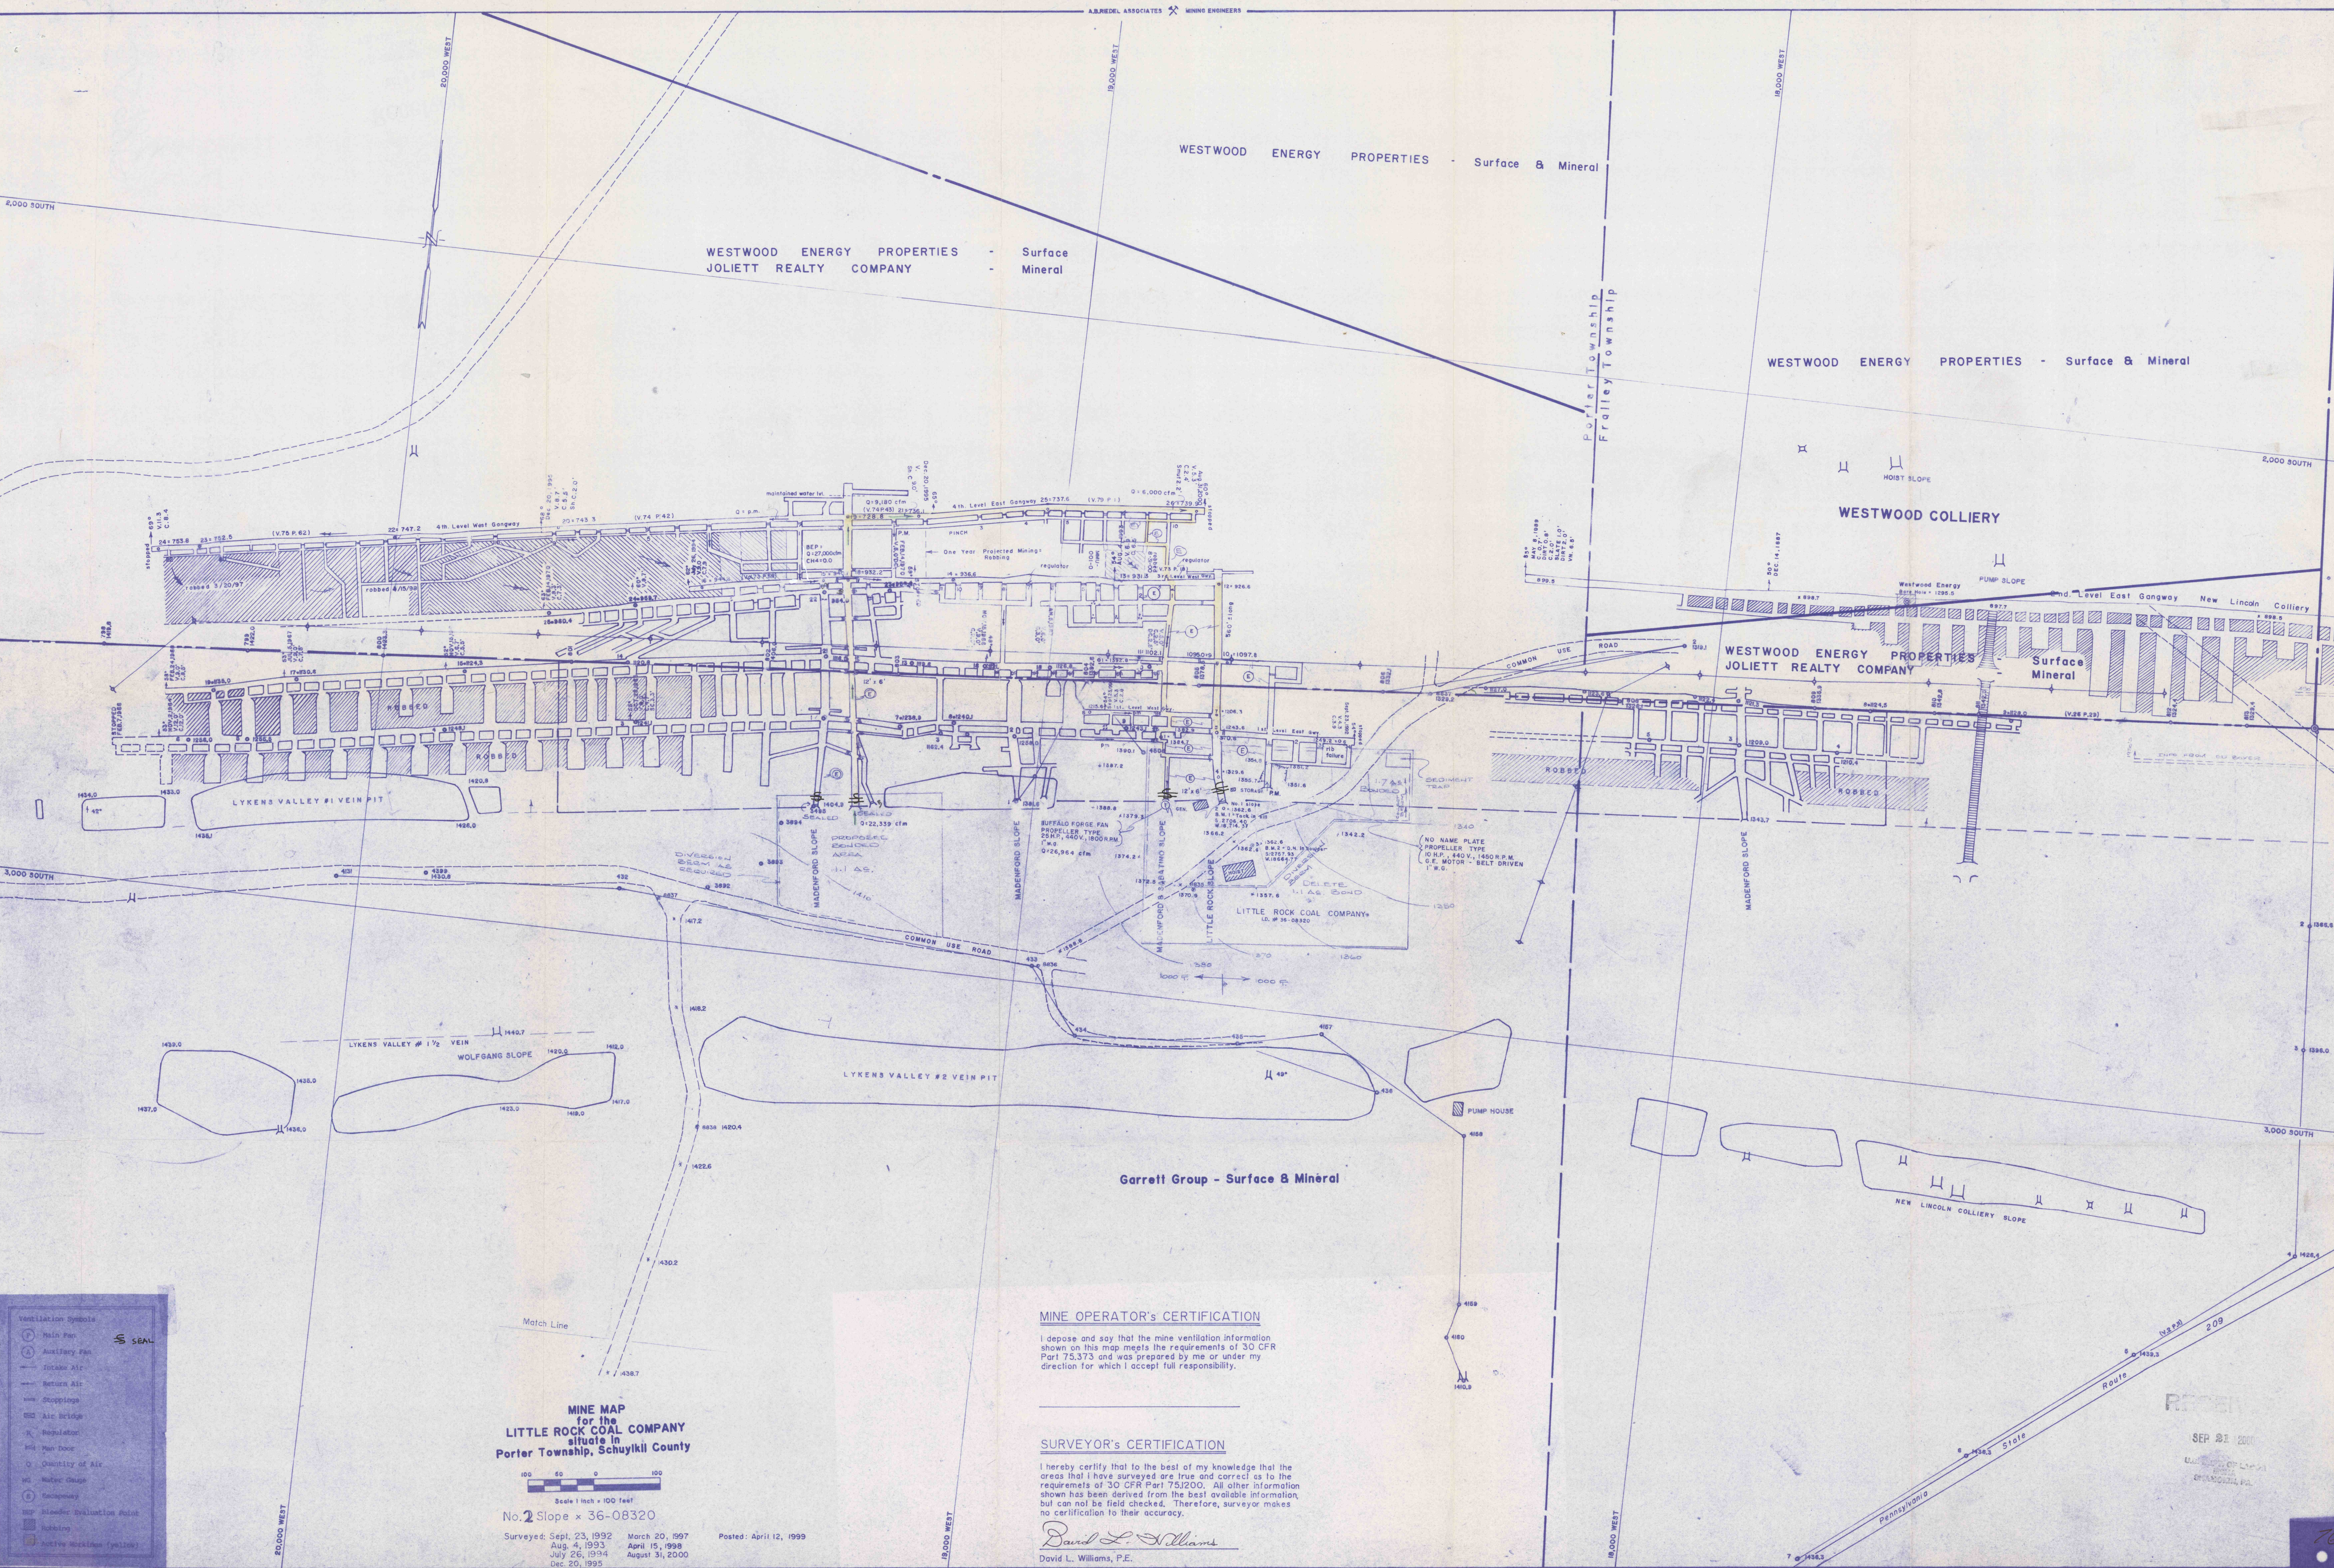

Ventilation Symbols

- Main Fan
- Auxiliary Fan
- Intake Air
- Return Air
- Stoppings
- Air Bridge
- Regulator
- Full Pan Door
- Quantity of Air
- Water Gauge
- Robbing
- Active Workings (yellow)

SEAL

MINE MAP
for the
LITTLE ROCK COAL COMPANY
situated in
Porter Township, Schuylkill County

Scale 1 inch = 100 feet
No. 2 Slope x 36-08320

Surveyed: Sept. 23, 1992
Aug. 4, 1993
July 26, 1994
Dec. 20, 1995

March 20, 1997
April 15, 1998
August 31, 2000

Posted: April 12, 1999

MINE OPERATOR'S CERTIFICATION

I depose and say that the mine ventilation information shown on this map meets the requirements of 30 CFR Part 75.373 and was prepared by me or under my direction for which I accept full responsibility.

SURVEYOR'S CERTIFICATION

I hereby certify that to the best of my knowledge that the areas that I have surveyed are true and correct as to the requirements of 30 CFR Part 75.200. All other information shown has been derived from the best available information, but can not be field checked. Therefore, surveyor makes no certification to their accuracy.

David L. Williams
David L. Williams, P.E.

SEP 22 2000
