


filled the west between 3th & 4th streets and level
stopped in shaft on the 2nd level but did not follow the
Auriferous
5-21-01
M. L. Williams
5/21/01 23041

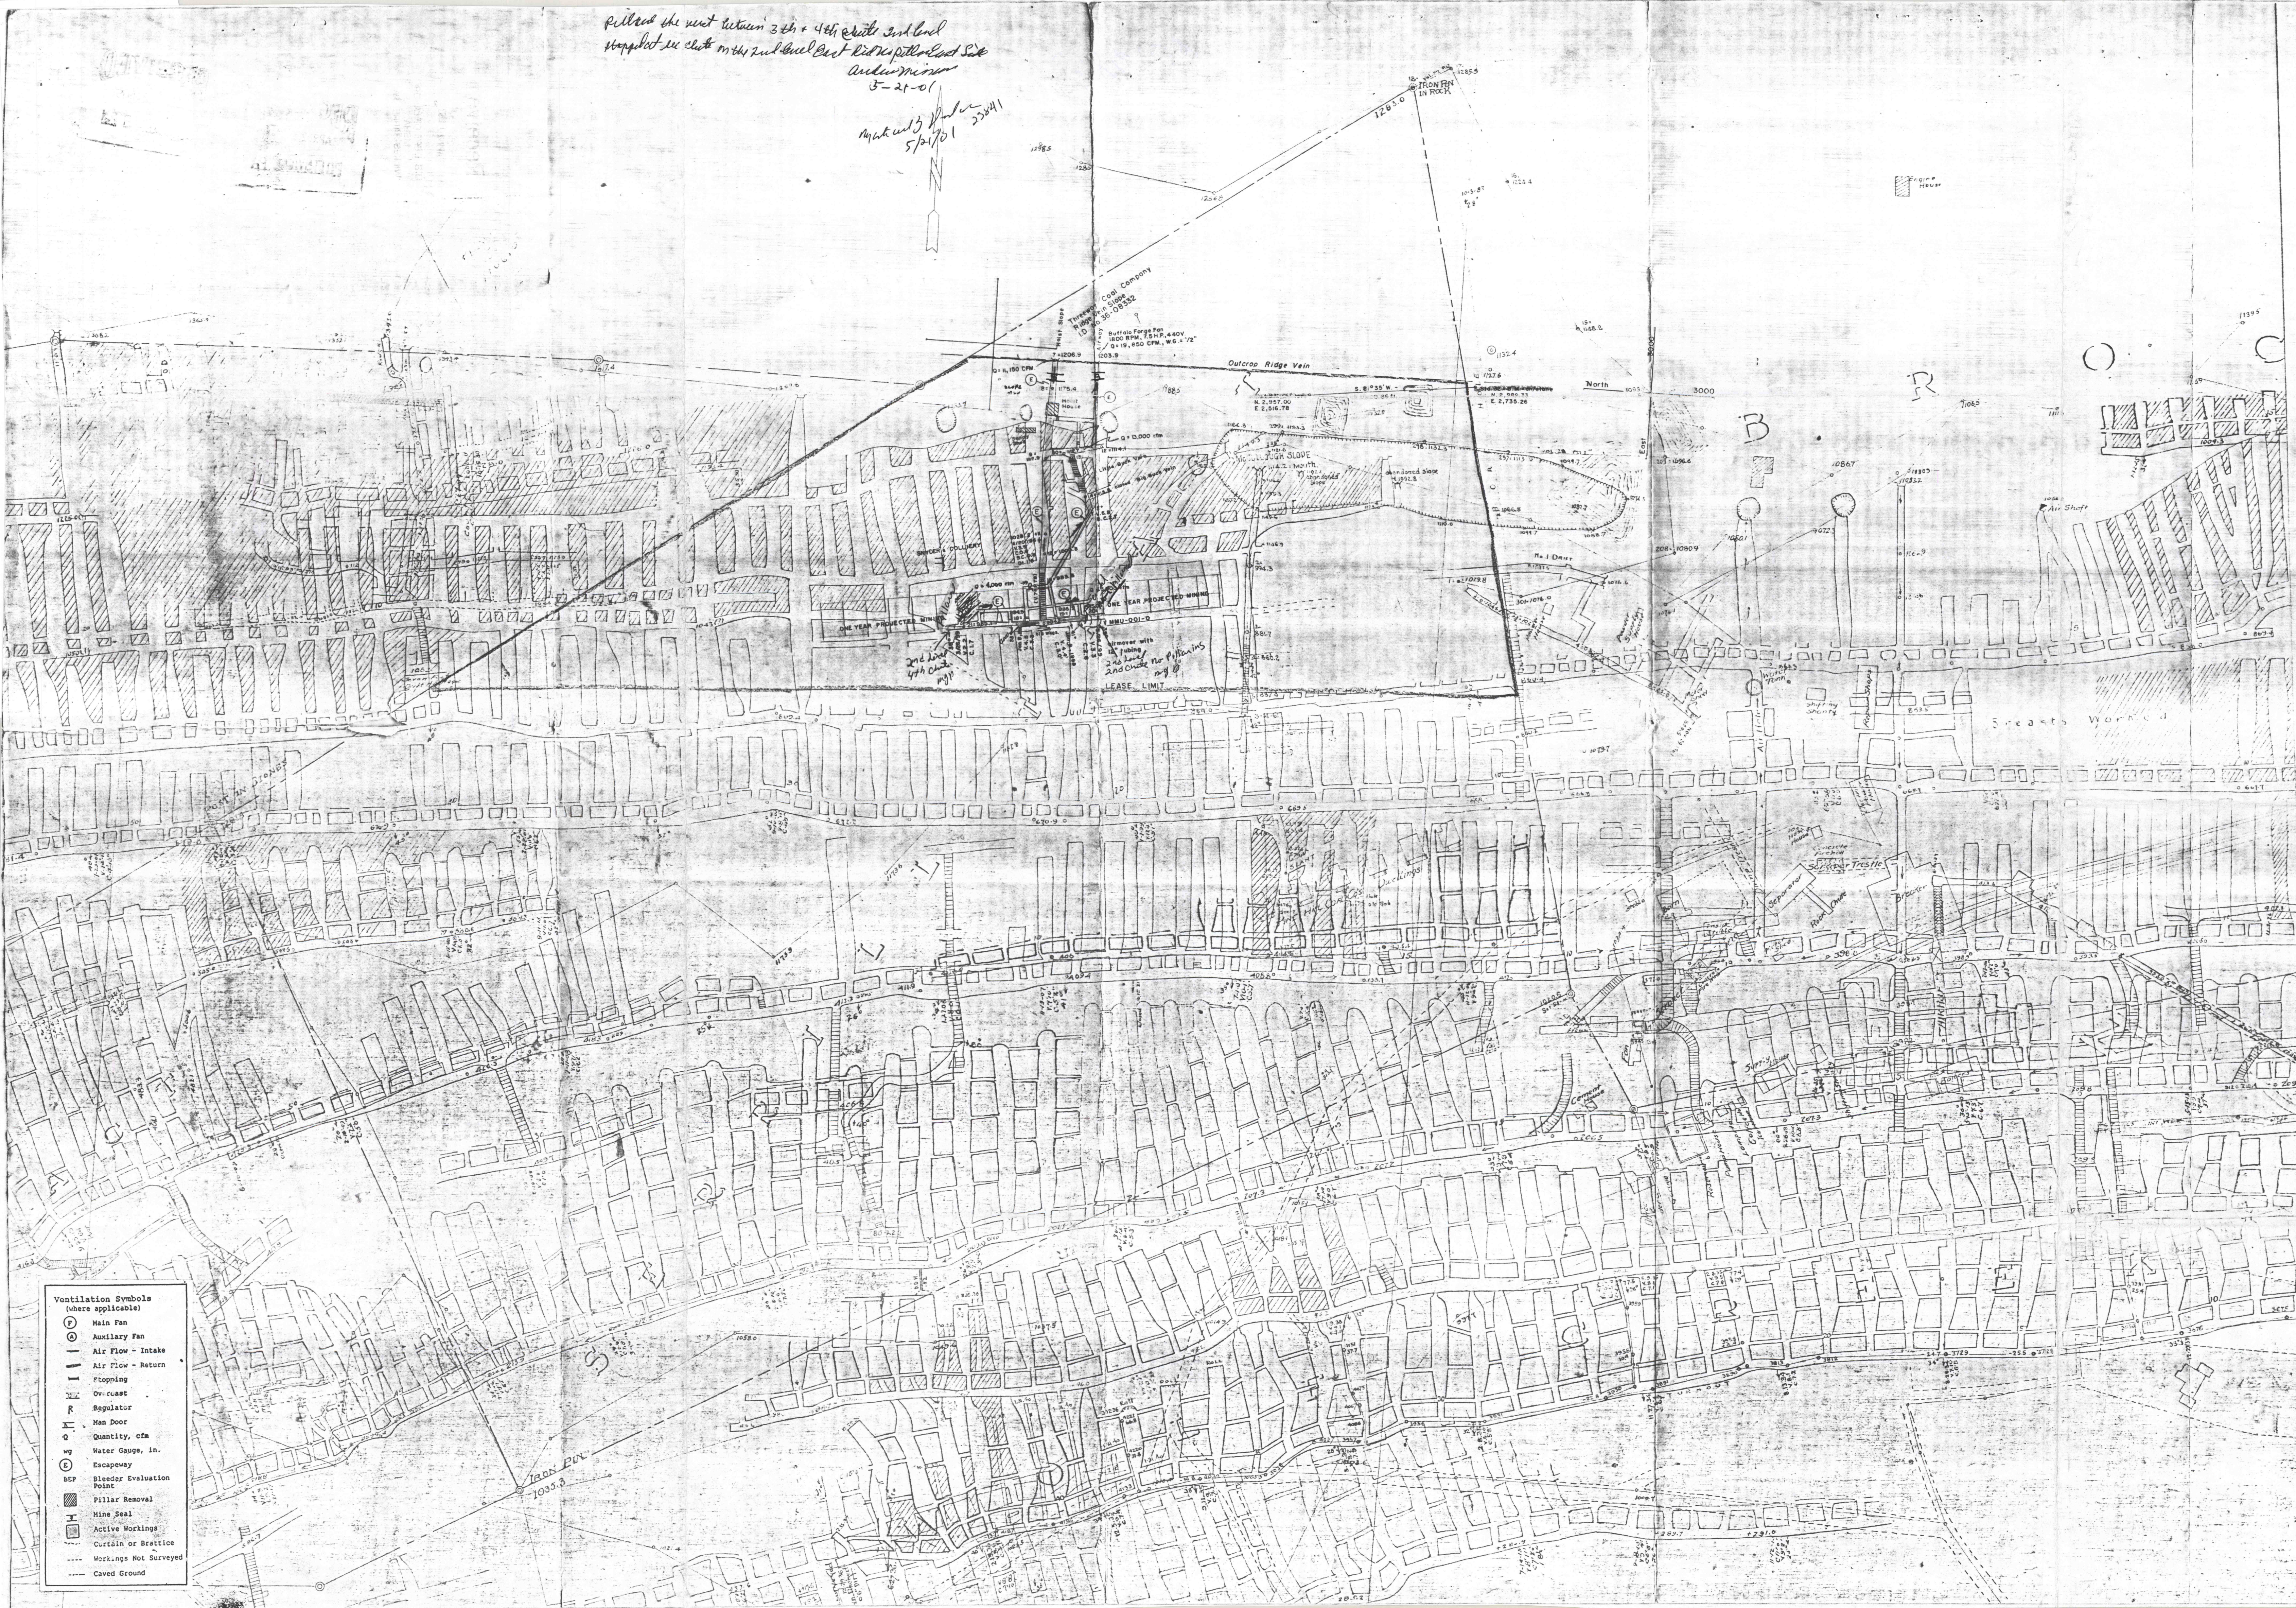

- Ventilation Symbols
(where applicable)
- Main Fan
 - Auxiliary Fan
 - Air Flow - Intake
 - Air Flow - Return
 - Stoppage
 - Overcast
 - Regulator
 - Man Door
 - Quantity, cfm
 - Water Gauge, in.
 - Escapeway
 - Bleeder Evaluation Point
 - Pillar Removal
 - Mine Seal
 - Active Workings
 - Curtain or Brattice
 - Workings Not Surveyed
 - Caved Ground

Surveyor's Certification

I hereby certify that to the best of my knowledge
that the areas that I have surveyed are true and
correct as to the requirements of 30 CFR Part
75.200. All other information shown has been
derived from the best available information but
can not be field checked. Therefore, surveyor
makes no certification to their accuracy.

David L. Williams
David L. Williams, P.E.

Mine Operator's Certification

I depose and say that the mine ventilation
information shown on this plan meets the
requirements of 30 CFR Part 75.372 and
was prepared by me or under my direction for
which I accept full responsibility.

James Williams
Mine Foreman

MINE MAP
of
THREWAY COAL COMPANY
situate in
Schuylkill County, Pennsylvania
I.D. #36-08332

100 50 0 100
Scale: 1" = 100'
Survey: October 4, 1995
November 20, 1996
January 8, 1998
March 26, 1999

FINAL ABANDONMENT MAP