


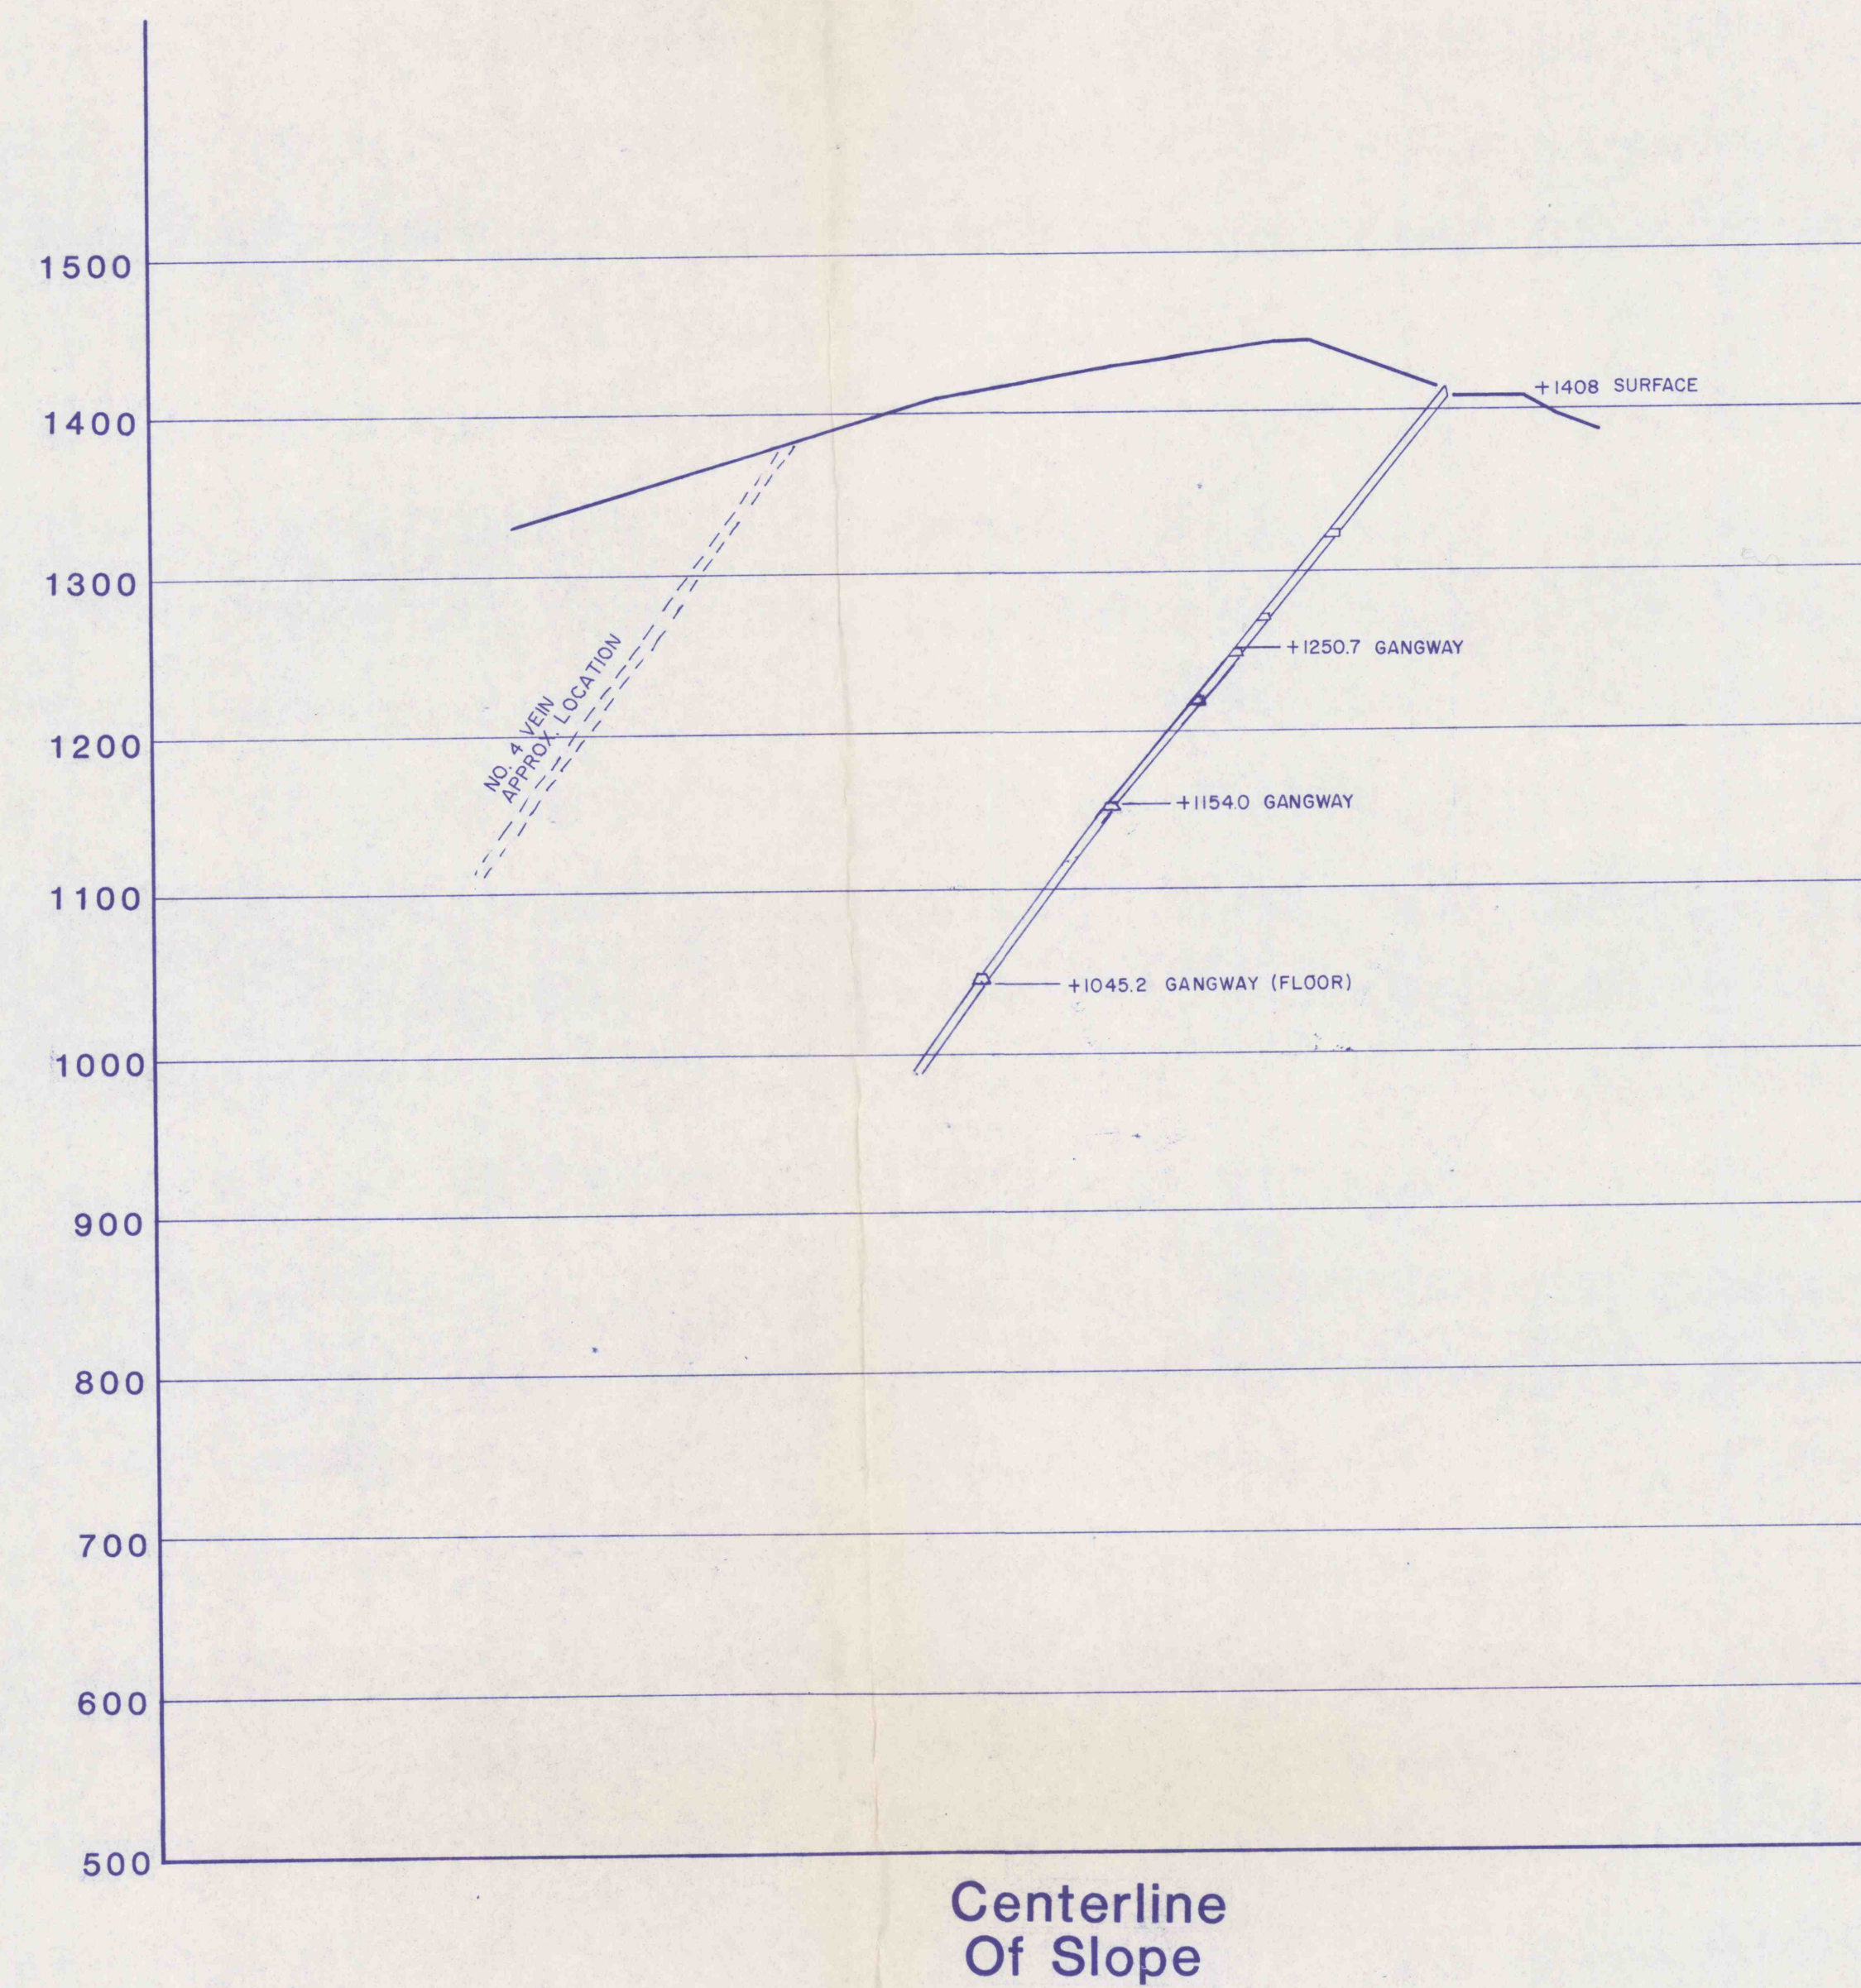


No. 2 Vein - South Dip

MINE SURVEY FOR
NORTH MOUNTAIN COAL CO.
 COAL TOWNSHIP, NORTHUMBERLAND COUNTY
 PENNSYLVANIA

SCALE: VERTICAL - 1 INCH = 100 FEET
 HORIZONTAL - 1 INCH = 100 FEET

M.S.H.A. I.D. #36- 07681

OCTOBER 16, 1985
 REVISED: NOV. 6, 1987
 MAY 15, 1990
 MAY 22, 1991
 OCT. 23, 1991

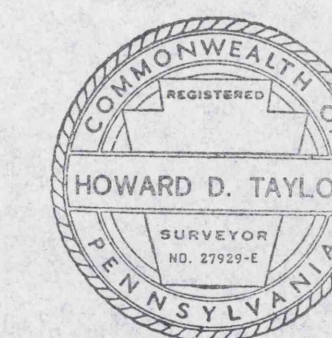

Howard D. Taylor

Taylor-Boberk Associates
 PROFESSIONAL LAND SURVEYORS
 RD#1 BOX 659
 SHAMOKIN, PA. 17872

Cross-Sections
 SHEET NO. 3