



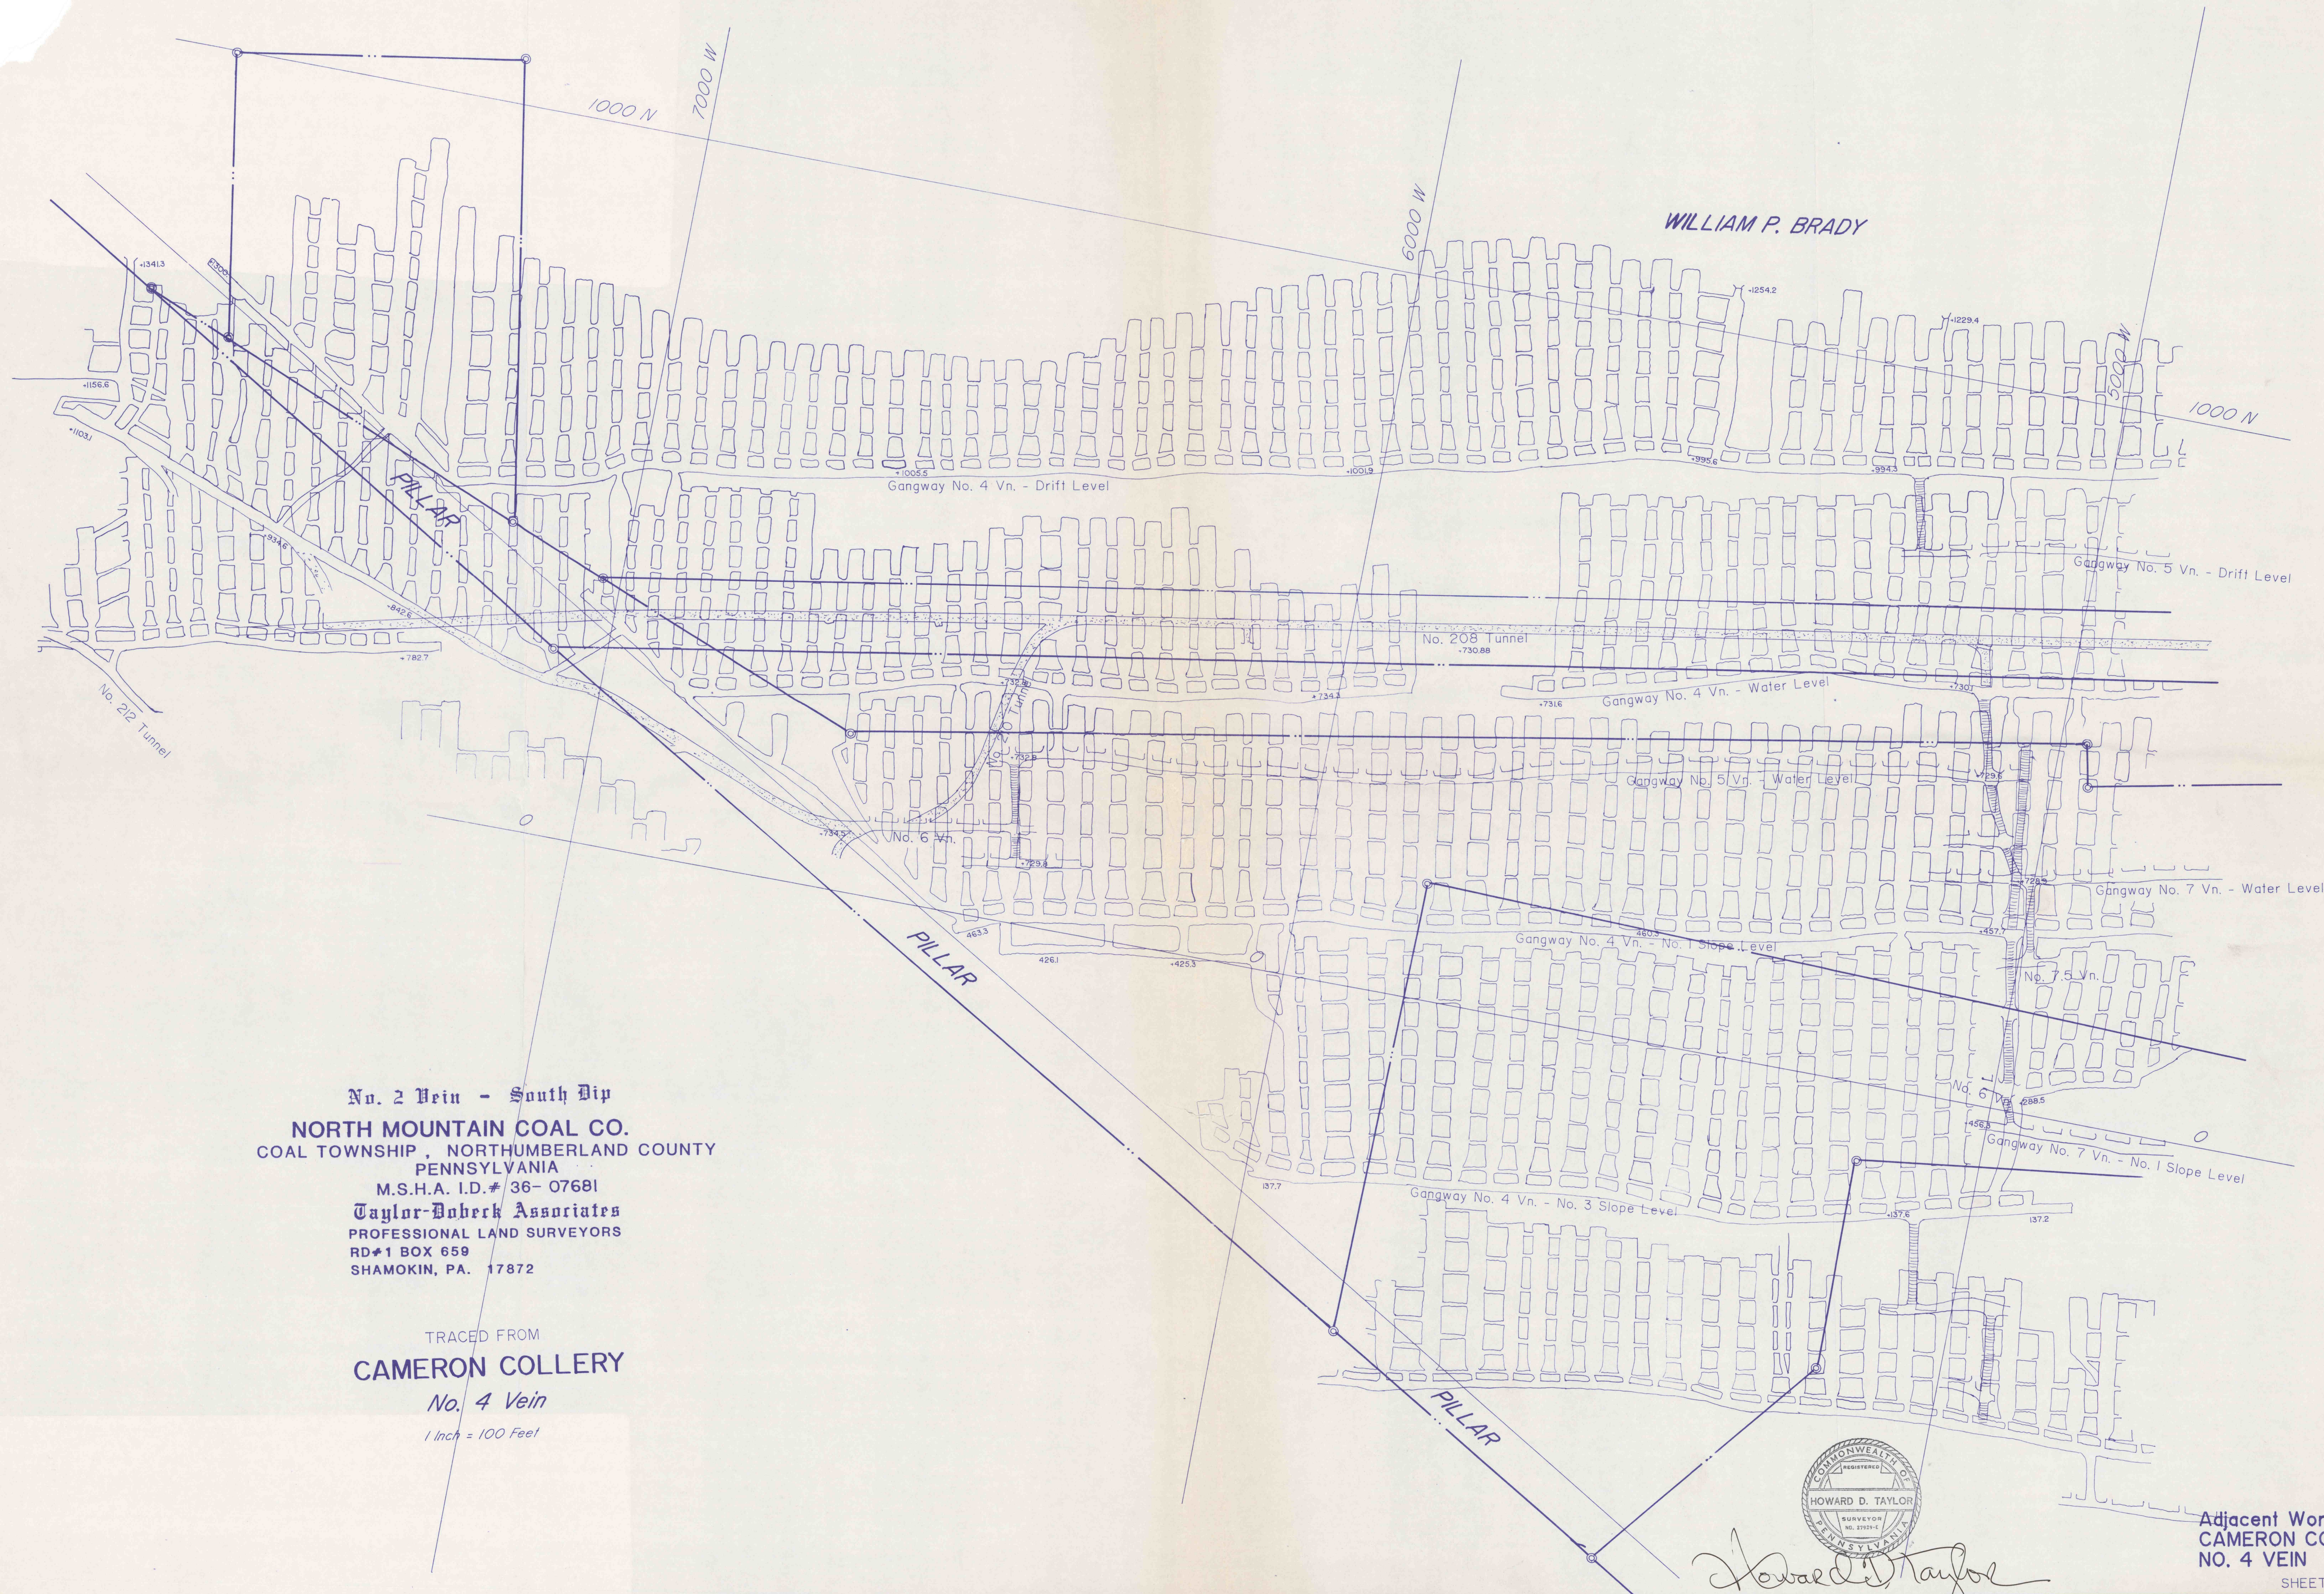

No. 2 Vein - South Dip
NORTH MOUNTAIN COAL CO.
COAL TOWNSHIP, NORTHUMBERLAND COUNTY
PENNSYLVANIA
M.S.H.A. I.D.# 36- 07681
Taylor-Doberck Associates
PROFESSIONAL LAND SURVEYORS
RD#1 BOX 659
SHAMOKIN, PA. 17872

TRACED FROM
CAMERON COLLIERY
No. 4 Vein
1 Inch = 100 Feet

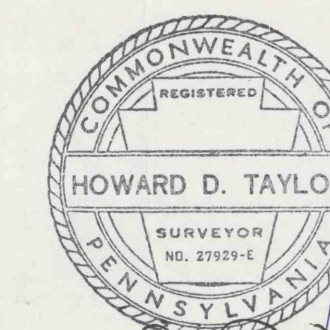

Howard D. Taylor

Adjacent Workings
CAMERON COLLIERY
NO. 4 VEIN