

LEGEND

- ESCAPEWAY (E)
- ROBBED
- SURVEY STATION (TAYLOR-DOBECK ASSOC.) (SUSQUEHANNA COAL CO.)
- ELEVATION +1382 (SUSQUEHANNA COAL CO. DATUM)
- STOPPING
- INTAKE AIR (I)
- RETURN AIR (R)
- OLD ABANDONED WORKINGS
- NEW WORKINGS OF NORTH MOUNTAIN COAL CO.
- PROPERTY LINE
- OUTCROP LINE

Horizontal Control Data Surface

Station No. 11 Drill Hole In Rock
N = 1,090.25 (N)
E = -8,420.64 (W)

Station No. 13 Drill Hole In Rock
N = 1,156.43 (N)
E = -8,207.70 (W)


Station No. 71 Chisel Mark On Angle Iron On Tipple
N = 951.14 (N)
E = -8,893.80 (W)

Station No. 76 Drill Hole In Rock
N = 1,063.27 (N)
E = -8,642.35 (W)


Station No. 77 Spike In Road
N = 873.53 (N)
E = -8,772.80 (W)

Station No. 78 Spike On Southerly Side Of Road
N = 801.89 (N)
E = -8,668.98 (W)

Station No. 79 Spike On Northerly Side Of Road
N = 810.58 (N)
E = -8,417.18 (W)

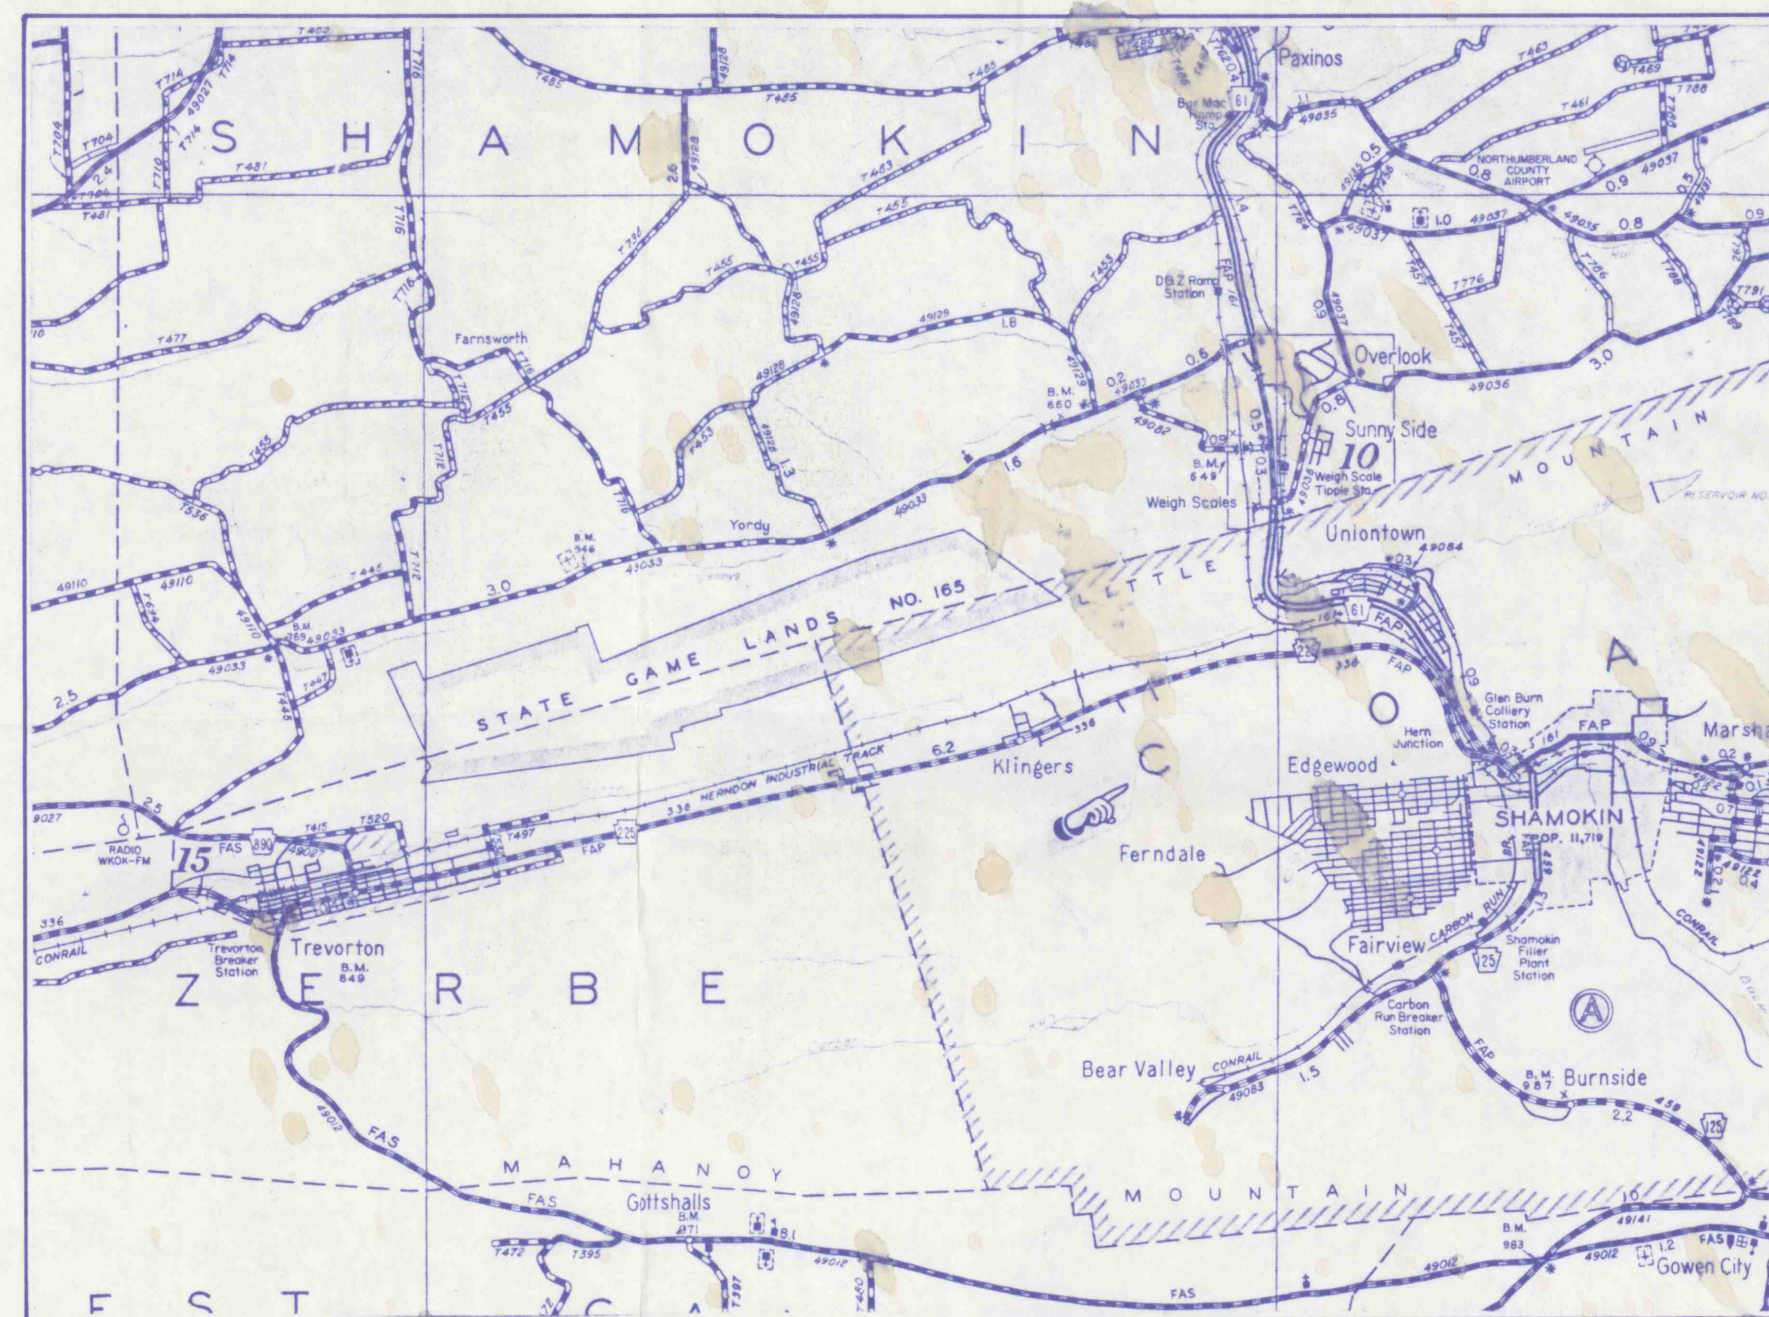

Location Map
1 Inch = 1 Mile

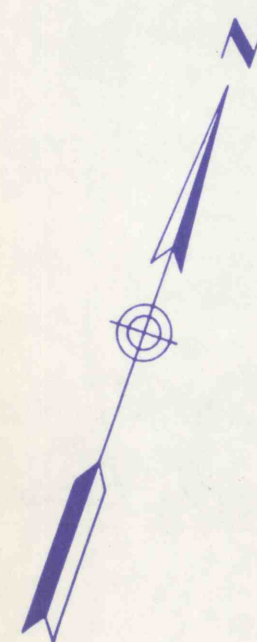

Pennsylvania State Highway Traffic Route No. 225
To Trevorton To Shamokin

Pennsylvania Power & Light Co. Right-Of-Way

PITREAL CORPORATION
DEED BOOK 433, PAGE 401
Leased To
HELKER CONSTRUCTION CO.

HELKER CONSTRUCTION CO.
DEED BOOK 459, PAGE 474

No. 2 Vein Outcrop

HOIST BUILDING

CHISEL MARK ON TIPPLE

Drill Hole In Stone

Atlantic Pipeline

New Access Road (See Sheet No. 4)

VPA QUARRY

8,000 W

1,000 N

Haul Road

Abandoned Access Road
(See Sheet No. 4 For New Access Road)

No. 2 Vein - South Dip



MINE SURVEY FOR
NORTH MOUNTAIN COAL CO.
COAL TOWNSHIP, NORTHUMBERLAND COUNTY
PENNSYLVANIA

SCALE: 1 INCH = 100 FEET, OCTOBER 16, 1985

REVISED: NOV. 6, 1987 MAY 2, 1988

M.S.H.A. I.D.# 36- 07681

Taylor-Dobeck Associates
PROFESSIONAL LAND SURVEYORS
RD#1 BOX 659
SHAMOKIN, PA. 17872

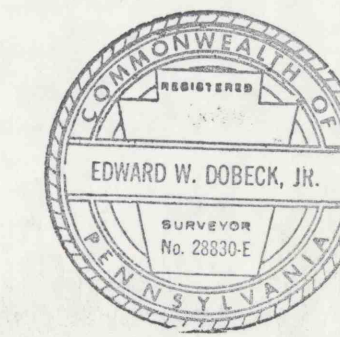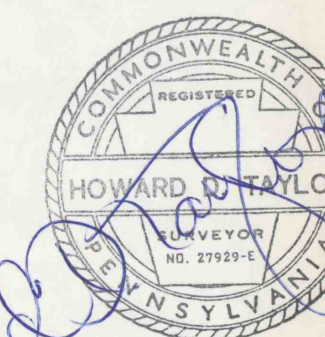

Surface
SHEET NO. 1 OF 4