


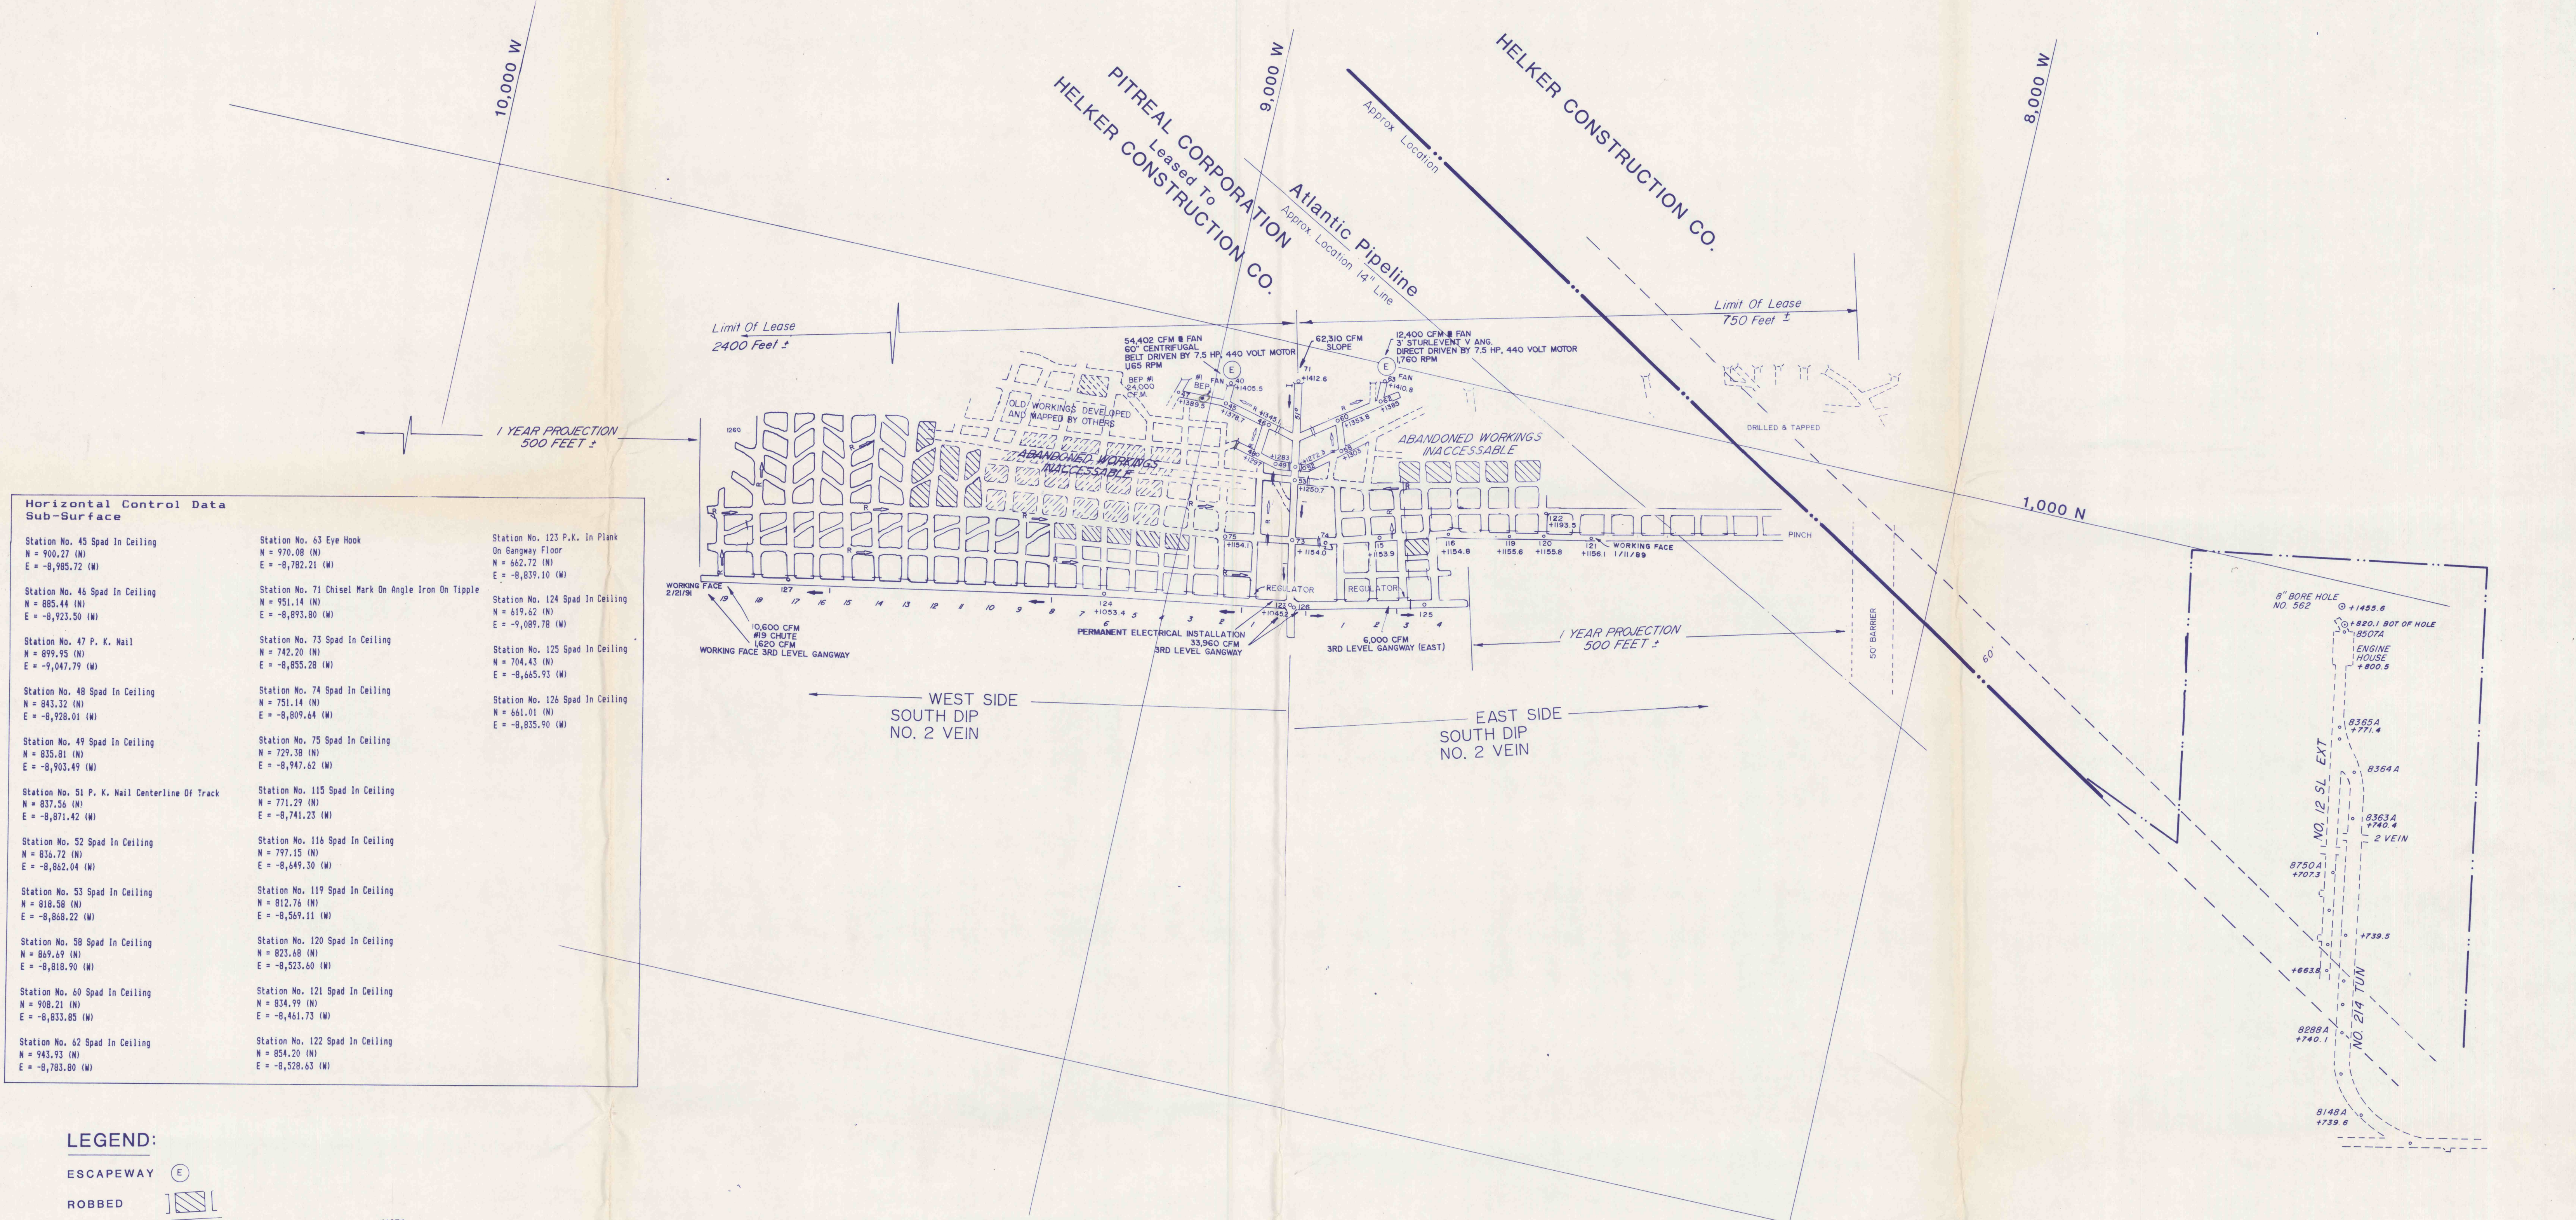


Horizontal Control Data Sub-Surface		
Station No. 45 Spad In Ceiling N = 900.27 (N) E = -8,985.72 (W)	Station No. 63 Eye Hook N = 970.08 (N) E = -8,782.21 (W)	Station No. 123 P.K. In Plank On Gangway Floor N = 652.72 (N) E = -8,839.10 (W)
Station No. 46 Spad In Ceiling N = 885.44 (N) E = -8,923.50 (W)	Station No. 71 Chisel Mark On Angle Iron On Tipple N = 951.14 (N) E = -8,893.80 (W)	Station No. 124 Spad In Ceiling N = 619.62 (N) E = -9,089.78 (W)
Station No. 47 P. K. Nail N = 899.95 (N) E = -9,047.79 (W)	Station No. 73 Spad In Ceiling N = 742.20 (N) E = -8,855.28 (W)	Station No. 125 Spad In Ceiling N = 704.43 (N) E = -8,665.93 (W)
Station No. 48 Spad In Ceiling N = 843.32 (N) E = -9,928.01 (W)	Station No. 74 Spad In Ceiling N = 751.14 (N) E = -8,809.64 (W)	Station No. 126 Spad In Ceiling N = 661.01 (N) E = -8,835.90 (W)
Station No. 49 Spad In Ceiling N = 835.81 (N) E = -9,903.49 (W)	Station No. 75 Spad In Ceiling N = 729.38 (N) E = -8,947.62 (W)	
Station No. 51 P. K. Nail Centerline Of Track N = 837.36 (N) E = -8,871.42 (W)	Station No. 115 Spad In Ceiling N = 771.29 (N) E = -8,741.23 (W)	
Station No. 52 Spad In Ceiling N = 836.72 (N) E = -8,862.04 (W)	Station No. 116 Spad In Ceiling N = 797.15 (N) E = -8,649.30 (W)	
Station No. 53 Spad In Ceiling N = 818.58 (N) E = -8,868.22 (W)	Station No. 119 Spad In Ceiling N = 812.76 (N) E = -8,569.11 (W)	
Station No. 58 Spad In Ceiling N = 869.49 (N) E = -8,818.90 (W)	Station No. 120 Spad In Ceiling N = 823.68 (N) E = -8,523.60 (W)	
Station No. 60 Spad In Ceiling N = 908.21 (N) E = -8,833.85 (W)	Station No. 121 Spad In Ceiling N = 834.99 (N) E = -8,461.73 (W)	
Station No. 62 Spad In Ceiling N = 943.93 (N) E = -8,783.80 (W)	Station No. 122 Spad In Ceiling N = 854.20 (N) E = -8,528.63 (W)	

- LEGEND:**
- ESCAPEWAY (E)
 - ROBBED (R)
 - SURVEY STATION (O₃ (TAYLOR-DOBECK ASSOC.) 4/67A (SUSQUEHANNA COAL CO.))
 - ELEVATION +1382 (SUSQUEHANNA COAL CO. DATUM)
 - STOPPING (PERMANENT, TEMPORARY)
 - INTAKE AIR (I)
 - RETURN AIR (R)
 - OLD ABANDONED WORKINGS (---)
 - NEW WORKINGS OF NORTH MOUNTAIN COAL CO. (==)
 - PROPERTY LINE (---)
 - OUTCROP LINE (---)
 - PITCH OF VEIN (DEGREES) 50°
 - BEP BLEEDER EVALUATION POINT

NOTES:

1. LOCATIONS AND EXTENT OF OLD ABANDONED WORKINGS UNKNOWN

No. 2 Vein - South Dip
WEST SIDE - SOUTH DIP - NO. 2 VEIN
MINE SURVEY FOR
NORTH MOUNTAIN COAL CO.
COAL TOWNSHIP, NORTHUMBERLAND COUNTY
PENNSYLVANIA
SCALE: 1 INCH = 100 FEET, OCTOBER 16, 1985
REVISED: NOV. 6, 1987
M.S.H.A. I.D.# 36- 07681

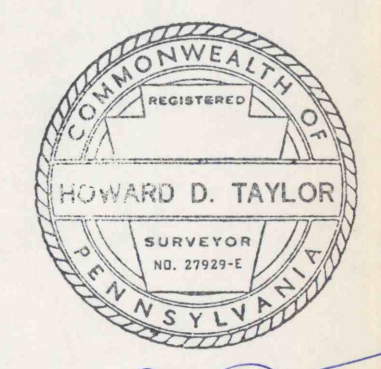

Taylor-Doberk Associates
PROFESSIONAL LAND SURVEYORS
RD#1 BOX 659
SHAMOKIN, PA. 17872