



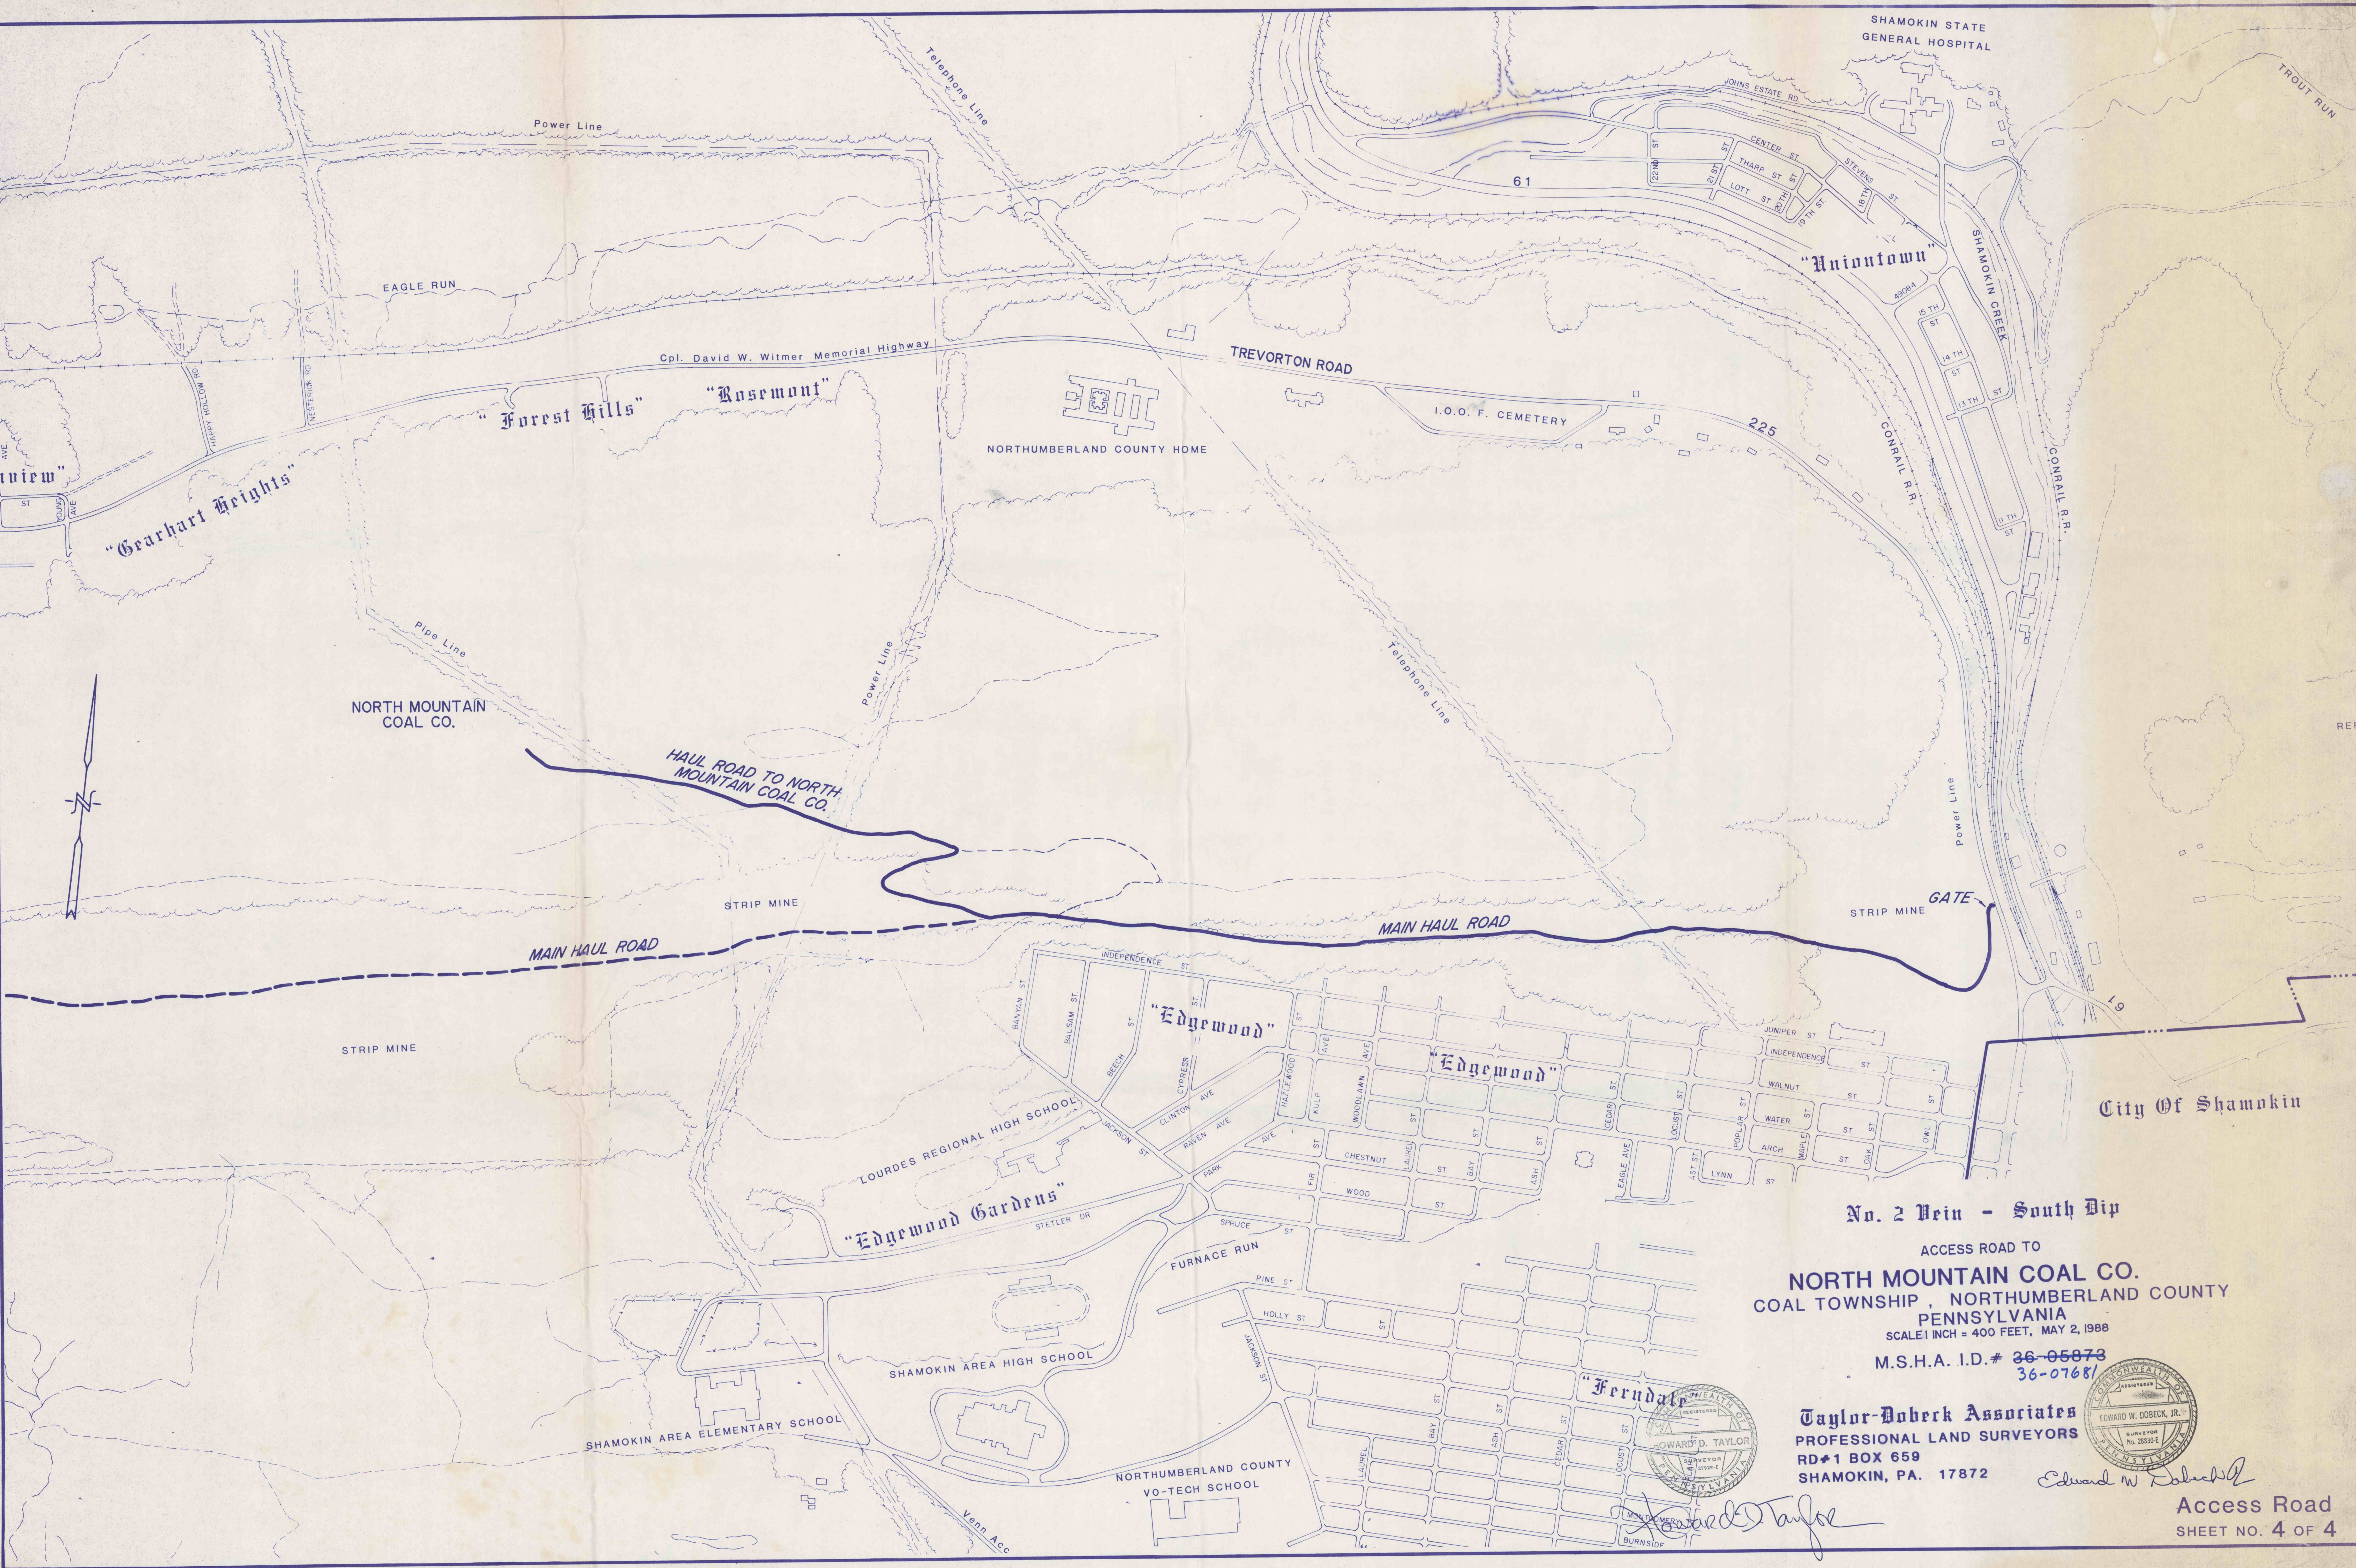

No. 2 Vein - South Dip
ACCESS ROAD TO
NORTH MOUNTAIN COAL CO.
COAL TOWNSHIP, NORTHUMBERLAND COUNTY
PENNSYLVANIA
SCALE 1 INCH = 400 FEET, MAY 2, 1988
M.S.H.A. I.D.# 36-05873
36-07681

Taylor-Doberk Associates
PROFESSIONAL LAND SURVEYORS
RD#1 BOX 659
SHAMOKIN, PA. 17872

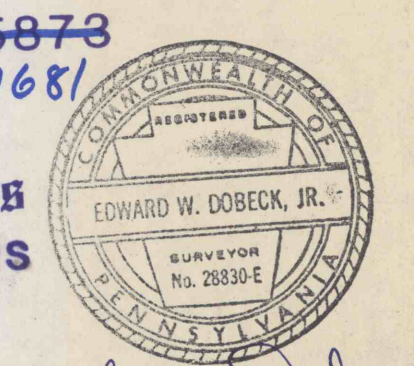

Edward W. Doberk, Jr.