


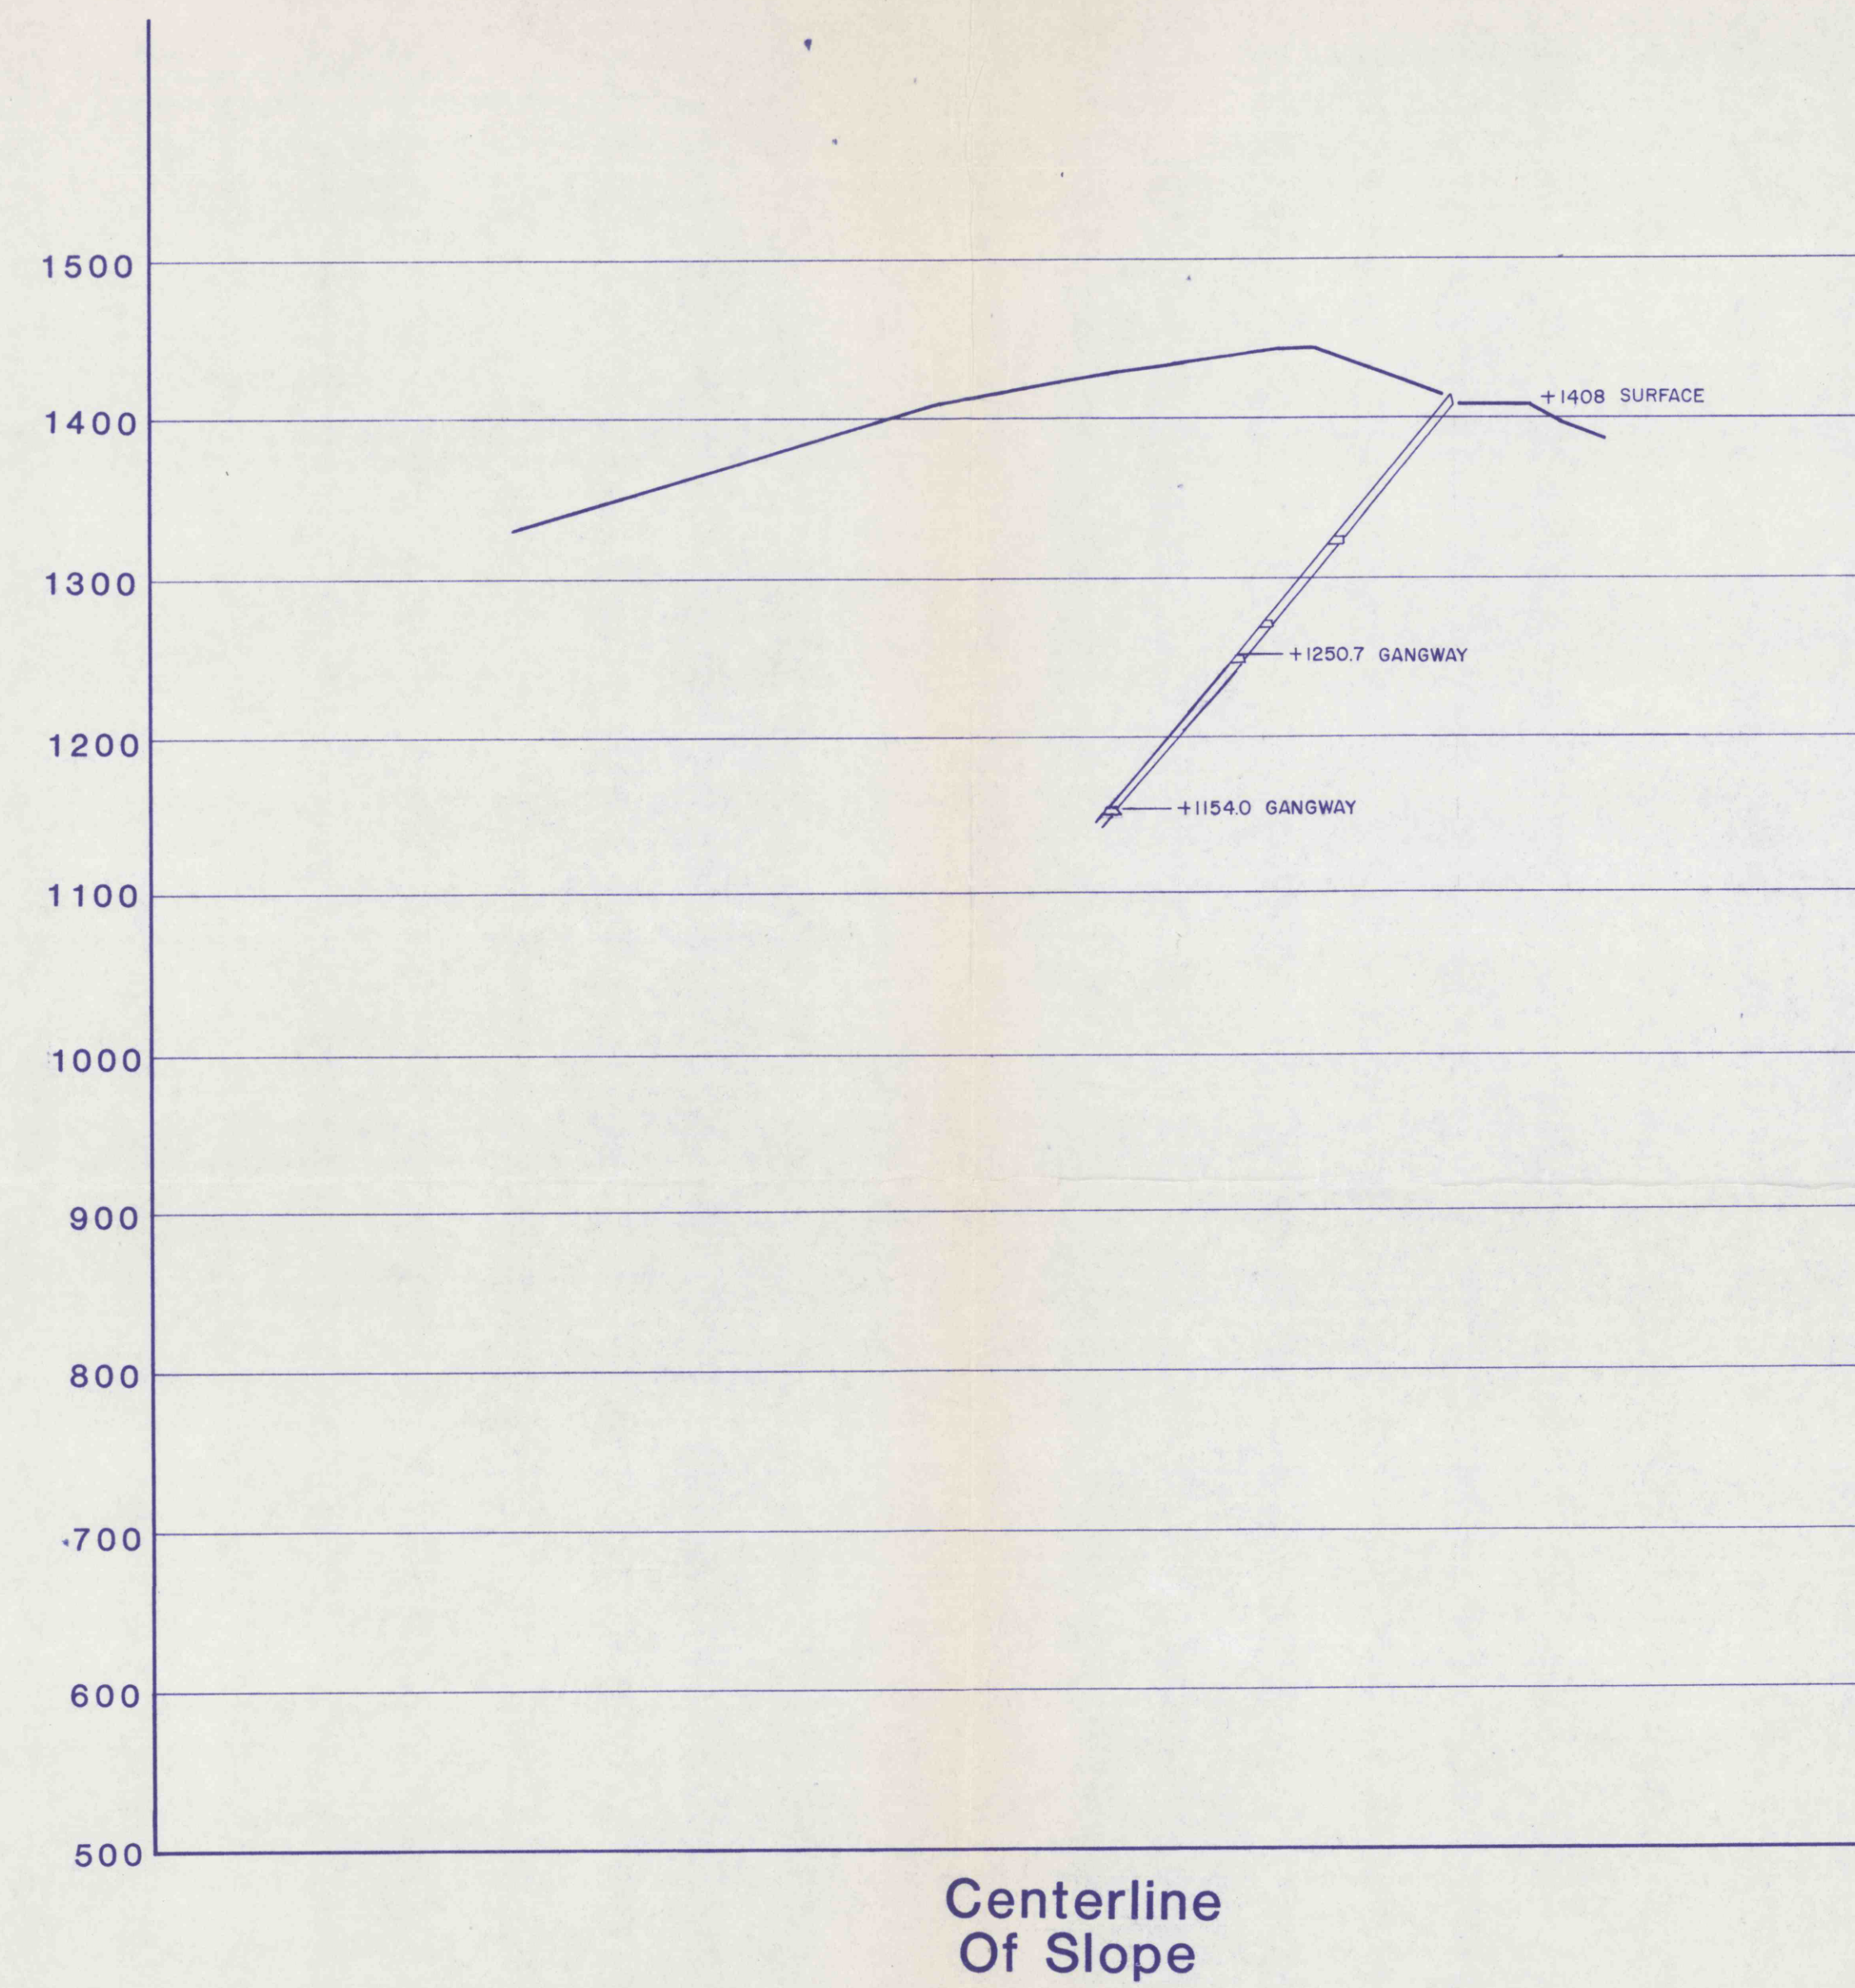

No. 2 Vein - South Dip

MINE SURVEY FOR
NORTH MOUNTAIN COAL
 COAL TOWNSHIP, NORTHUMBERLAND COUNTY
 PENNSYLVANIA

SCALE: VERTICAL - 1 INCH = 100 FEET
 HORIZONTAL - 1 INCH = 100 FEET

OCTOBER 16, 1985
 REVISED: NOV. 6, 1987

M.S.H.A. I.D.#36-07681

Taylor-Doberk Associates
 PROFESSIONAL LAND SURVEYORS
 RD#1 BOX 659
 SHAMOKIN, PA. 17872