

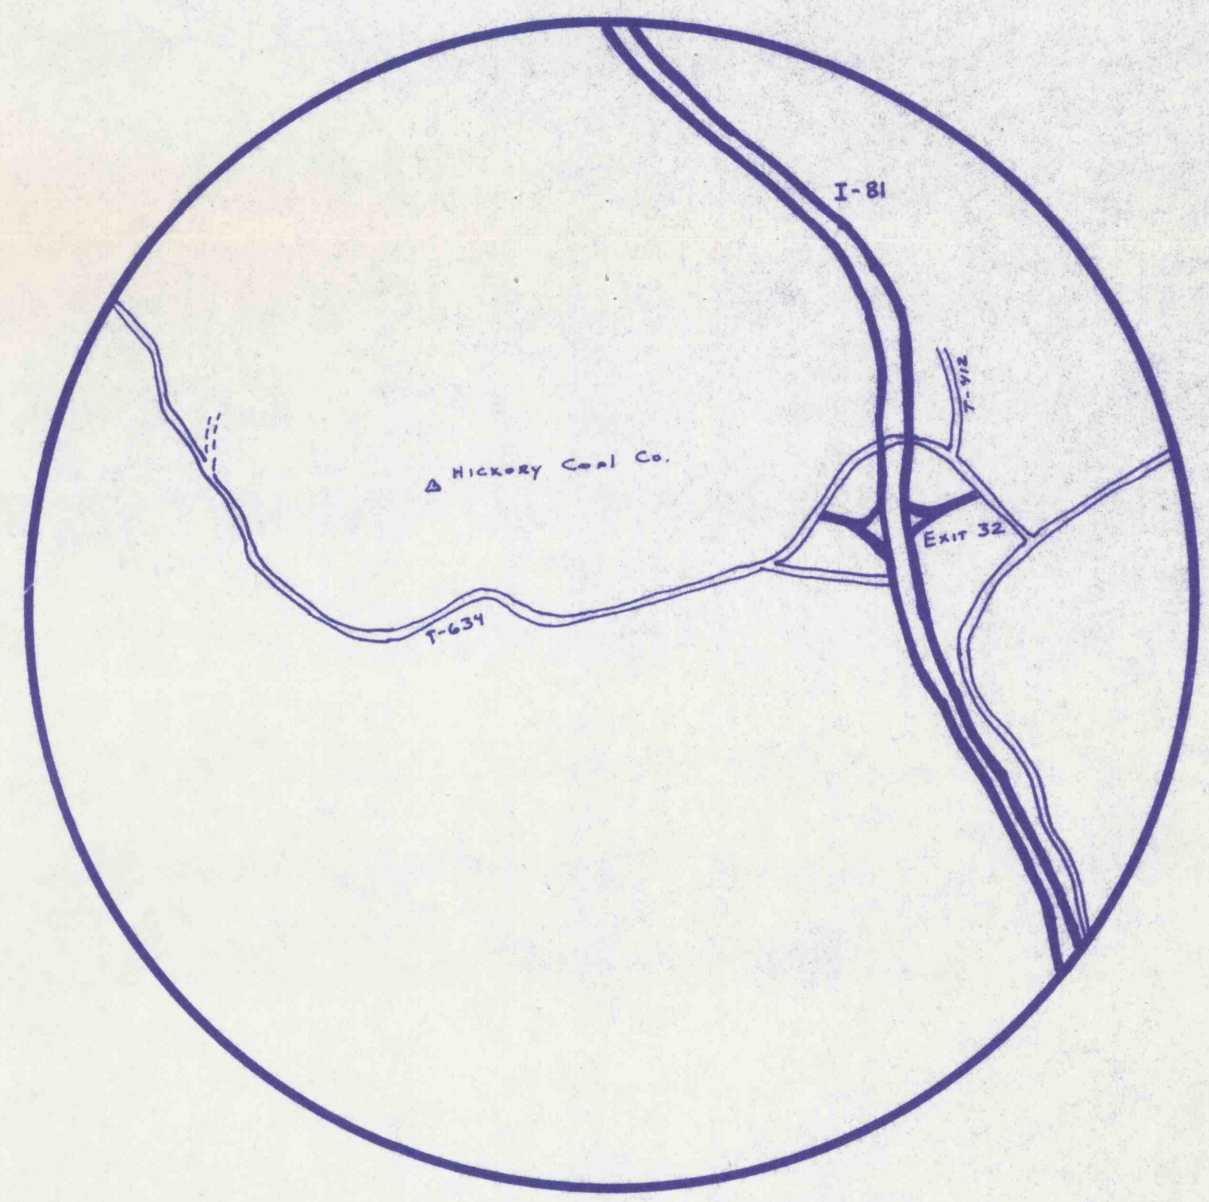


TREMONT TOWNSHIP
SCHUYLKILL COUNTY

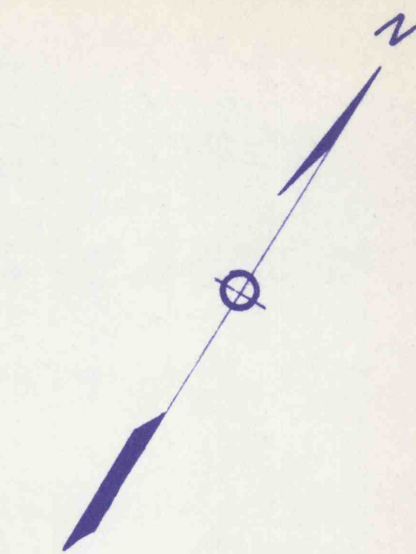

Fan Data: Buffalo Type B, 48" Diameter
Vaneaxial 72P-9733
Ventilation: The mine is ventilated on a blowing system. Intake air from the fan is directed to the faces thru 12" ventilation tubing. The air then is exhausted from the faces via pressure differential.

LOCATION MAP

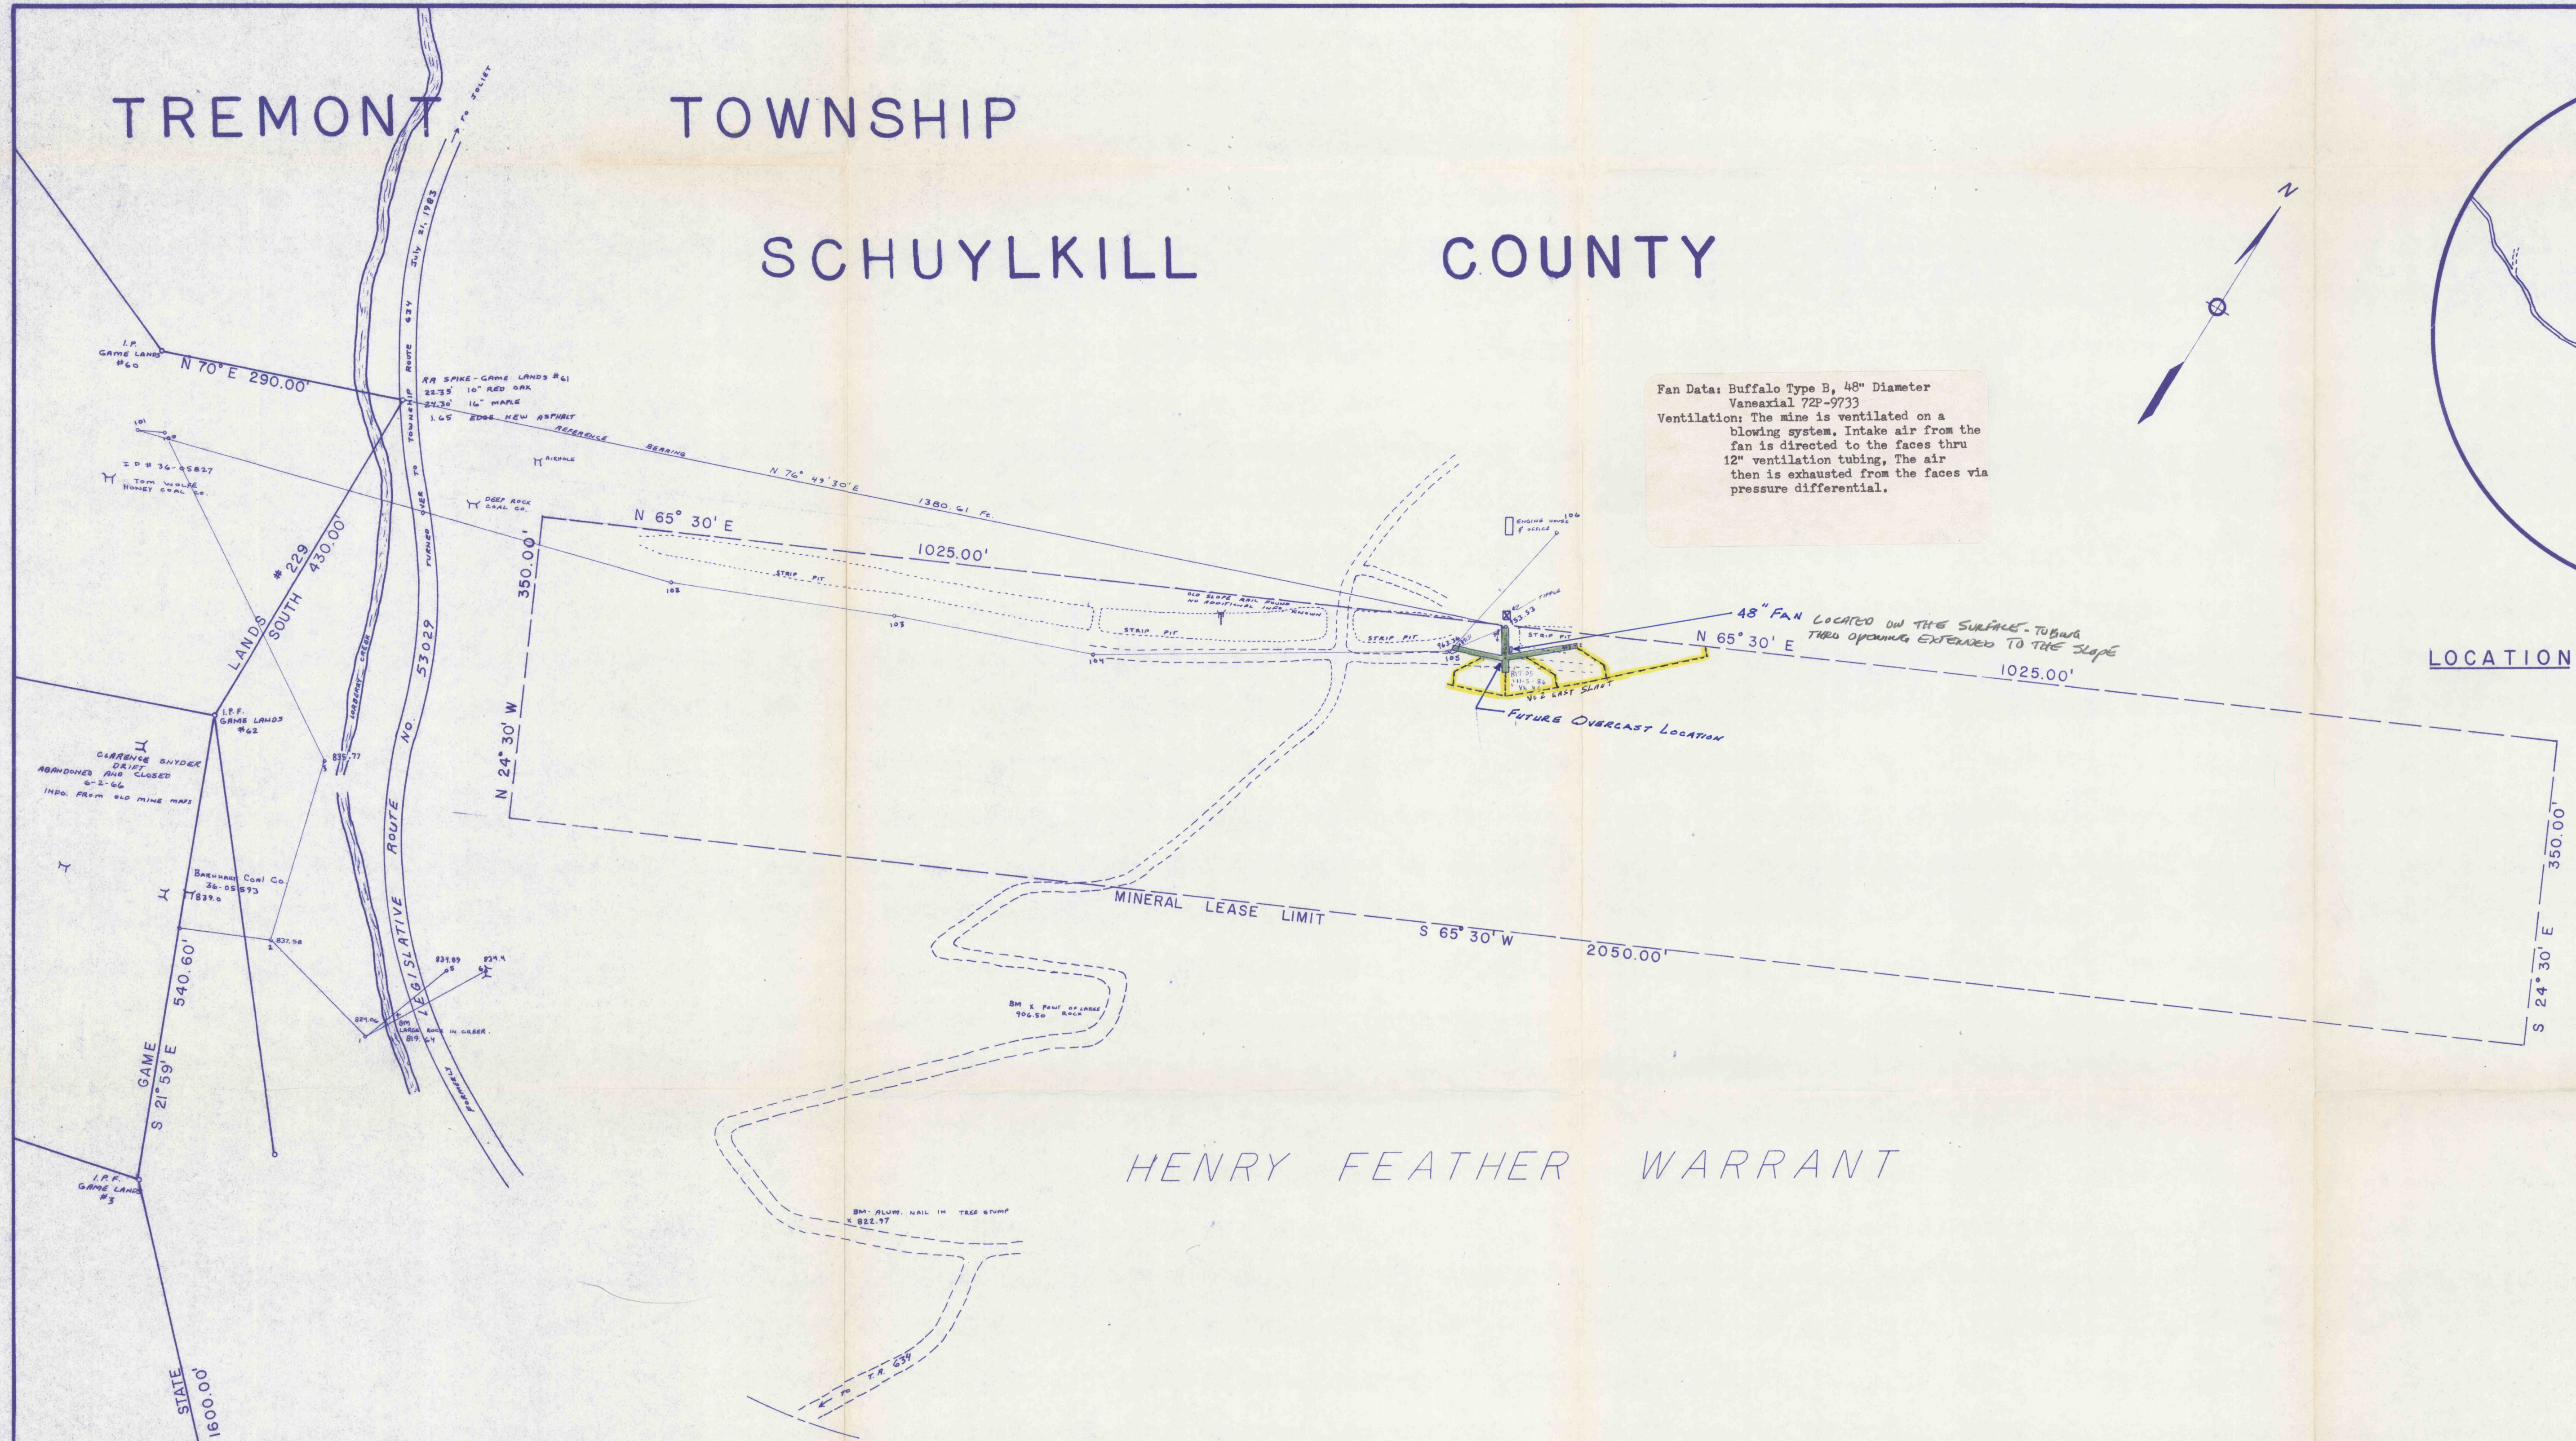


HENRY FEATHER WARRANT


LEGEND

INTAKE AIR → RETURN AIR →
ESCAPEWAY → ACTIVE WKGS. →
SLOPE-DRIFT □ PROPOSED - - - - -
TEMP. STOP. I PERM. STOP II
VENT. TUBE - - - - -

NOTES:
1) ELEVATION REFERENCE
BM AT I-81 INTERCHANGE 32
ELEV. 714.95
2) MINE LOCATION TIED TO STATE GAME
LANDS #229 PROPERTY LINE.

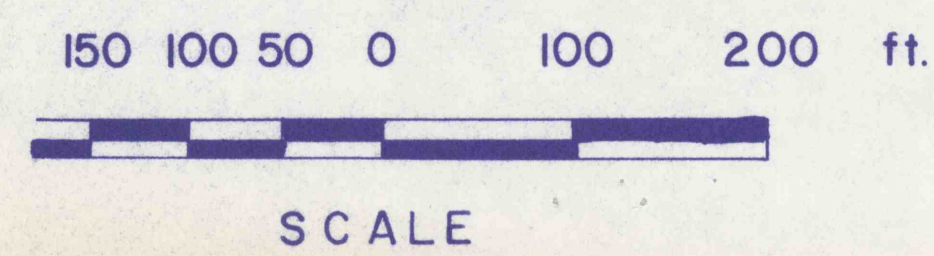

I, the undersigned, hereby certify that this map is correct and shows all the information, to the best of my knowledge and belief, required by the mining laws of this state, and covers the period ending: NOVEMBER 5, 1986
Signed Steven E. Dziuban

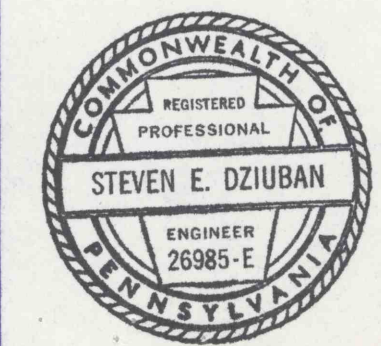	DZIUBAN, HUMENANSKY & ASSOCIATES 1015 DONNA ROAD ORWIGSBURG, PA. 17961 717-366-1654	HICKORY COAL CO. MINE-VENTILATION MAP MSHA ID NO. 36-07783 RD 1, BOX 479 PINE GROVE, PA. 17963
	REVISIONS	
		SURVEY REF. 1-10, 1-60, DRAWING NO. 014-01

204