
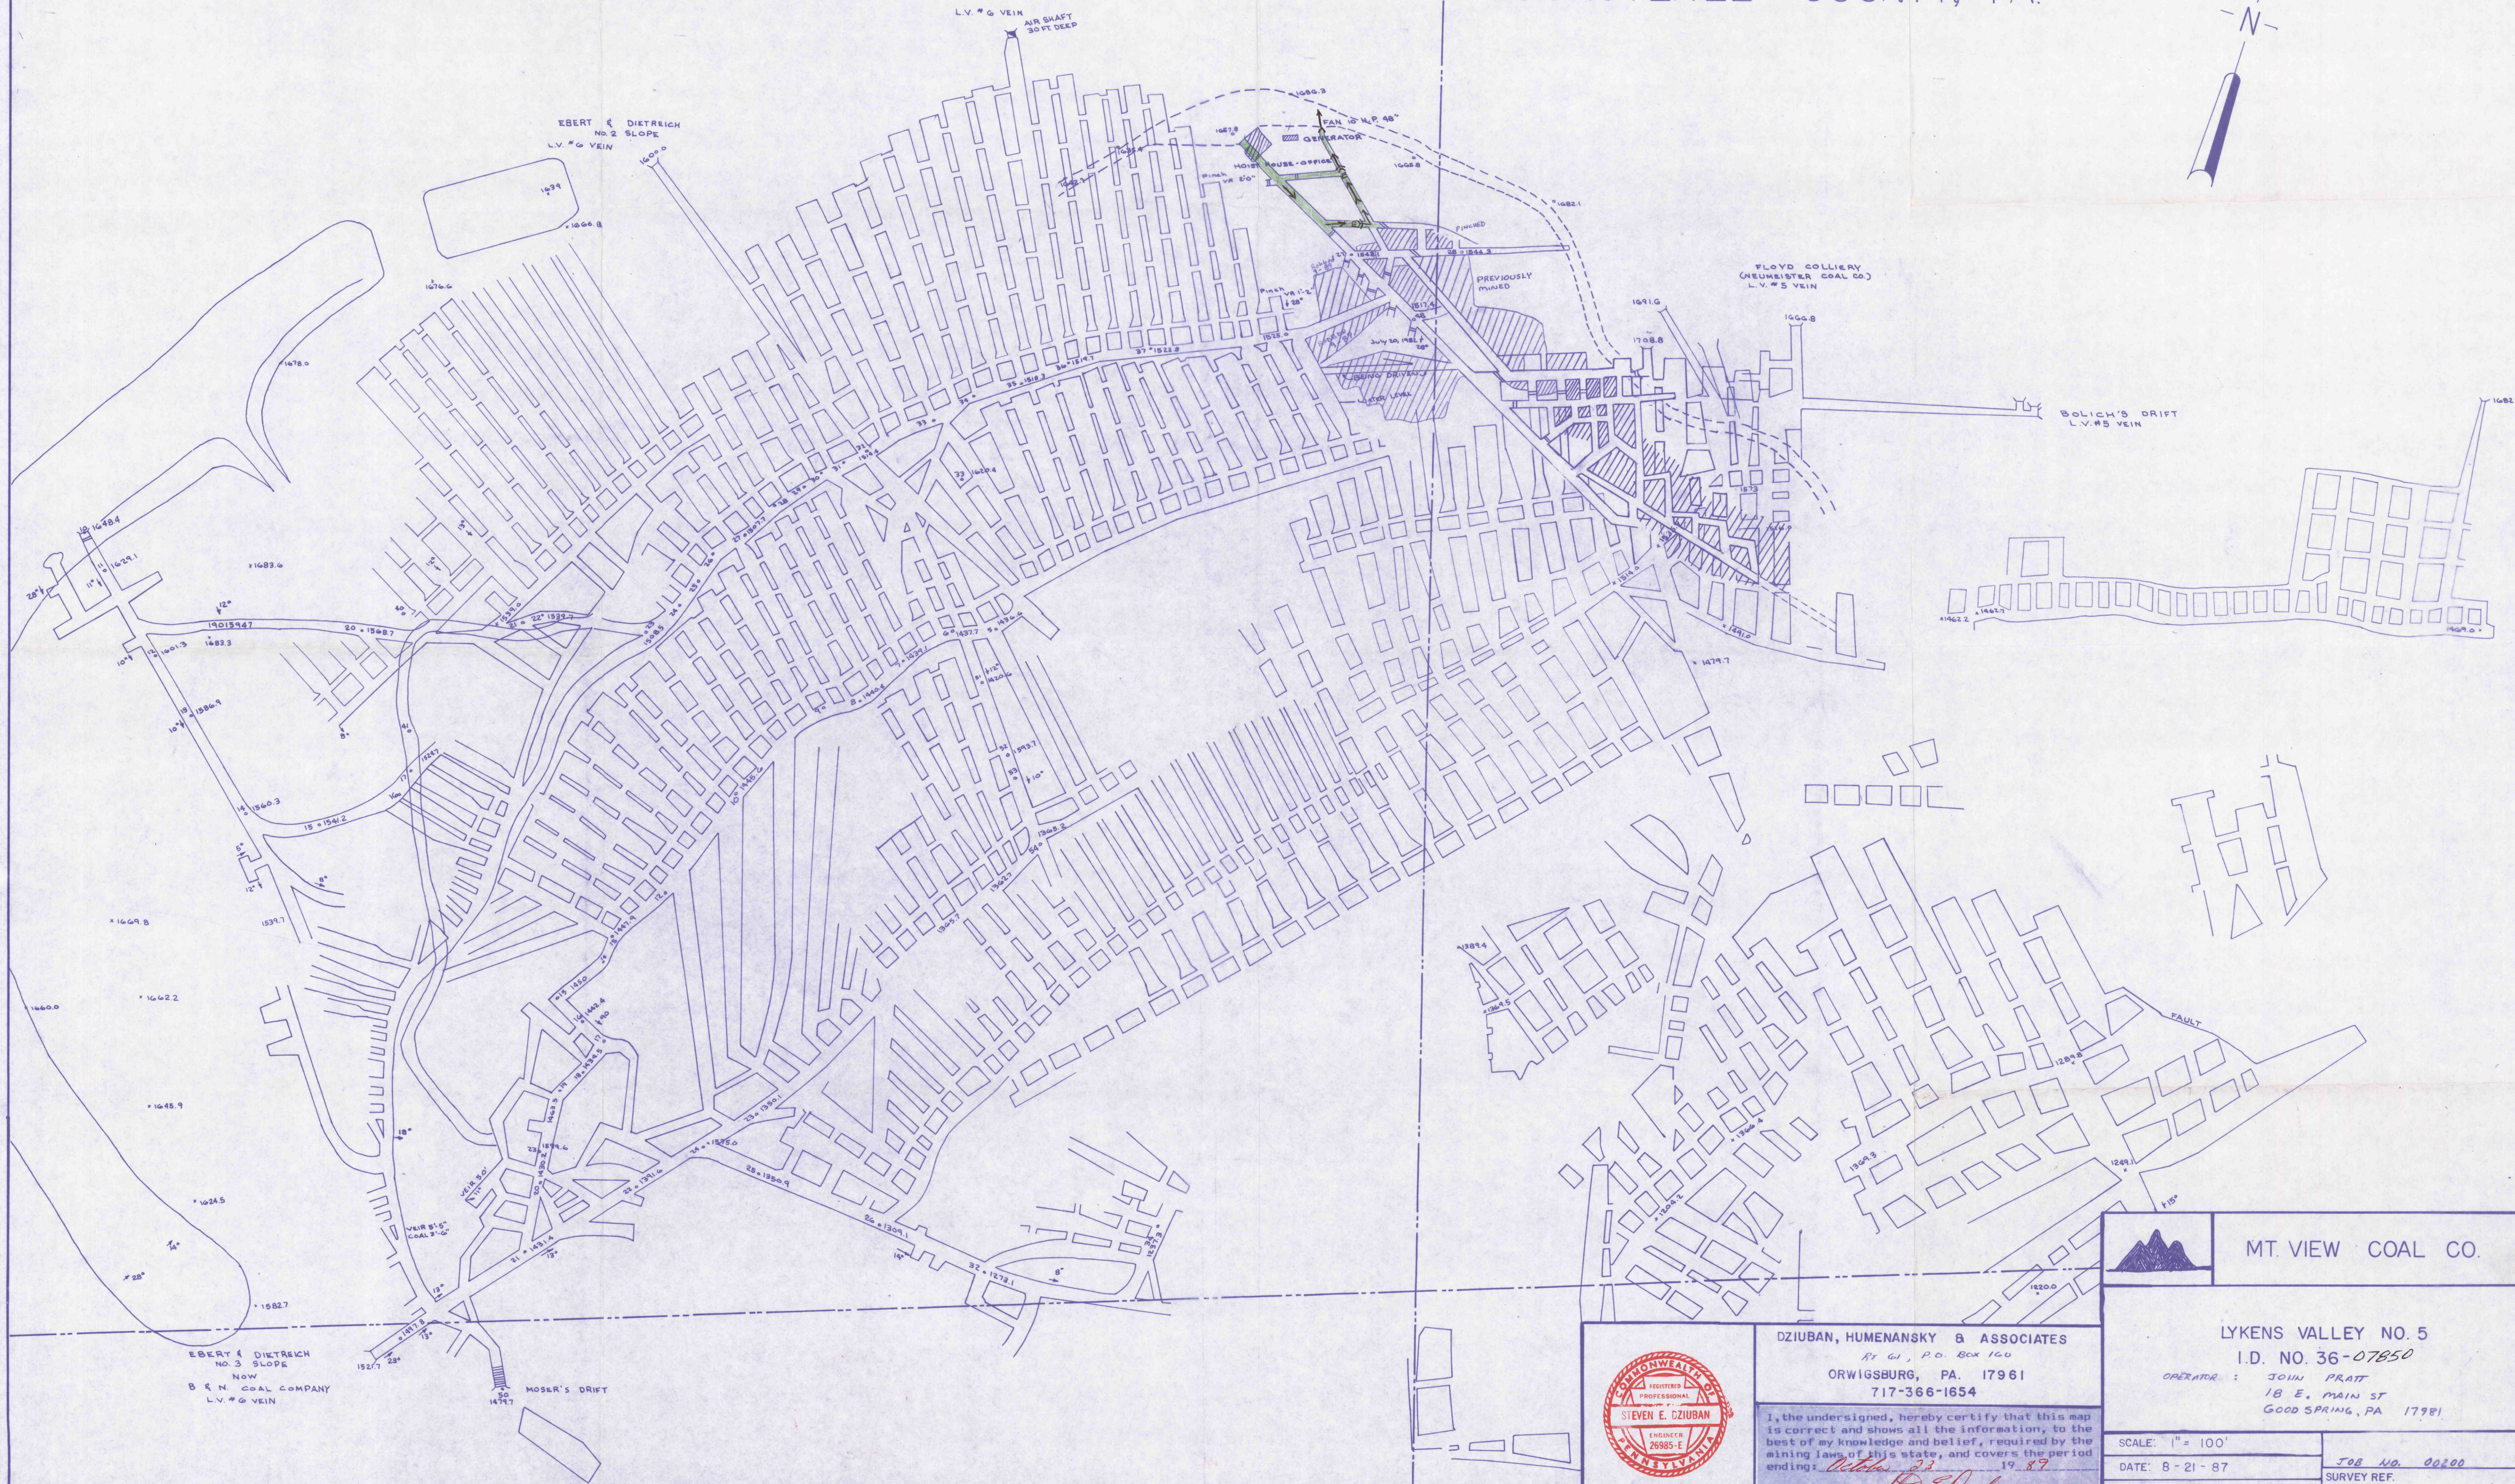


LEGEND

INTAKE AIR	→	RETURN AIR	→
ESCAPEWAY	⊙	ACTIVE WKGS	—
SLOPE-DRIFT	≡	PROPOSED	- - -
TEMP. STOP	⊥	PERM. STOP	⊥
VENT. TUBE	—	UNDERGROUND	—
LEASE LINE	—	PROP. LINE	—
SURF. TRAV. PT.	△		

BARRY TOWNSHIP

SCHUYLKILL COUNTY, PA.

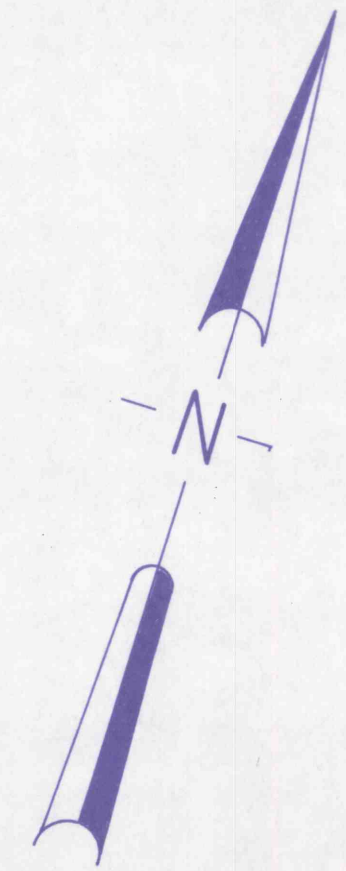

 MT. VIEW COAL CO.	
LYKENS VALLEY NO. 5 I.D. NO. 36-07850 OPERATOR: JOHN PRATT 18 E. MAIN ST GOOD SPRING, PA 17981	
SCALE: 1" = 100' DATE: 8-21-87 DRAWN BY: K.E.O.	JOB NO. 00200 SURVEY REF. PREV. 00029

	DZIUBAN, HUMENANSKY & ASSOCIATES BY GI, P.O. BOX 100 ORWIGSBURG, PA. 17961 717-366-1654 I, the undersigned, hereby certify that this map is correct and shows all the information, to the best of my knowledge and belief, required by the mining laws of this state, and covers the period ending: <u>October 23, 1987</u> Signed: <u>Steven E. Dziuban</u>
---	--