
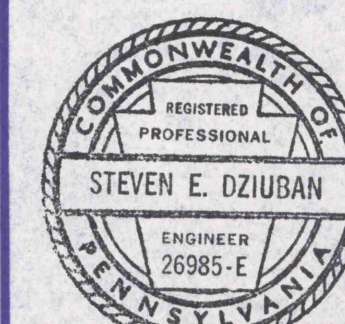
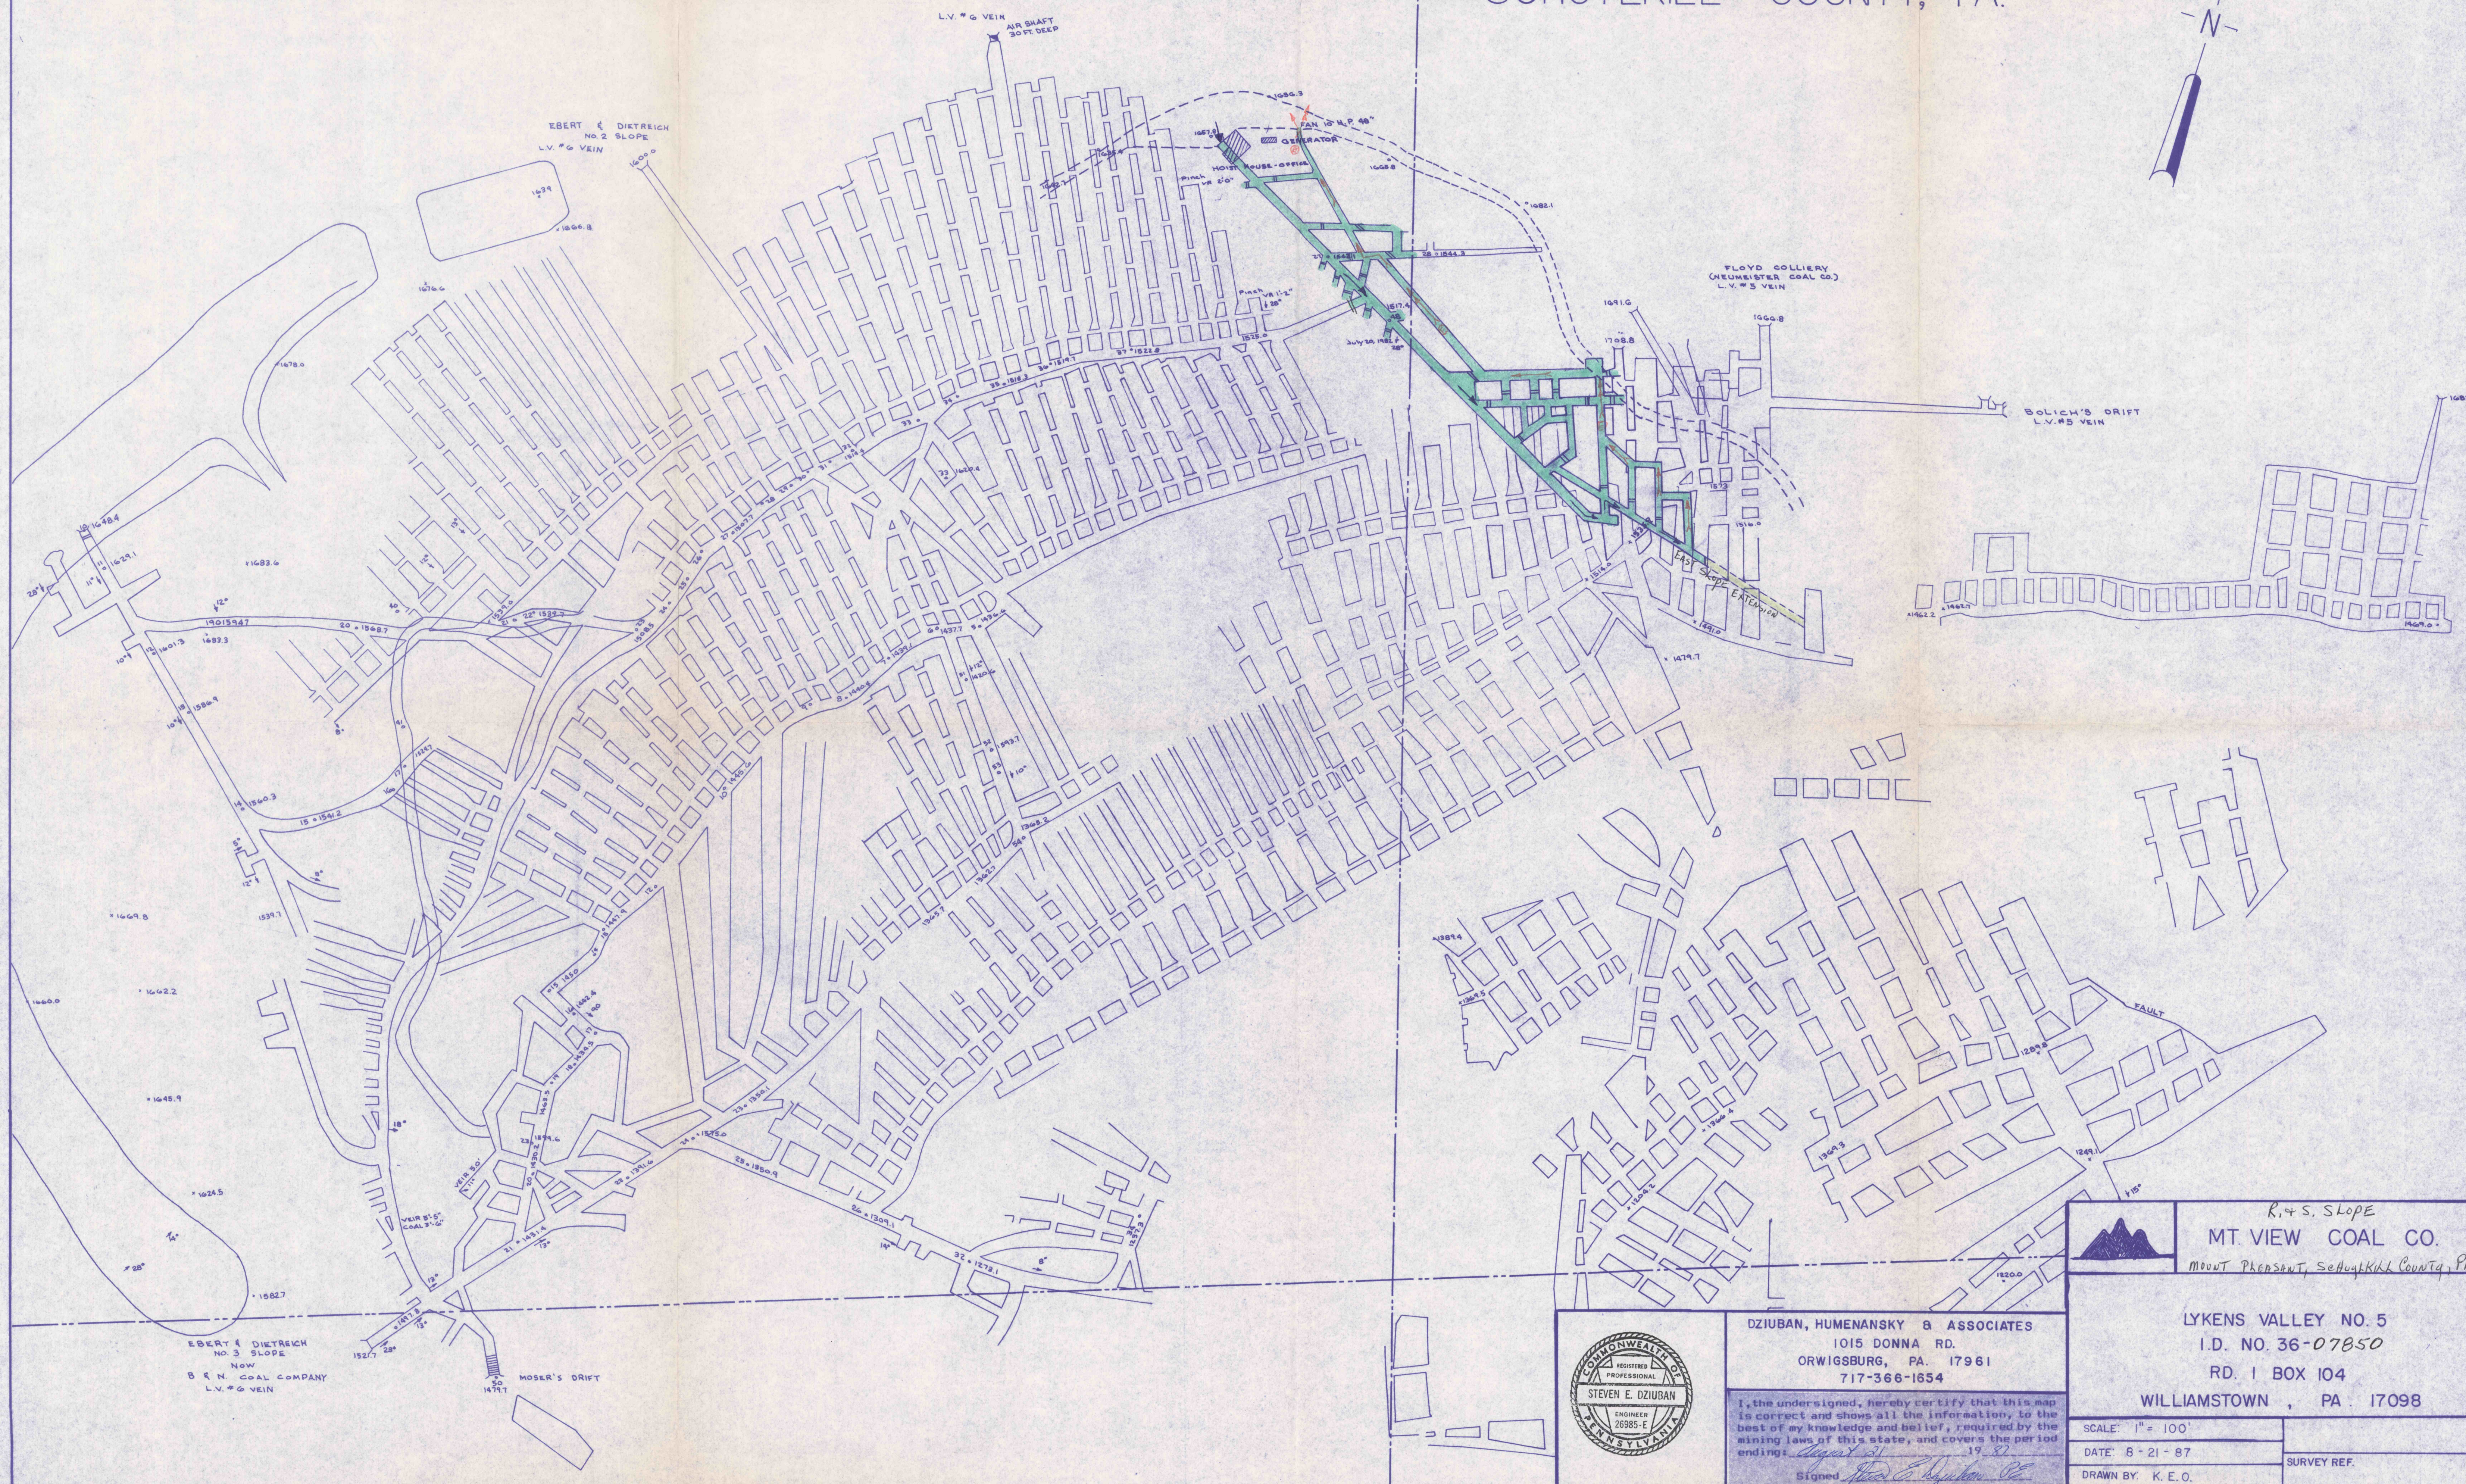


**LEGEND**

INTAKE AIR →  
 ESCAPEWAY →  
 SLOPE-DRAFT →  
 TEMP. STOP →  
 VENT. TUBE →  
 LEASE LINE ---  
 SURF. TRAV. PT. Δ


RETURN AIR →  
 ACTIVE WKBS. ---  
 PROPOSED ---  
 PERM. STOP II ---  
 UNDERGROUND PT. ---  
 PROP. LINE ---

# BARRY TOWNSHIP SCHUYLKILL COUNTY, PA.

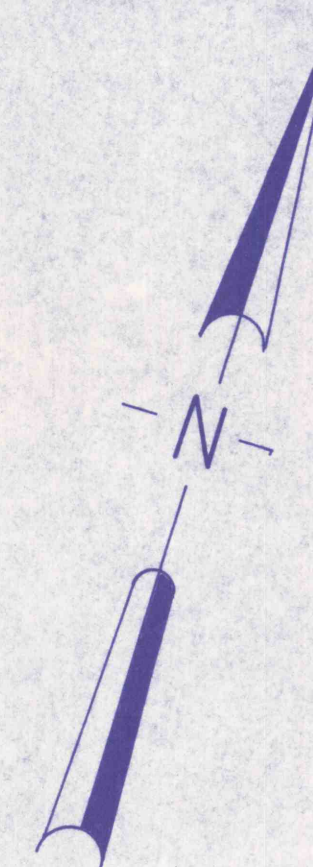

DZIUBAN, HUMENANSKY & ASSOCIATES  
 1015 DONNA RD.  
 ORWIGSBURG, PA. 17961  
 717-366-1654

I, the undersigned, hereby certify that this map is correct and shows all the information to the best of my knowledge and belief, required by the mining laws of this state, and covers the period ending: 19 87  
 Signed: *Steven E. Dziuban*
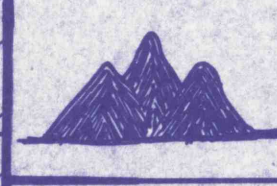
|   |                         |
|---|-------------------------|
| <p>LYKENS VALLEY NO. 5<br/>         I.D. NO. 36-07850<br/>         RD. 1 BOX 104<br/>         WILLIAMSTOWN, PA 17098</p>                                                      |                         |
| <p>SCALE: 1" = 100'</p>   | <p>SURVEY REF.</p>      |
| <p>DATE: 8-21-87</p>   | <p>DRAWN BY: K.E.O.</p> |