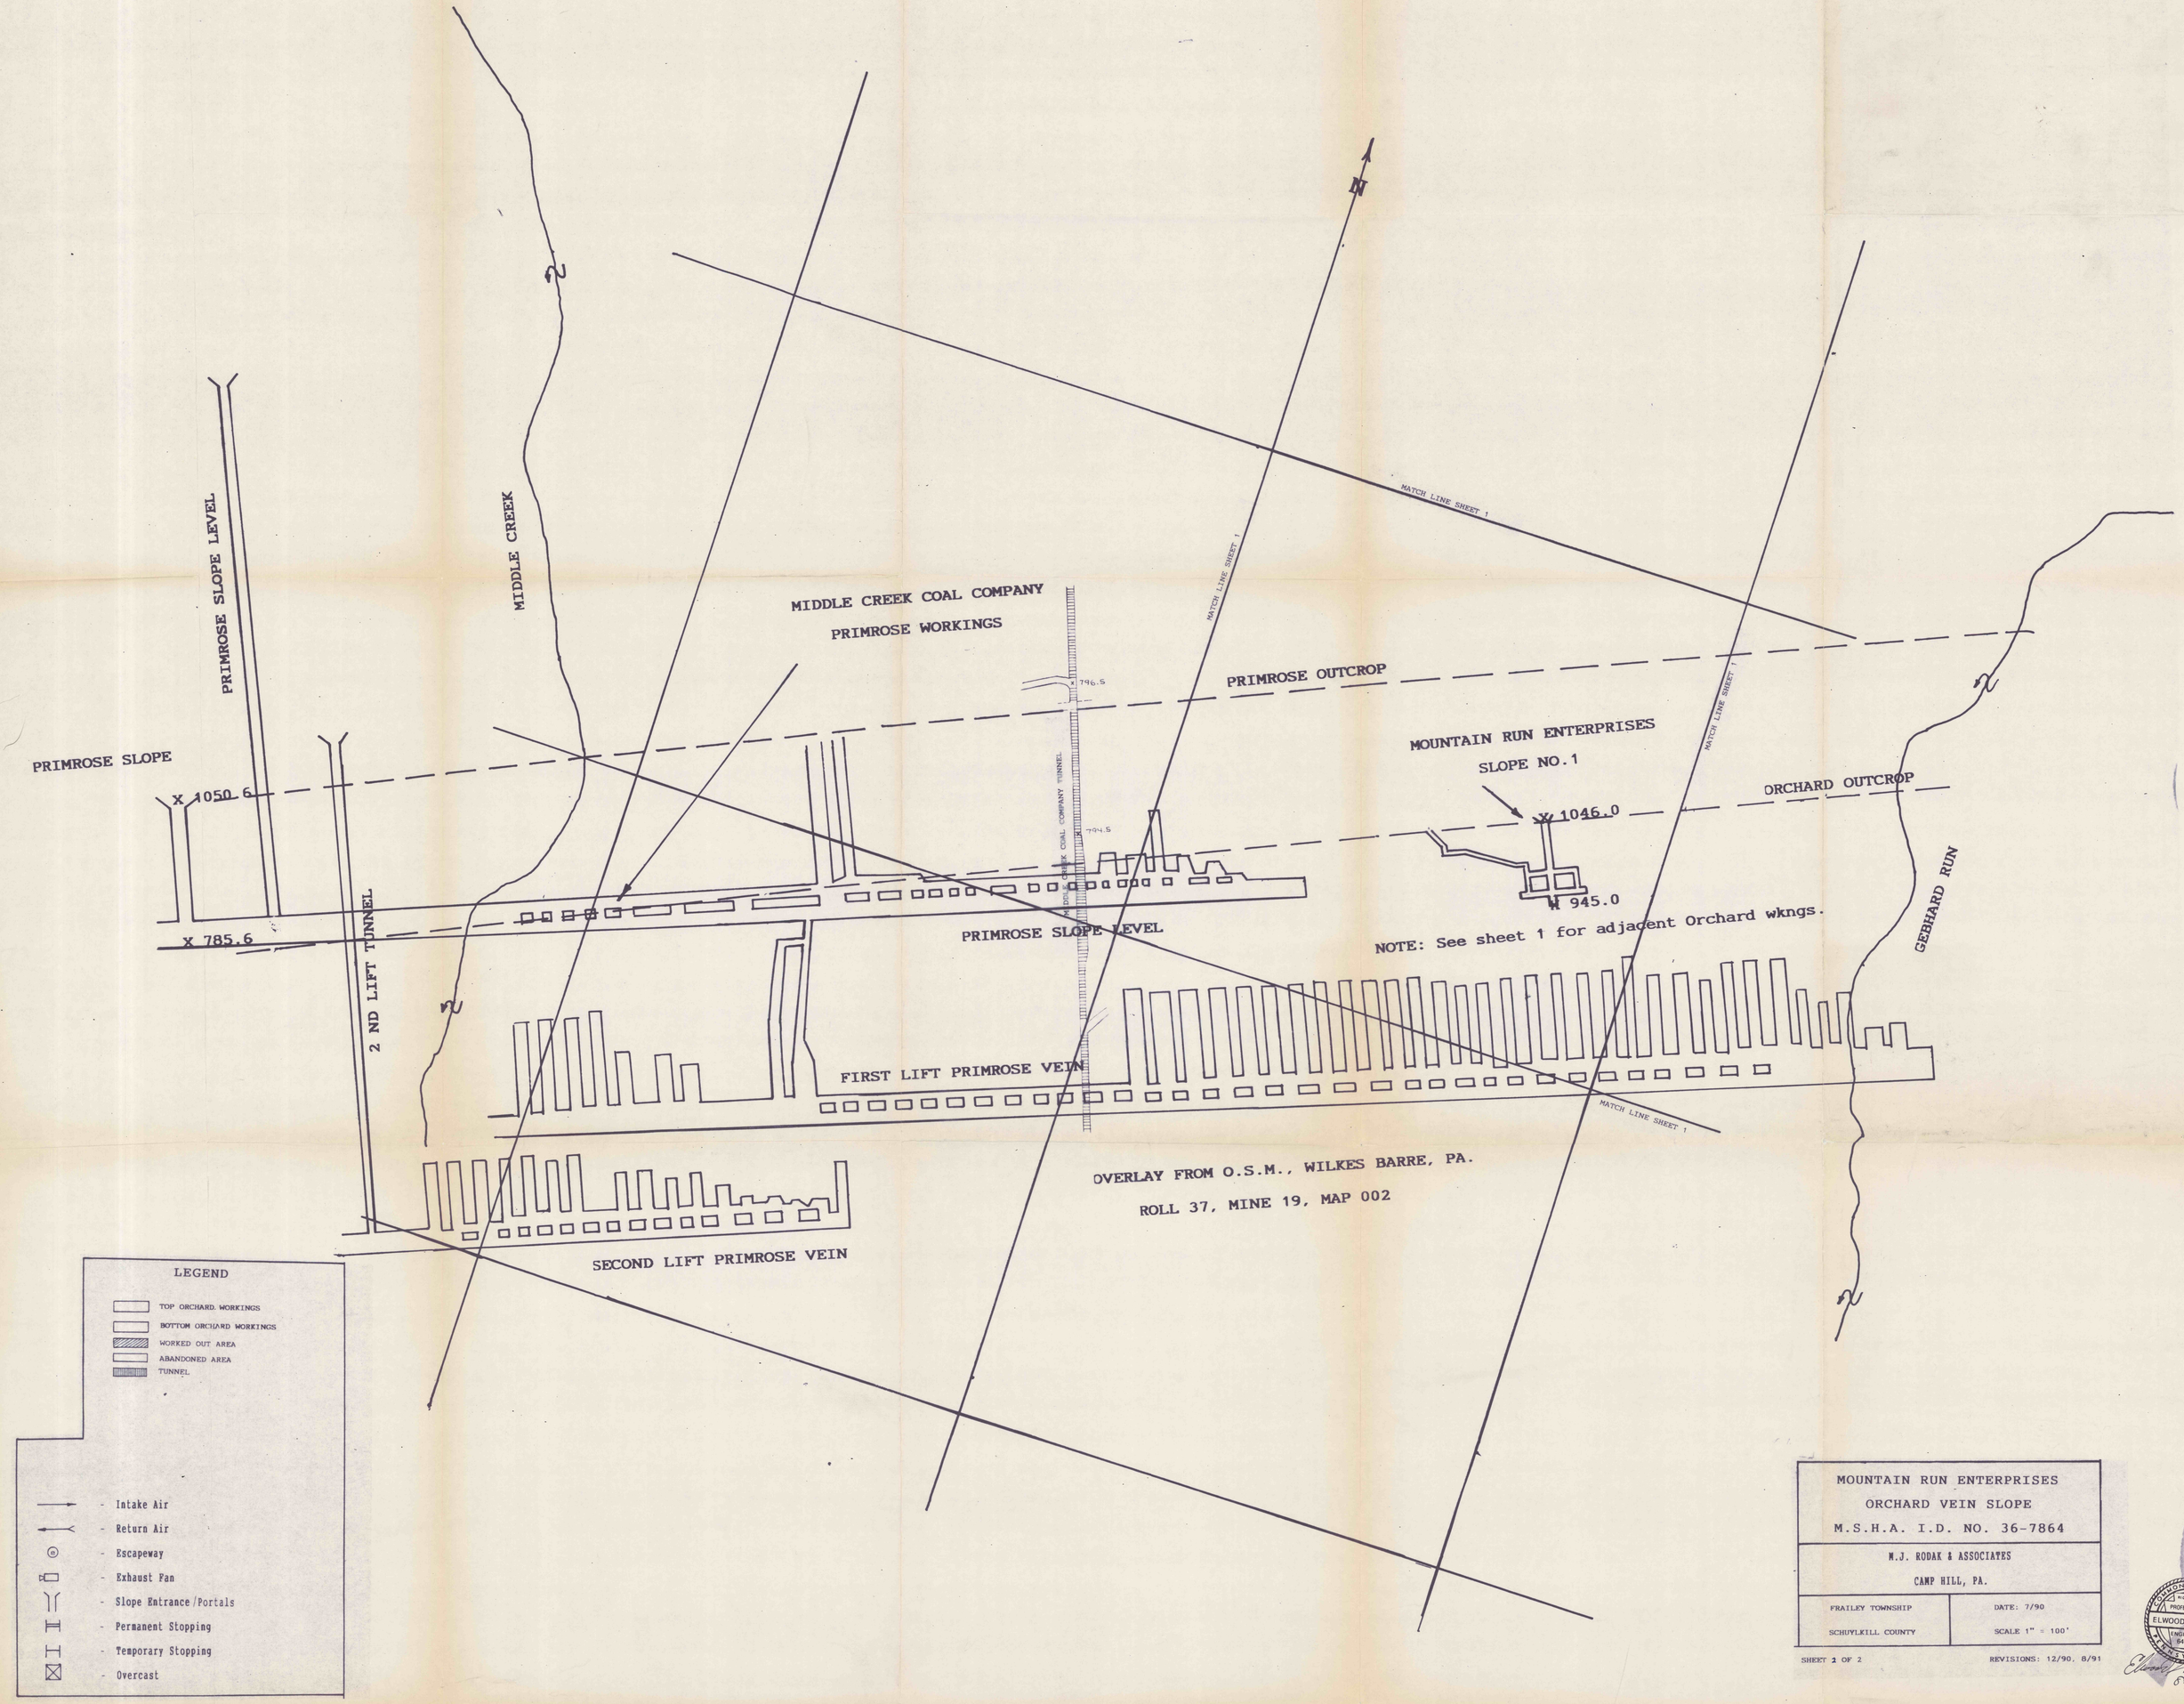
PRIMROSE SLOPE LEVEL
MIDDLE CREEK
MIDDLE CREEK COAL COMPANY
PRIMROSE WORKINGS
MATCH LINE SHEET 1
MATCH LINE SHEET 1
MATCH LINE SHEET 1
PRIMROSE OUTCROP
PRIMROSE SLOPE
X 1050.6
MOUNTAIN RUN ENTERPRISES
SLOPE NO.1
X 1046.0
ORCHARD OUTCROP
X 945.0
X 785.6
PRIMROSE SLOPE LEVEL
NOTE: See sheet 1 for adjacent Orchard wkngs.
GEBHARD RUN
2 ND LIFT TUNNEL
FIRST LIFT PRIMROSE VEIN
MATCH LINE SHEET 1
OVERLAY FROM O.S.M., WILKES BARRE, PA.
ROLL 37, MINE 19, MAP 002
SECOND LIFT PRIMROSE VEIN
LEGEND
TOP ORCHARD WORKINGS
BOTTOM ORCHARD WORKINGS
WORKED OUT AREA
ABANDONED AREA
TUNNEL
- Intake Air
- Return Air
- Escapeway
- Exhaust Fan
- Slope Entrance/Portals
- Permanent Stopping
- Temporary Stopping
- Overcast
MOUNTAIN RUN ENTERPRISES
ORCHARD VEIN SLOPE
M.S.H.A. I.D. NO. 36-7864
M.J. RODAK & ASSOCIATES
CAMP HILL, PA.
FRAILEY TOWNSHIP
SCHUYLKILL COUNTY
DATE: 7/90
SCALE 1" = 100'
SHEET 2 OF 2
REVISIONS: 12/90, 8/91
COMMONWEALTH OF PENNSYLVANIA
REGISTERED PROFESSIONAL
ELWOOD F. WIRTH
ENGINEER
642-K
8-22-91