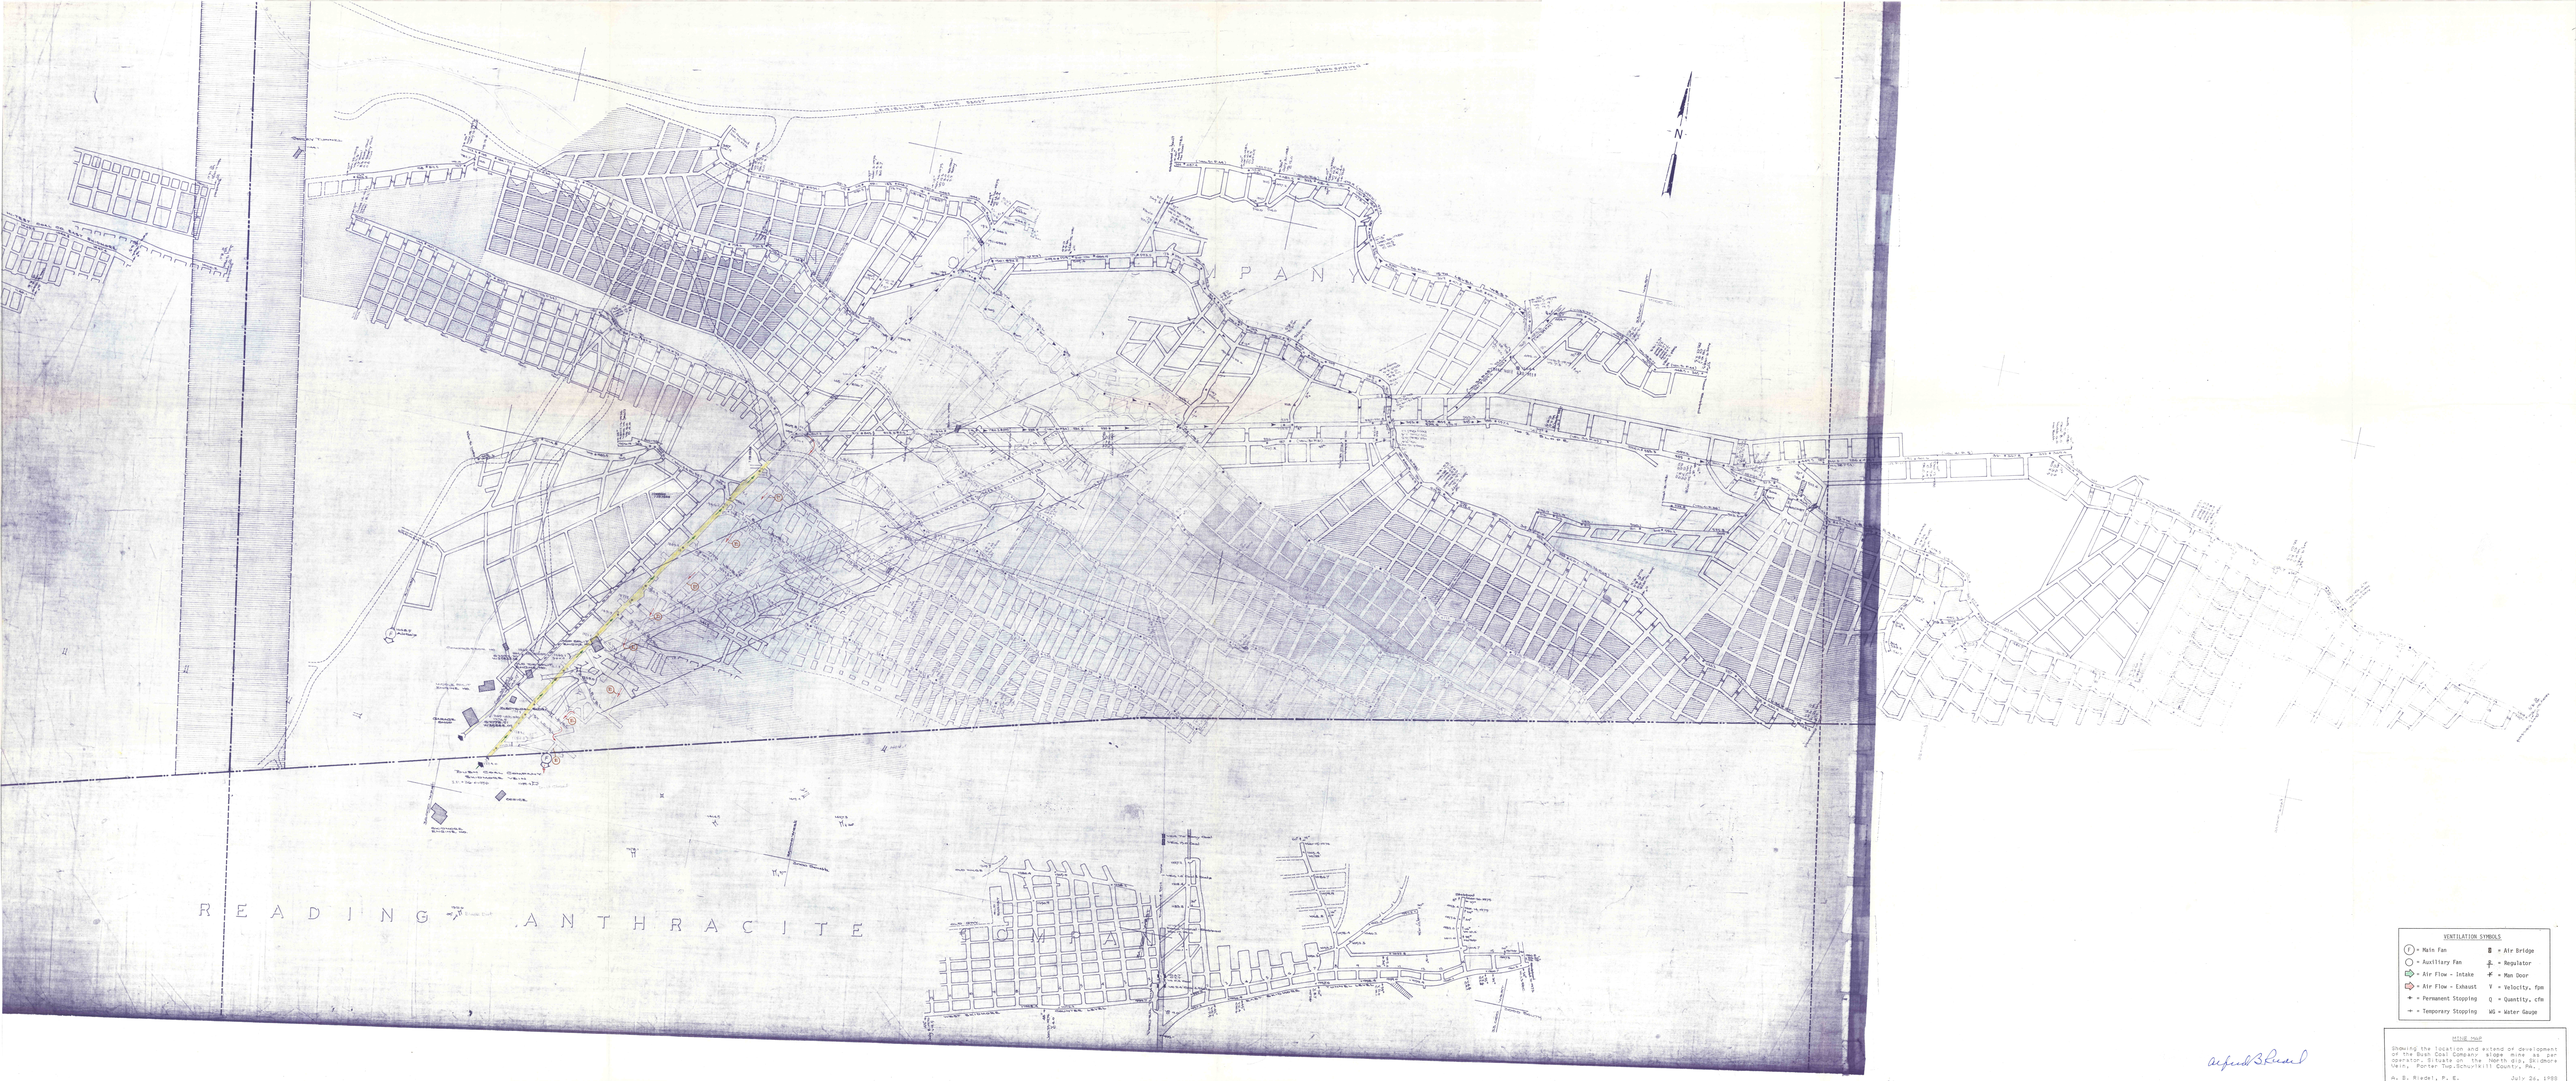


VENTILATION SYMBOLS

(F) = Main Fan	= Air Bridge
= Auxiliary Fan	= Regulator
= Air Flow - Intake	= Man Door
= Air Flow - Exhaust	V = Velocity, fpm
= Permanent Stopping	Q = Quantity, cfm
= Temporary Stopping	WG = Water Gauge


Showing the location and extend of development of the Bush Coal Company slope mine as per operator. Situate on the North dip, Skidmore Vein, Porter Twp.Schuylkill County, Pa.

A. B. Riedel, P. E.

July 26, 1950
Scale 1" = 100'